

THREE CABLE GUARD RAIL W/ LIGHT STEEL POSTS
ITEM 553
Ramp D: 0+00 - 10+00 Rt. 4
3428+00 NB D: - 3441+75 NB D:
3428+00 SB D: - 3430+85 SB D:
3437+80 SB Lt: - 3444+64 SB Lt:
0+00 Ramp D: 10+00 Rt.
BITUMINOUS CONCRETE CURB ITEM 555 Type II
0+00 Ramp D: 10+00 Ramp D: D:
0+00 Ramp D: 10+00 Ramp D: D:

STONE FILL for SLOPE PROTECTION
ITEM 512
3428+00 - 3432+70 NB D:
3432+80 - 3433+00 NB D:

PROPERTY LINE FENCE W/ STEEL
POSTS MOD. ITEM 583 II
SB 3428+00 - 3444+00 Lt.
NB 3428+00 - 3444+00 Rt.
* TREATED TIMBER CURB ITEM 550
Ramp D: 0+00 - 10+00 Rt.

INDIVIDUAL WATER SOURCES
CONE COLLECT. CISTERN N.B. 3430+ 300' RT
DUG SPRING N.B. 3432+ 1000' RT
FARM TOWER N.B. 3432+ 500' RT
DUG SPRING N.B. 3433+ 2500' RT
DUG SPRING N.B. 3433+ 2400' RT
DUG SPRING N.B. 3433+ 2600' RT

NOTE: * DENSELY TREED TO BE REMOVED IN
SPACE FOR CONSTRUCTION

* Construct U Turn
3443+85


CONTROL OF ACCESS IS COMPLETE ON THIS SHEET

BITUMINOUS CONCRETE SURFACE for
GUTTERS and TRAFFIC ISLANDS Item 554 Mod.
3442+70 - 3442+80 (Median)

* JUTE MATTING - ITEM 623
Ramp D: 4+75 - 8+75 Median

Curve Data
Δ 19° 45' 30" Lt.
D 1° 00' 00"
R 5729.58
T 997.86
L 1975.84
E 86.24

END PROJECT 1893
3444+00

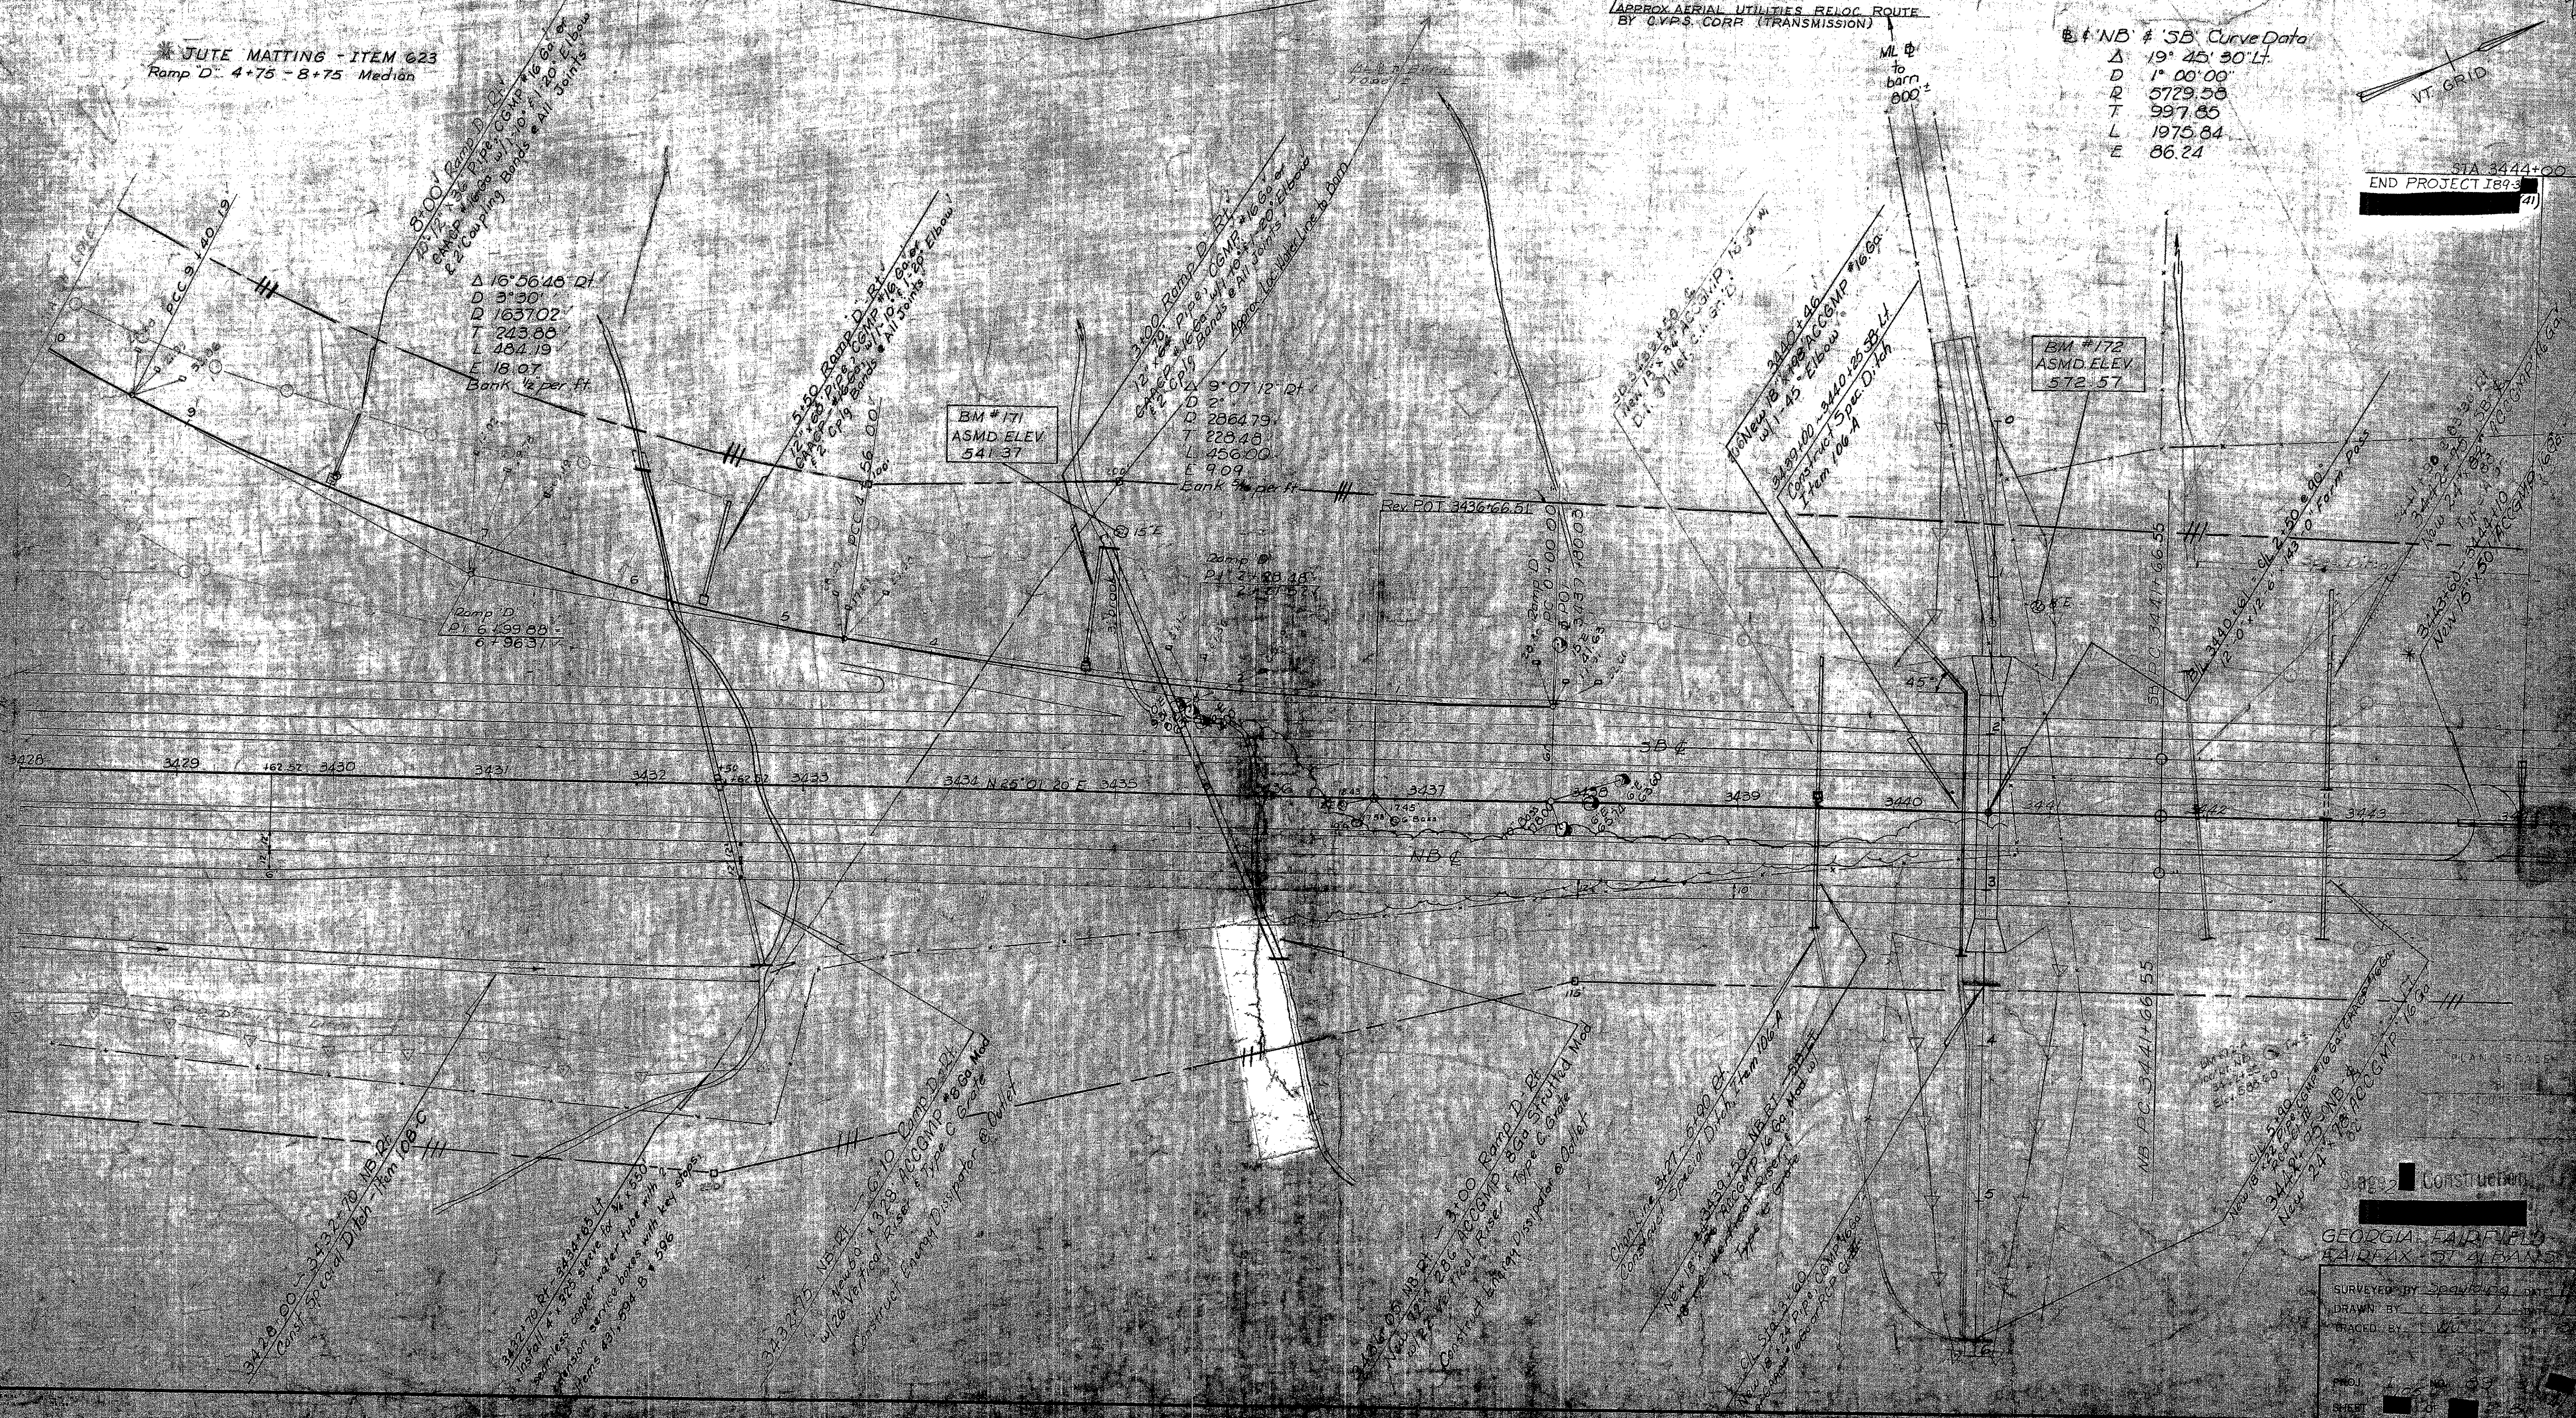

SURVEYED BY: [Signature]
DRAWN BY: [Signature]
CHECKED BY: [Signature]
DATE: [Date]

STA. 3428 = MM113.81