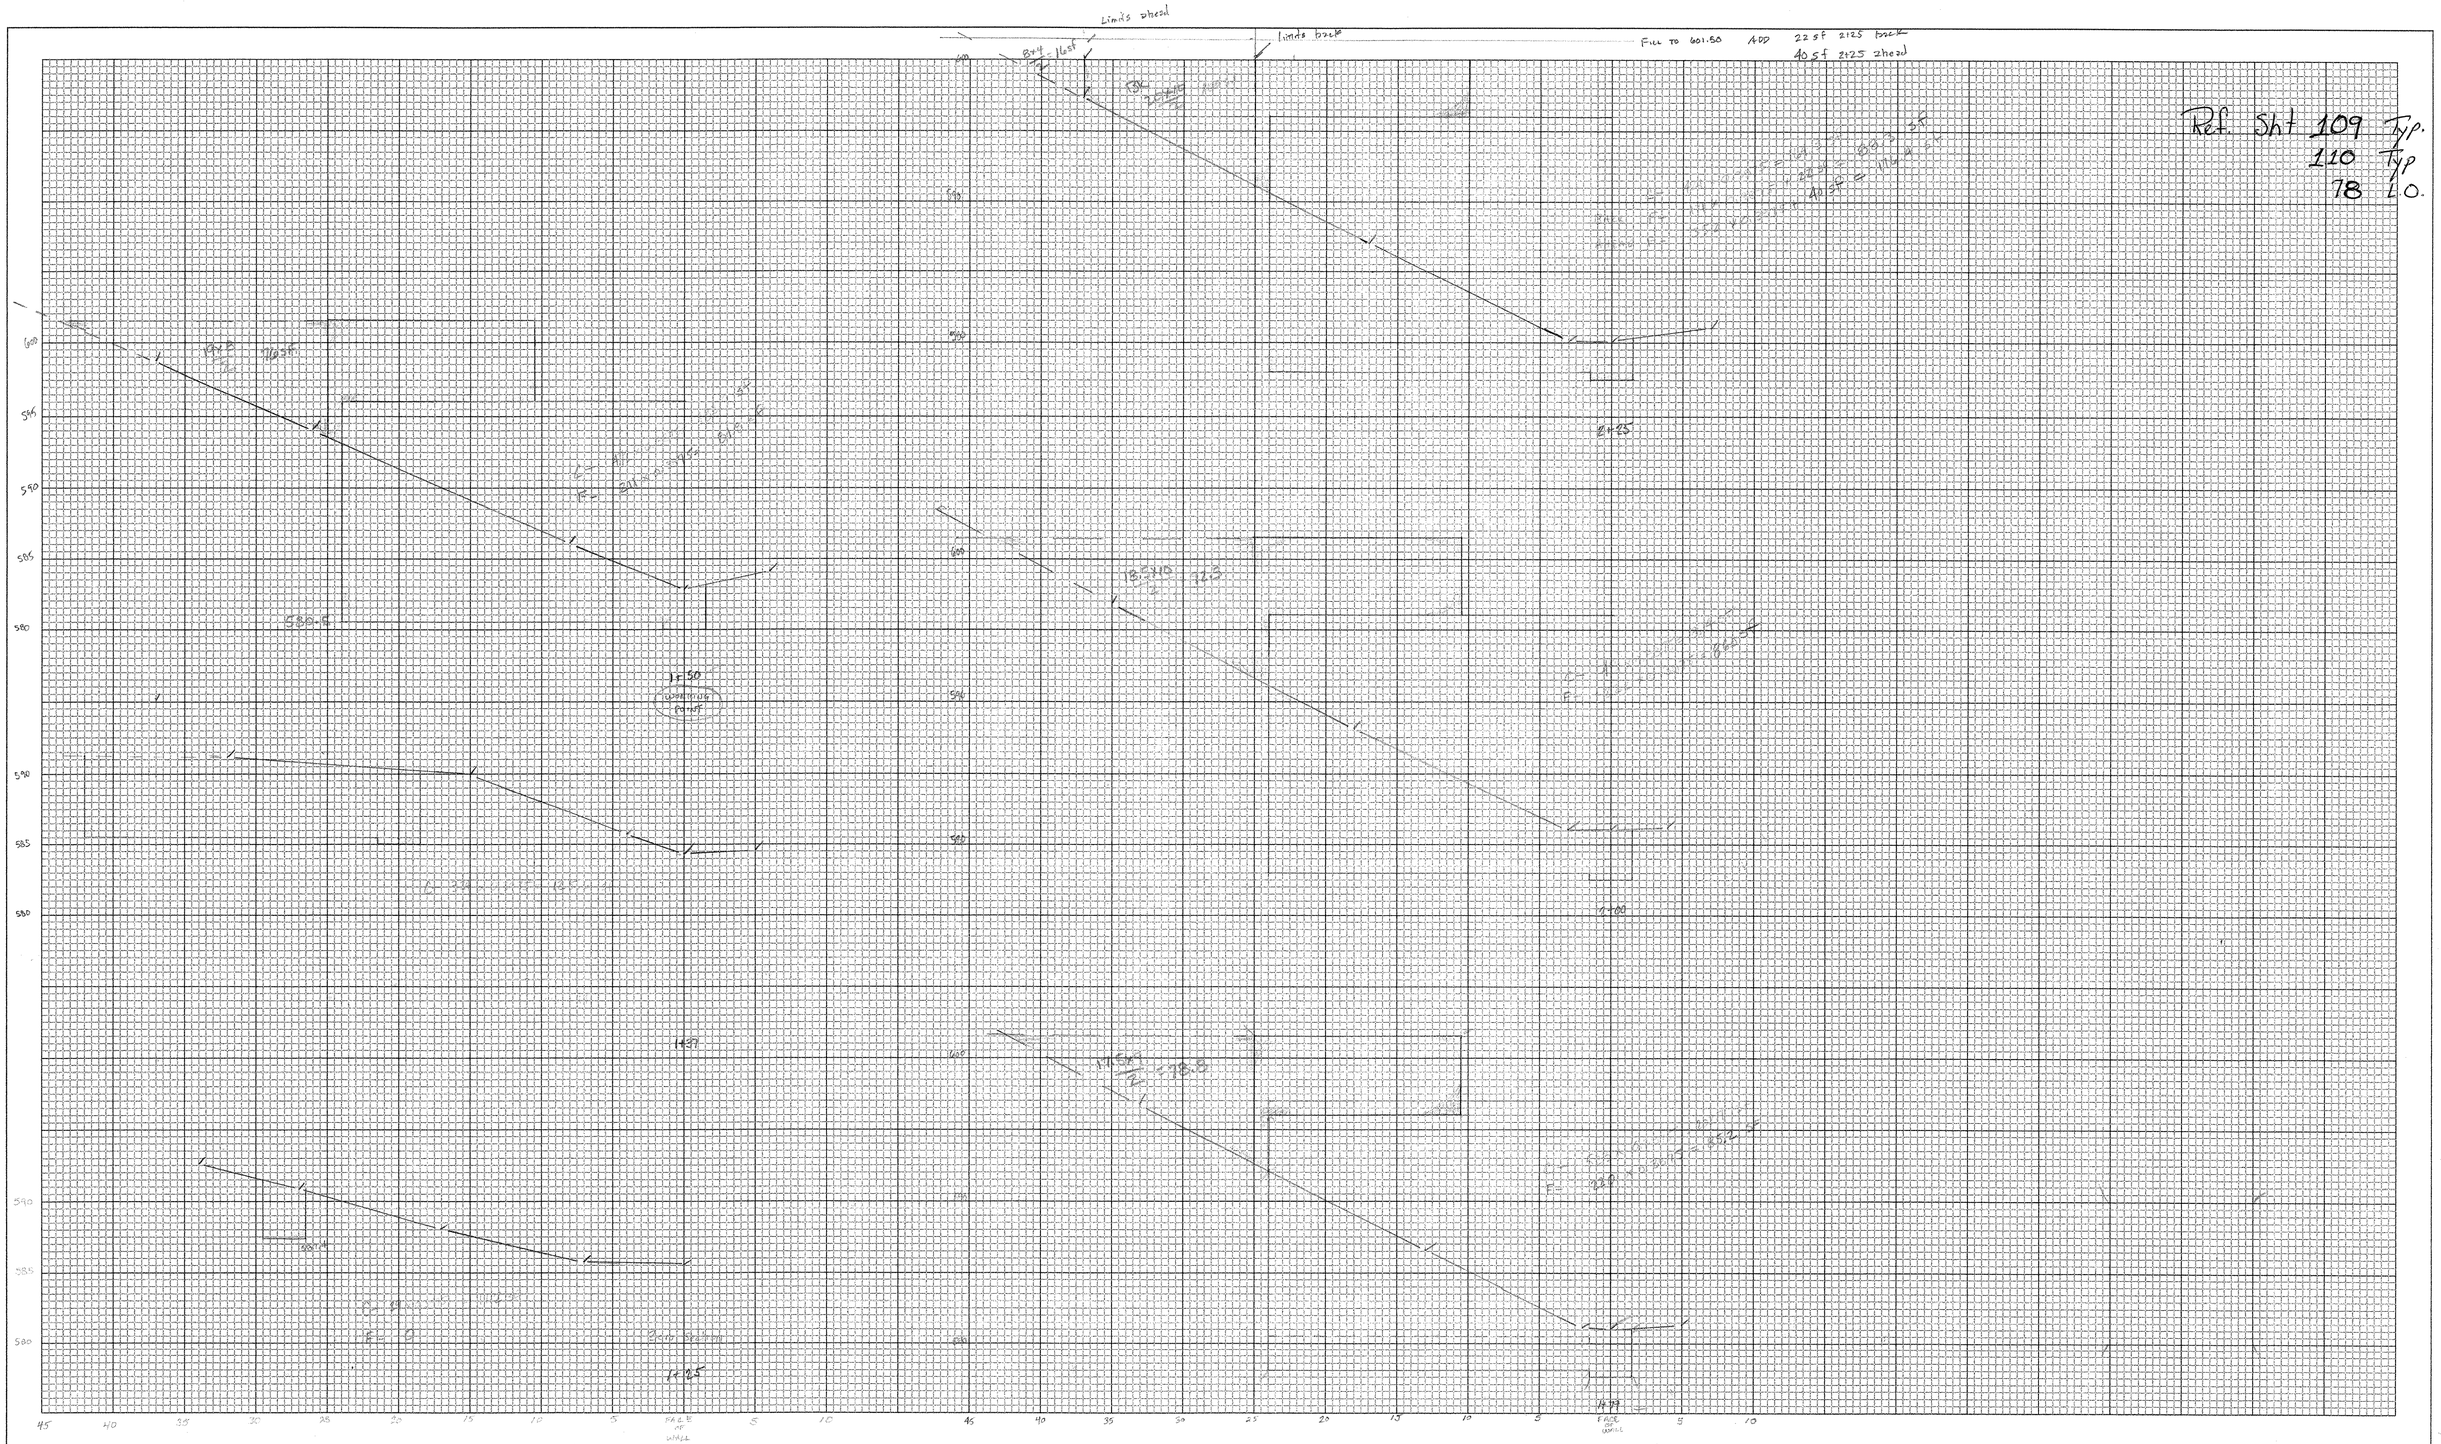


# CROSS SECTION SHEET

1" = 5'

PROJECT NAME: FAIRFAX - ST. ALBANS

PROJECT NUMBER: IM 089-3(27)

FILE NAME: S-PROJECTS ENGINEERING

PROJECT LEADER: JAMES WHITE

DESIGNED BY:

const: g:/common/cadd/e-xsection.dgn

PLOT DATE: 05-JUN-2000 09

DRAWN BY: WHITE

CHECKED BY:

SHEET 1 OF 2 388