FINAL SURVEY

ORIGINAL SURVEY

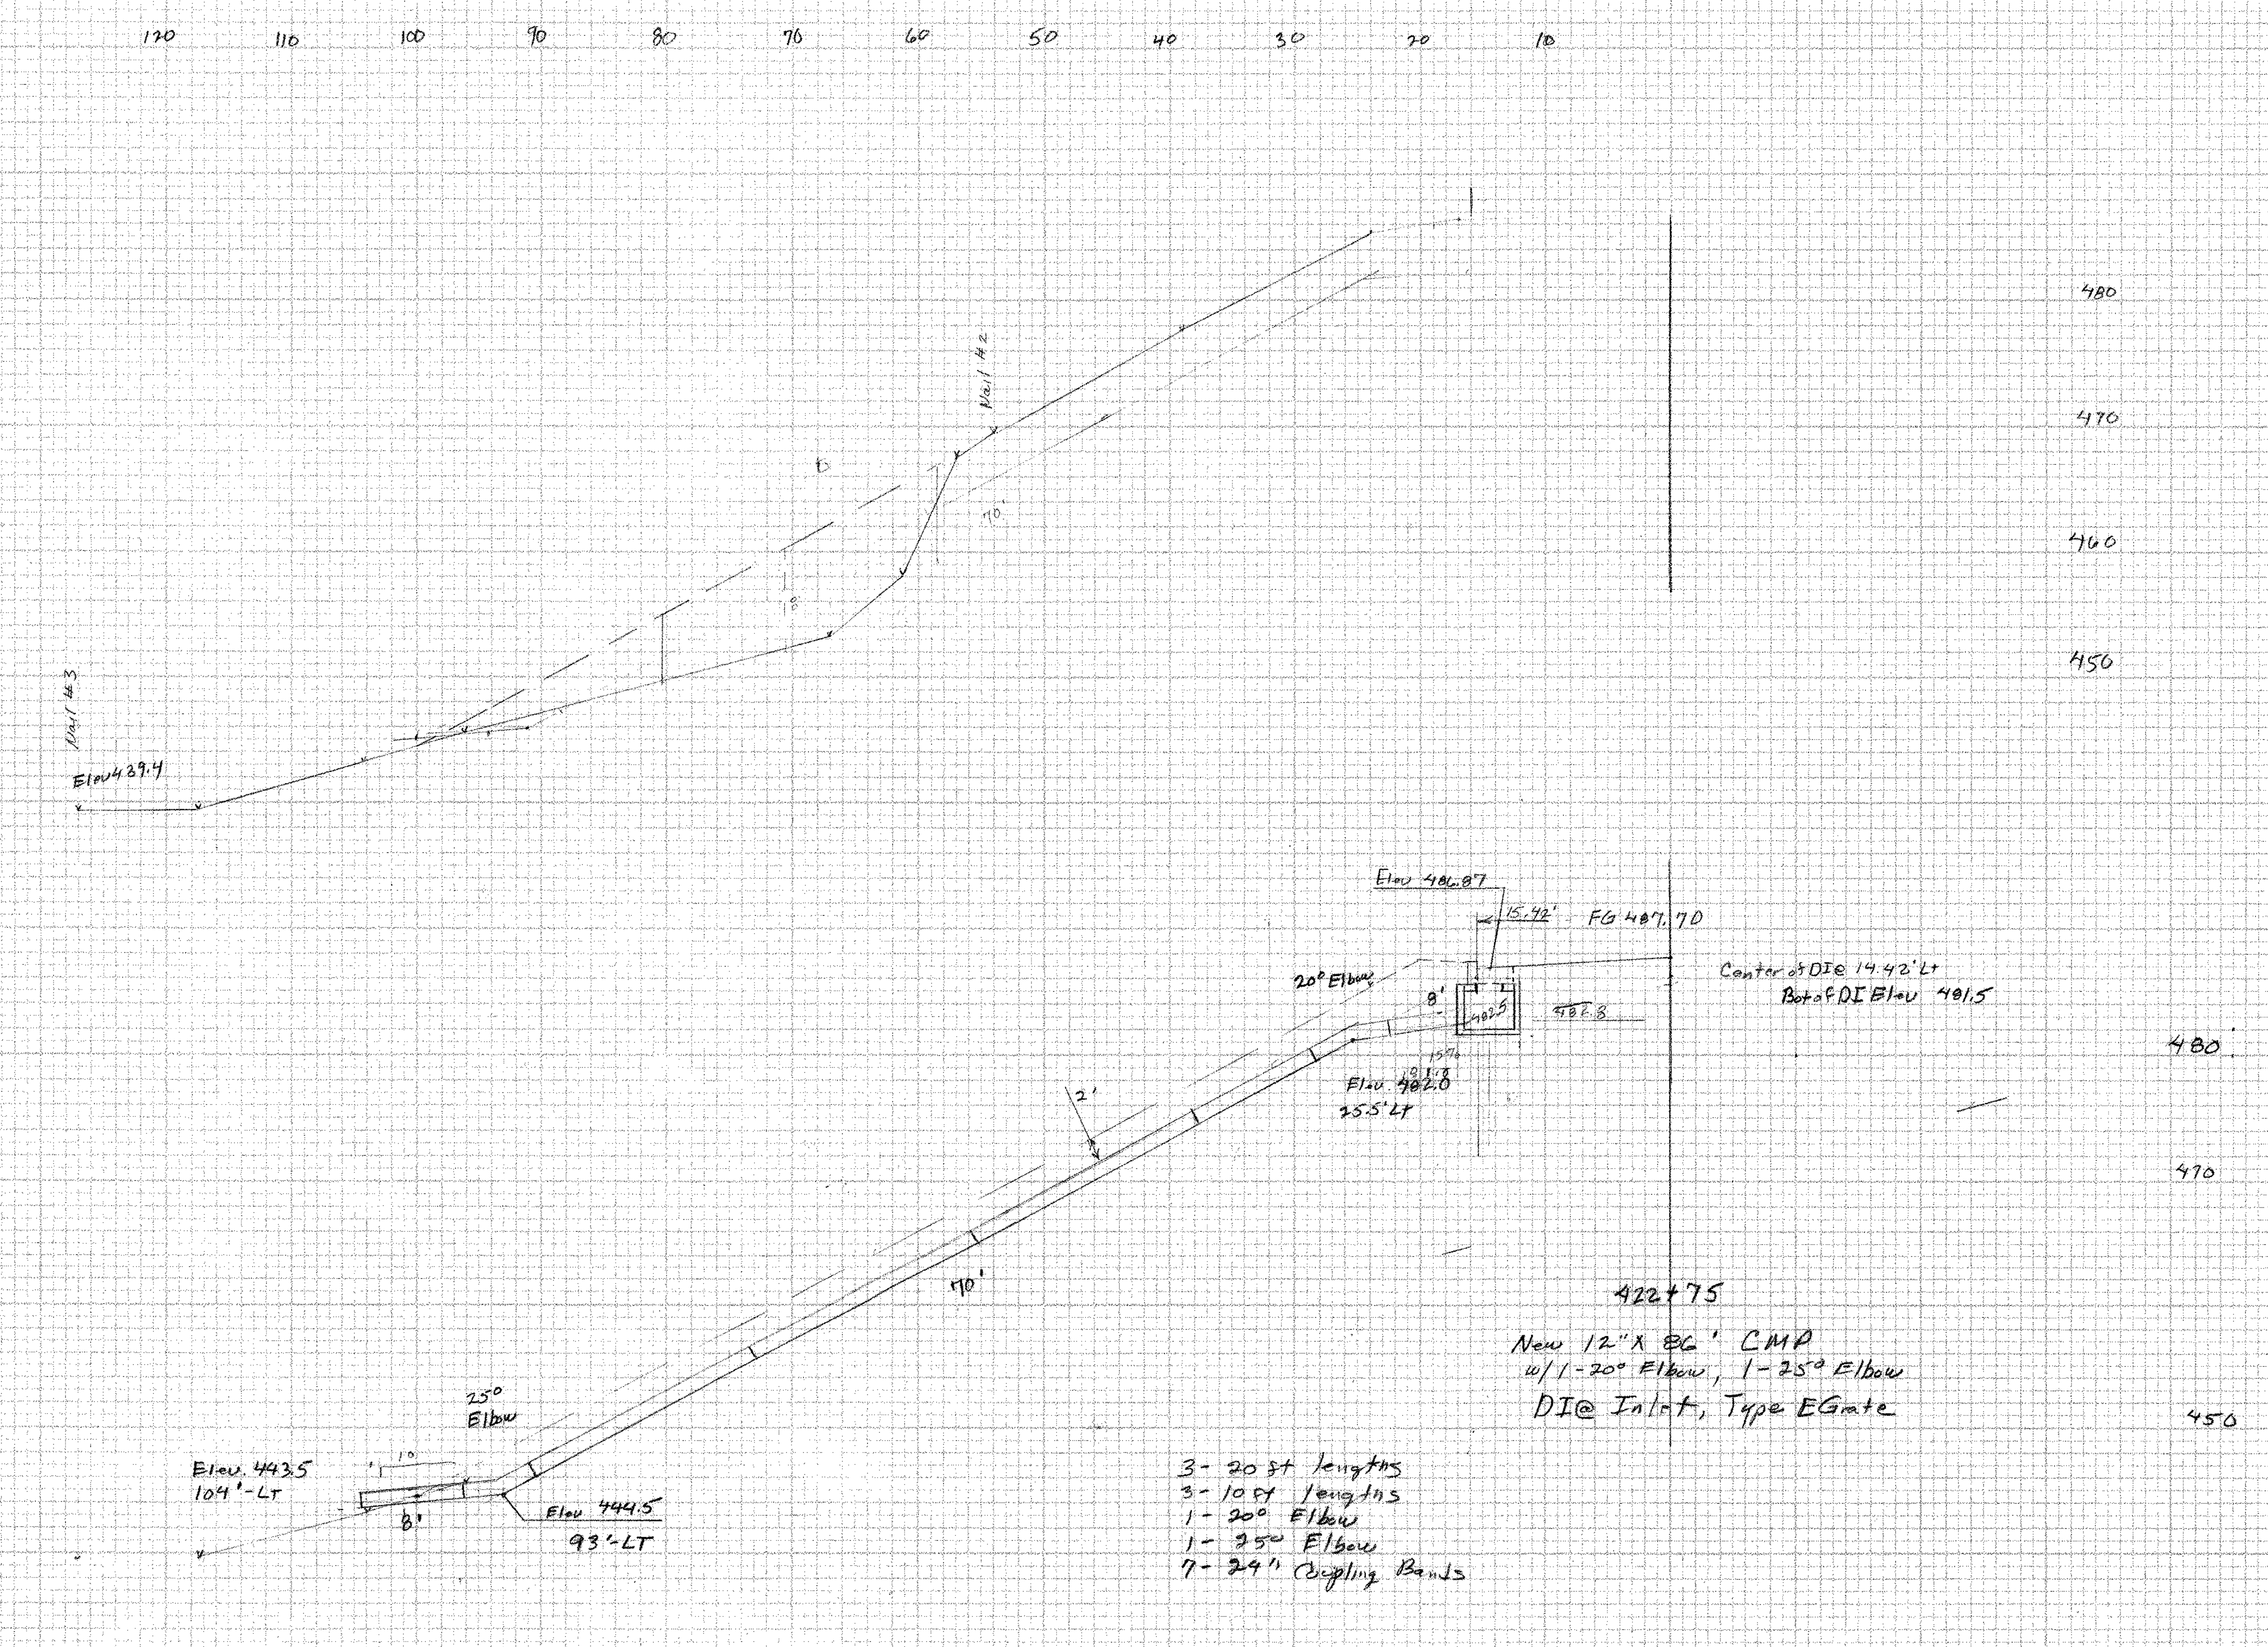

422+75

New 12" X 86' CMP
w/ 1-20° Elbow, 1-25° Elbow
DI@ Inlet, Type E Grate

3- 20 ft lengths
3- 10 ft lengths
1- 20° Elbow
1- 25° Elbow
7- 24" Coupling Bands

11/16