FED. ROAD DIST. NO.	STATE	F.E.D. AID PROJ. NO.	FISCAL YEAR	SHEET NO.	TOTAL SHEETS
8	VT.				

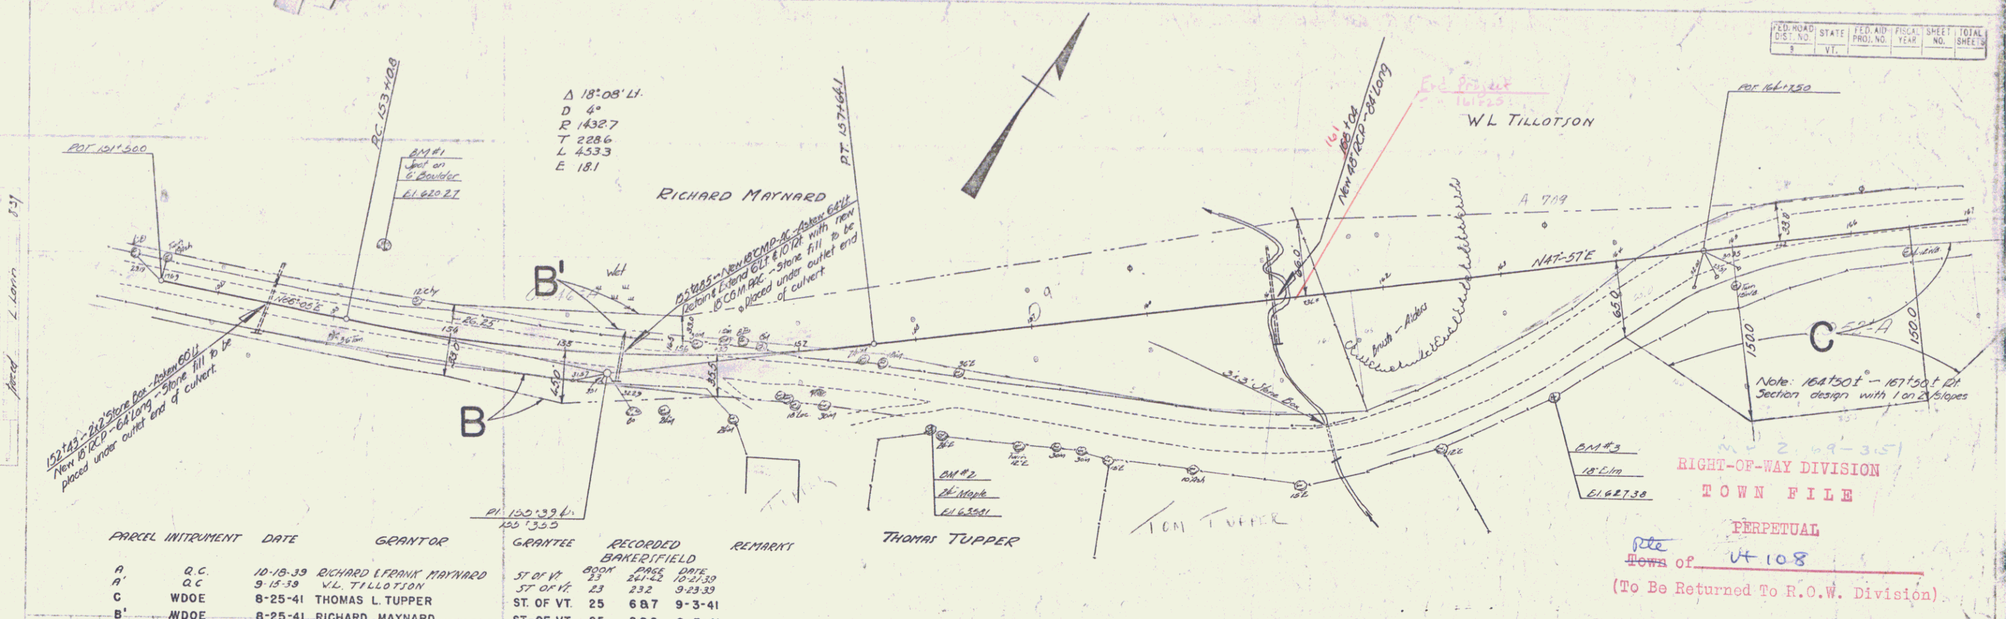

PARCEL	INSTRUMENT	DATE	GRANTOR	GRANTEE	RECORDED BAKERSFIELD BOOK	PAGE	DATE	REMARKS
A	Q.C.	10-18-39	RICHARD L. FRANK MAYNARD	ST. OF VT.	23	241-42	10-21-39	
A'	Q.C.	9-15-39	W.L. TILLOTSON	ST. OF VT.	23	232	9-23-39	
C	WDOE	8-25-41	THOMAS L. TUPPER	ST. OF VT.	25	687	9-3-41	
B'	WDOE	8-25-41	RICHARD MAYNARD	ST. OF VT.	25	689	9-3-41	

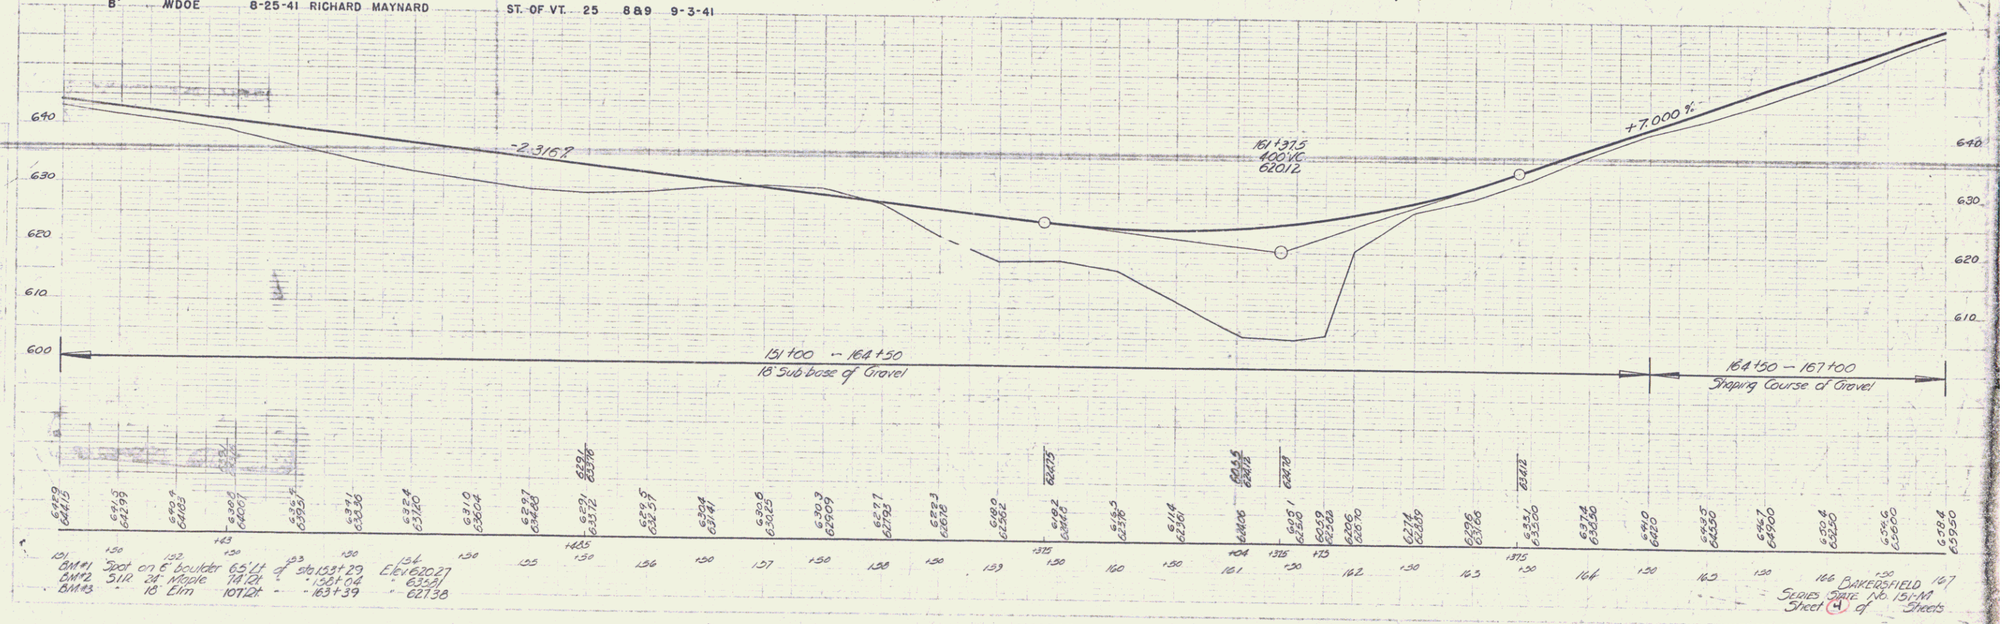

BM#1 Spot on 6" boulder 65' Lt. of Sta 153+29 Elev 620.27
BM#2 5" Lt. 30" Maple 74' Rt. " 156+04 " 634.91
BM#3 " 18" Elm 107' Rt. " 163+39 " 627.38

BAKERSFIELD 147
SERIES STATE No. 151-M
Sheet 4 of Sheets

DIST. II 8 PLANS 4