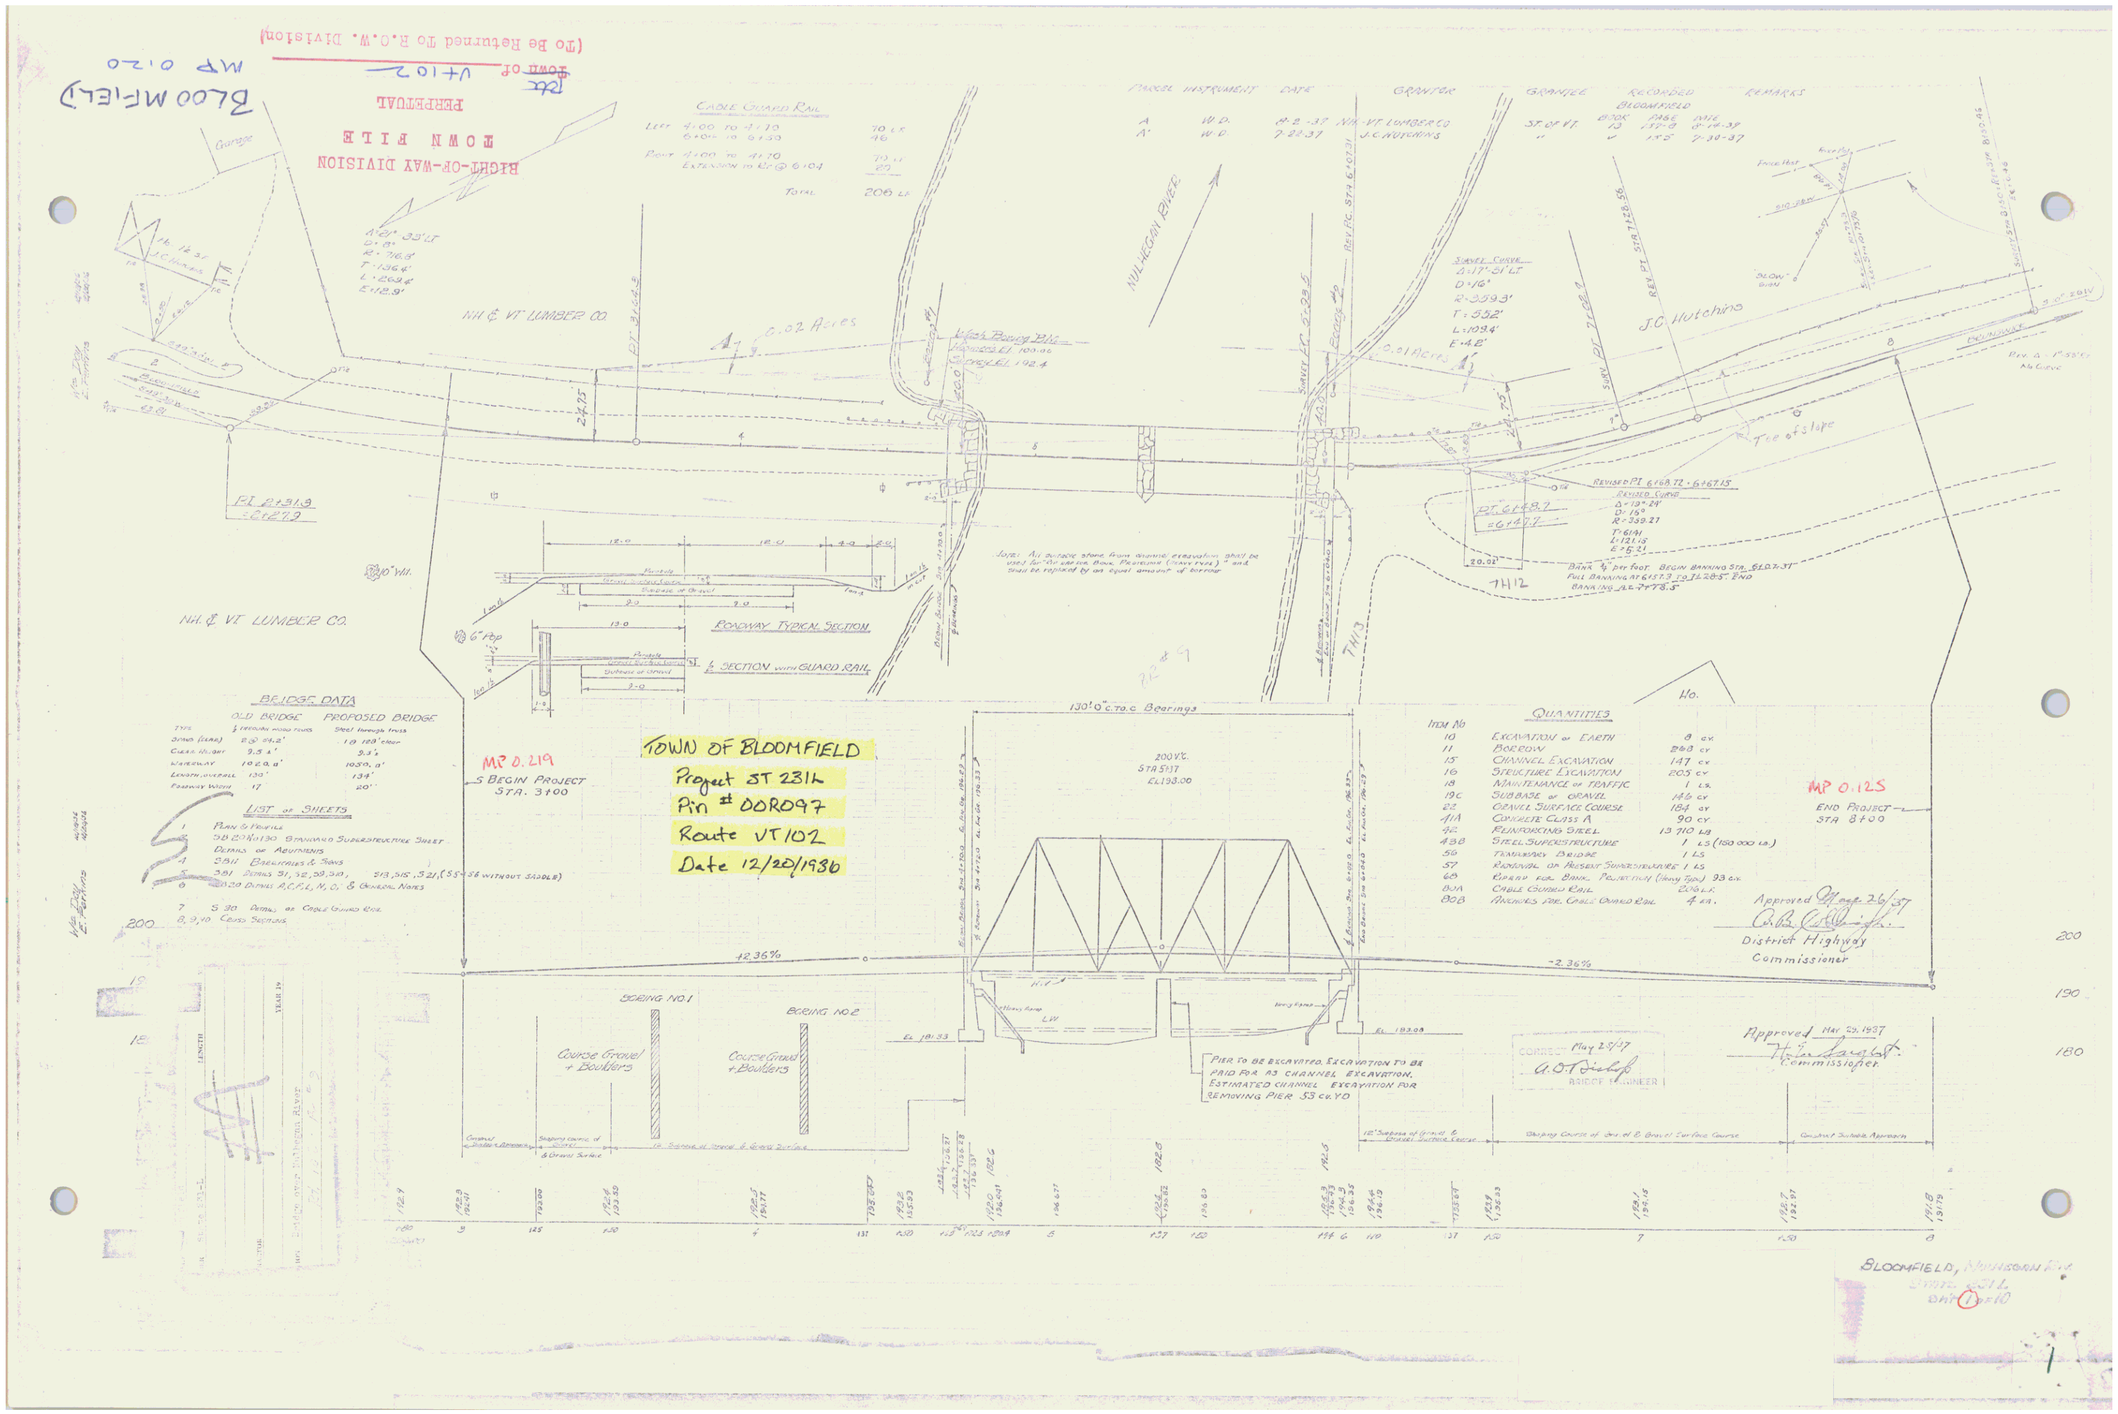RIGHT-OF-WAY DIVISION
TOWN FILE
PERPETUAL
~~TOWN OF~~ VT 102
(To Be Returned To R.O.W. Division)
BLOOM FIELD
MP 0.20