


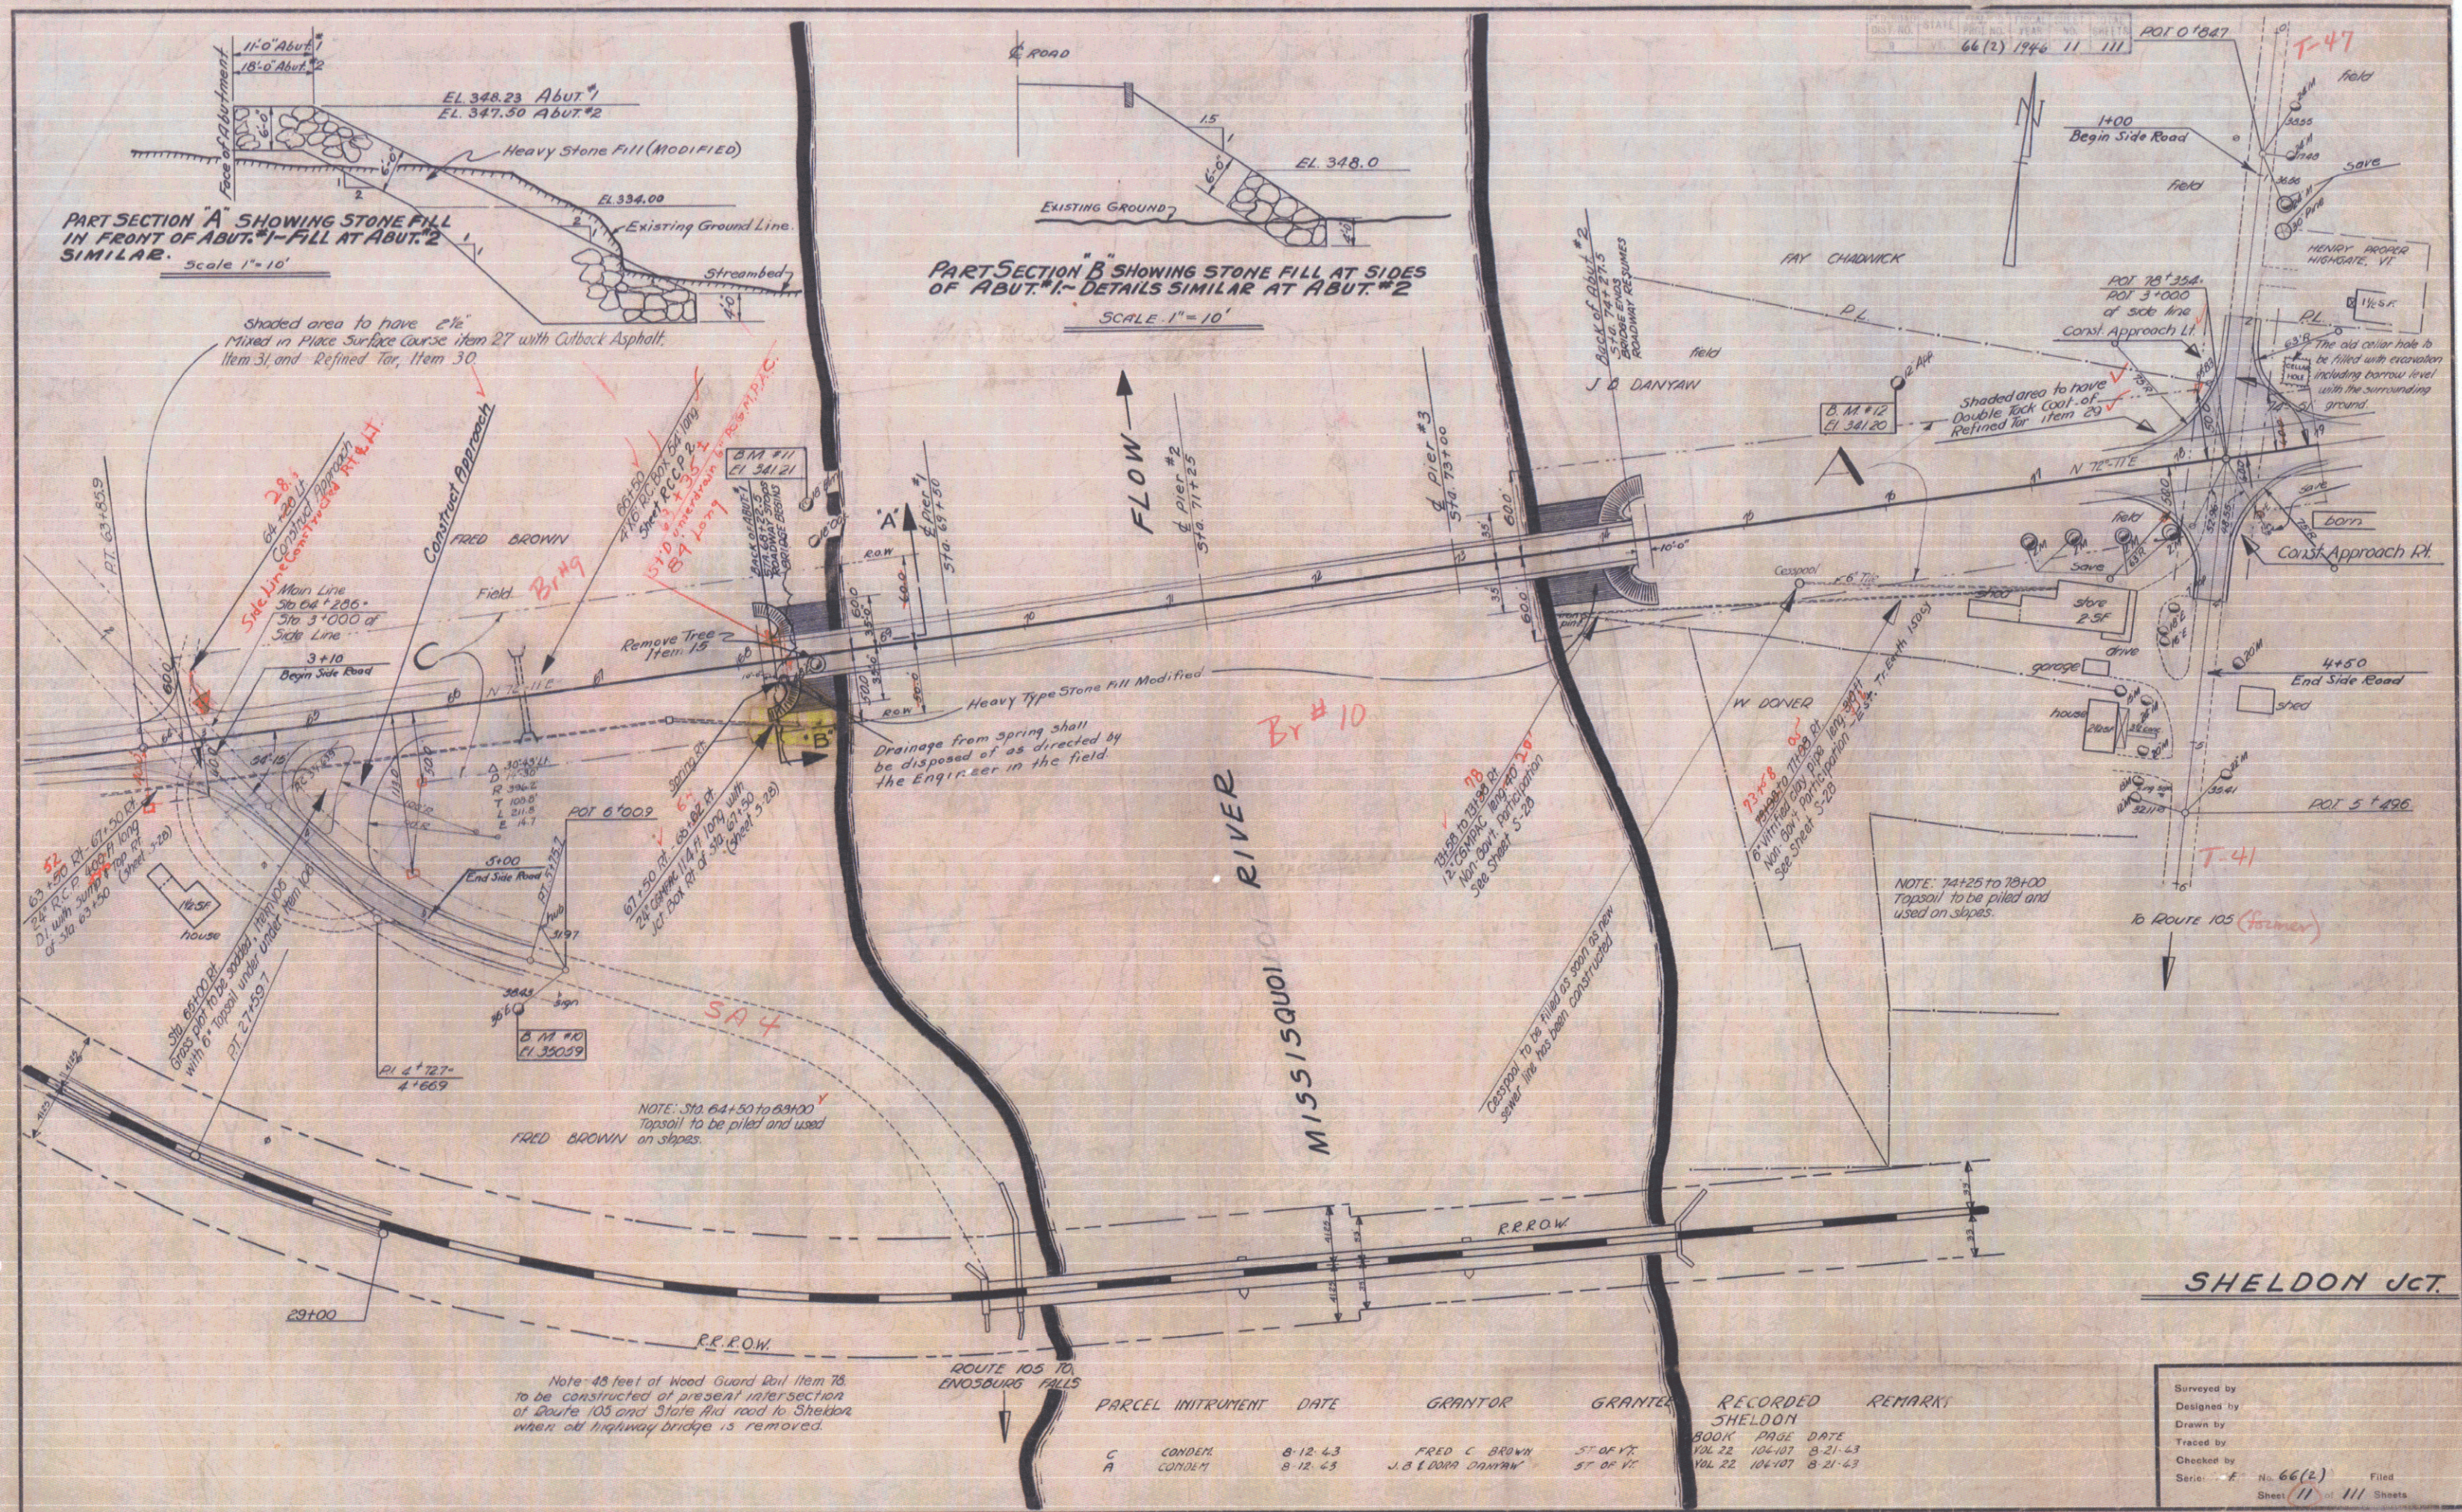

PART SECTION A SHOWING STONE FILL IN FRONT OF ABUT. #1 - FILL AT ABUT. #2 SIMILAR. Scale 1"=10'

PART SECTION B SHOWING STONE FILL AT SIDES OF ABUT. #1 - DETAILS SIMILAR AT ABUT. #2 SCALE 1"=10'

SHELDON JCT.

Note: 48 feet of Wood Guard Rail Item 78 to be constructed at present intersection of Route 105 and State Rd. road to Sheldon when old highway bridge is removed.

PARCEL INSTRUMENT	DATE	GRANTOR	GRANTEE	RECORDED	REMARKS
C	CONDEN.	8-12-43	FRED C. BROWN	ST. OF VT.	

Surveyed by	Designed by	Drawn by	Traced by	Checked by	Series	File
					66(2)	111
					Sheet 11 of 111	