


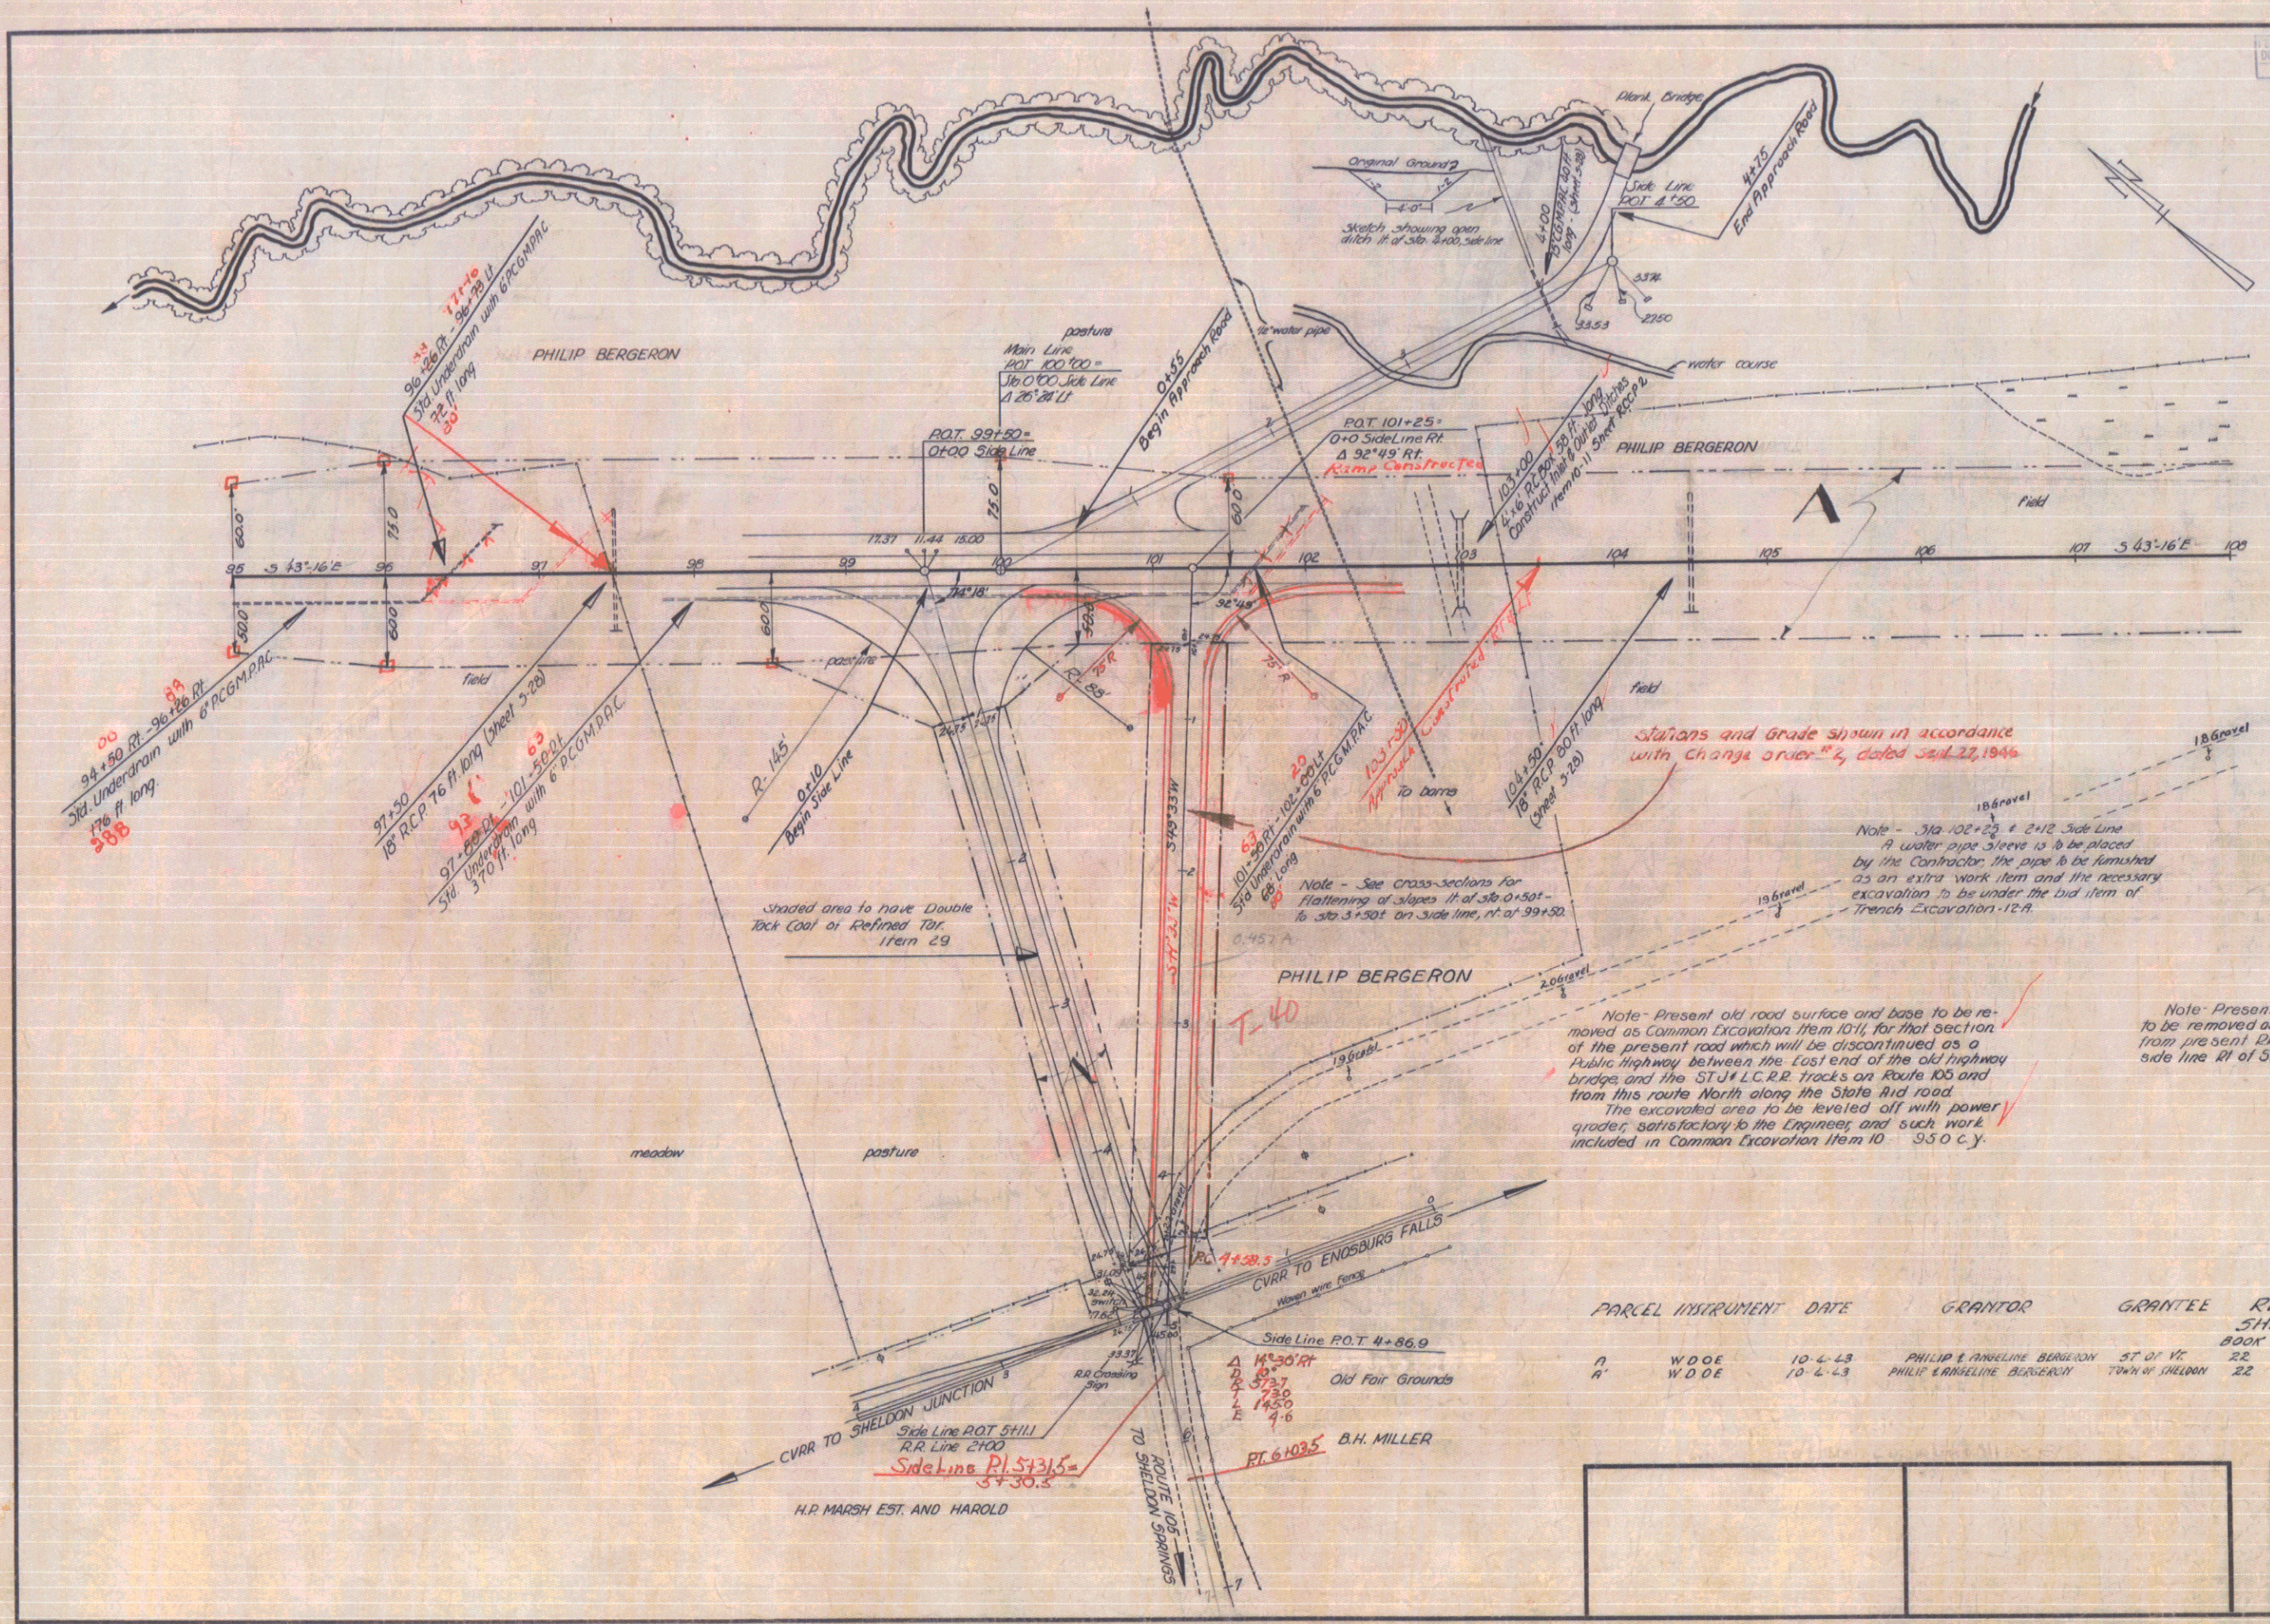

PARCEL	INSTRUMENT	DATE	GRANTOR	GRANTEE	RECORDED	REMARKS

 Surveyed by LONE
 Designed by J.E.F.
 Traced by J.O.C.
 Checked by
 Series 66(2) Filed
 Sheet 15 of 111