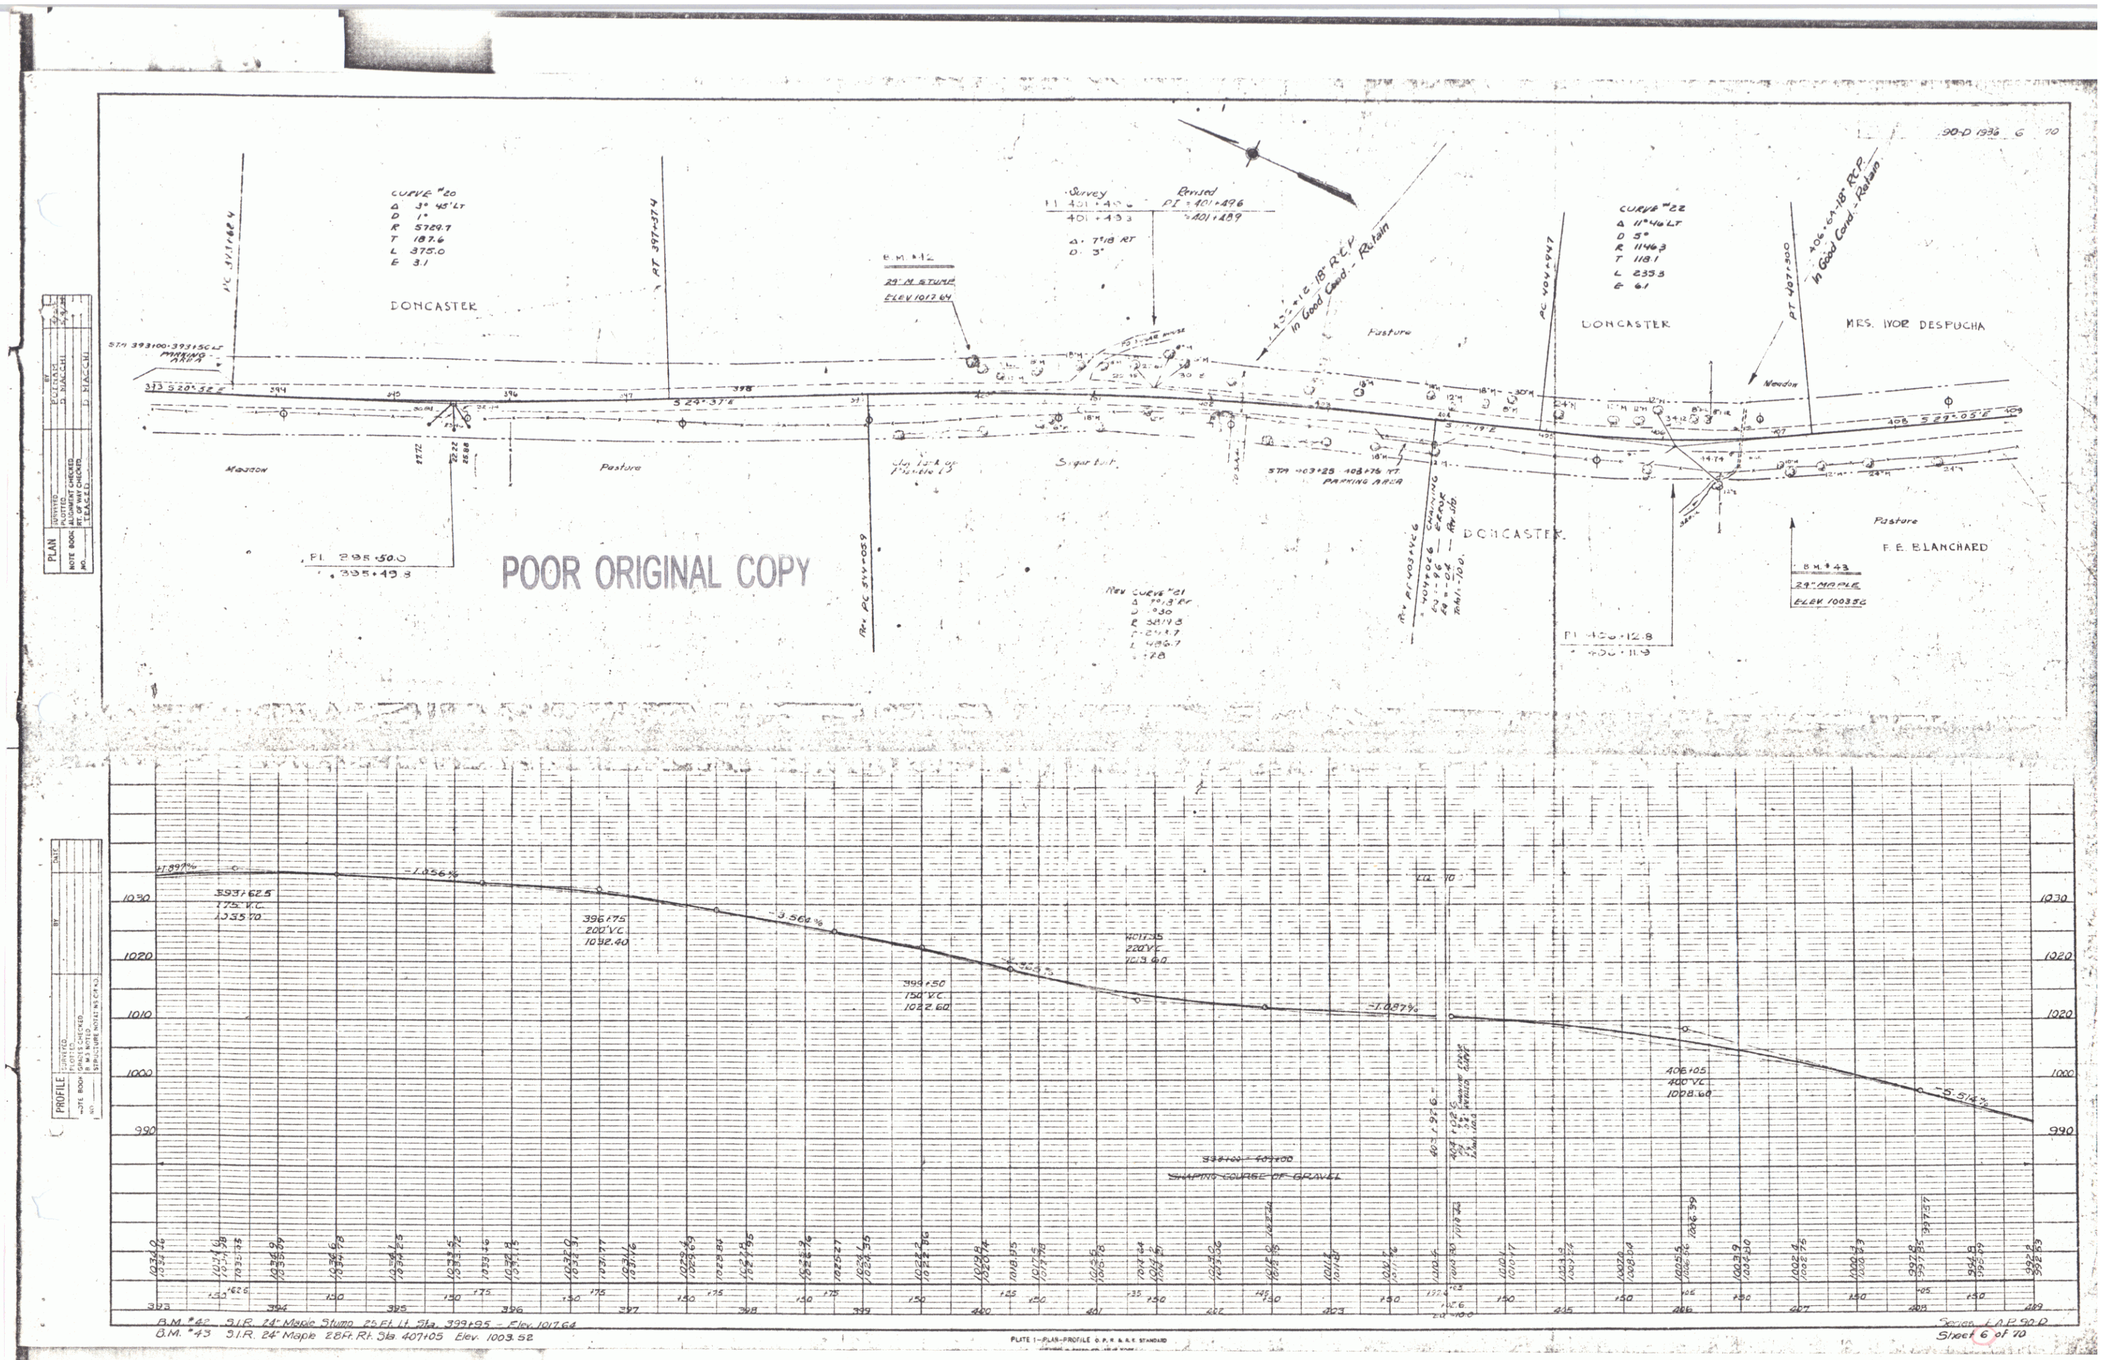
90-D 1936 6 70
CURVE #20
Δ 3° 45' LT
D 1°
R 5729.7
T 187.6
L 375.0
E 3.1
DONCASTER
Meadow
Pasture
Survey
Revised
Δ 7°18' RT
D 3°
B.M. #42
24" M. STUMP
ELEV 1017.64
Sugar bush
Pasture
CURVE #22
Δ 11°46' LT
D 5°
R 1146.3
T 118.1
L 233.3
E 6.1
DONCASTER
MRS. IVOR DESPUCHA
Needle
Pasture
F. E. BLANCHARD
B.M. #43
24" MAPLE
ELEV 1003.52
DONCASTER
POOR ORIGINAL COPY
PLAN
PROFILE
1036.10
1037.64
1035.33
1035.99
1035.69
1036.62
1036.78
1036.23
1034.25
1032.55
1032.72
1031.28
1031.15
1027.70
1027.31
1027.77
1027.16
1025.43
1025.83
1028.83
1027.95
1027.32
1022.76
1022.36
1025.27
1024.35
1027.26
1022.36
1020.74
1018.35
1017.76
1015.70
1014.78
1015.56
1015.28
1017.24
1014.24
1014.89
1013.56
1015.70
1014.78
1014.15
1013.45
1011.76
1011.24
1011.17
1011.24
1013.74
1013.28
1013.56
1015.56
1015.28
1013.39
1013.30
1012.14
1012.75
1011.53
1011.53
997.18
997.18
997.37
996.43
996.43
995.53
995.53
1030
1020
1010
1000
990
-1.856%
-3.564%
-1.087%
-5.514%
593+62.5
175' VC
1035.70
396+75
200' VC
1032.40
399+50
150' VC
1022.60
401+35
200' VC
1023.60
406+05
400' VC
1008.60
SHAPING COURSE OF GRAVEL
B.M. #42 S.I.R. 24" Maple Stump 25 Ft. Lt. Sta. 399+95 - Elev. 1017.64
B.M. #43 S.I.R. 24" Maple 28 Ft. Rt. Sta. 407+05 Elev. 1003.52
PLATE 1—PLAN-PROFILE O.P.R. & A.R. STANDARD
Sheet 6 of 70

4