VERMONT FOREST HIGHWA.
PROJECT No. 7-A
Sheet No. 20 of 56

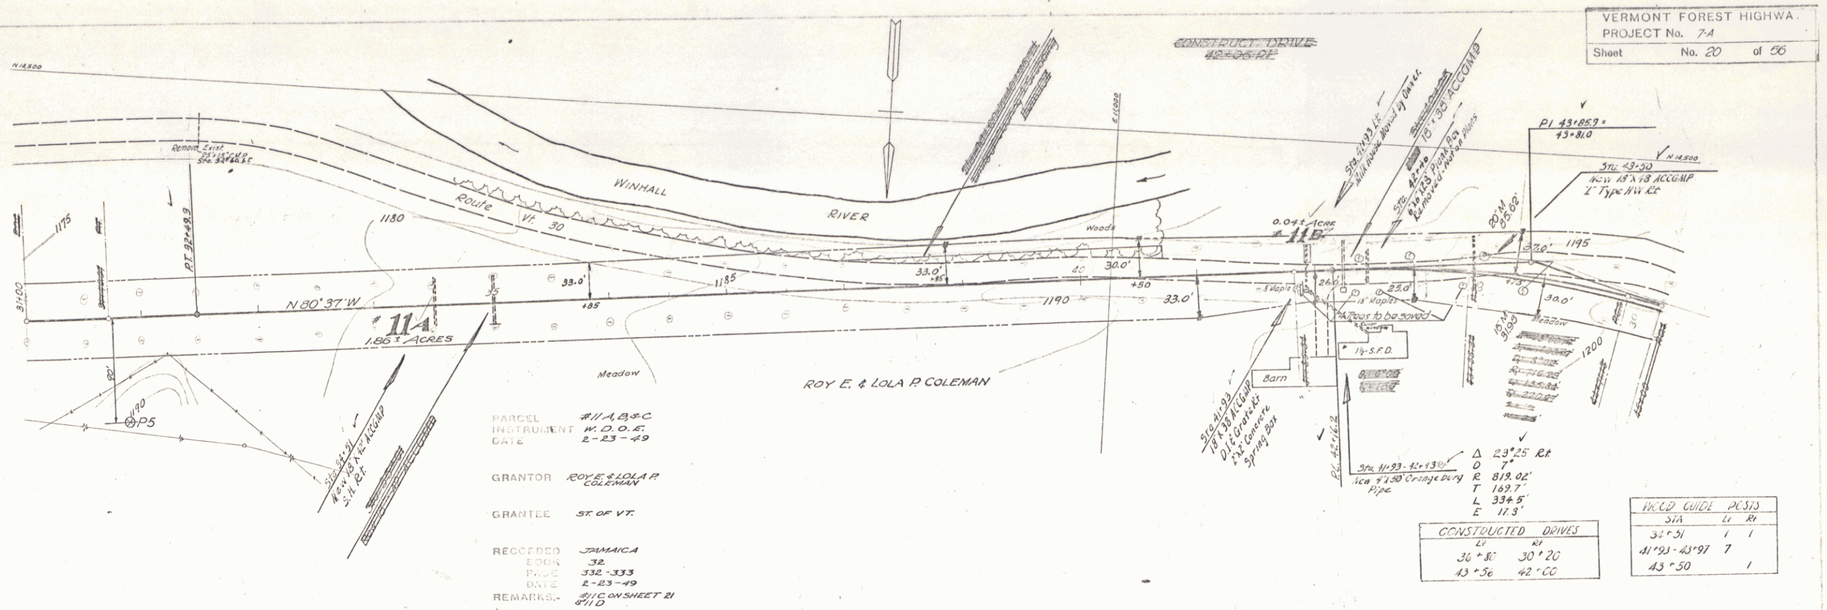

PARCEL #11-A, B & C
INSTRUMENT W. D. O. S.
DATE 2-23-49

GRANTOR ROY E. & LOLA P. COLEMAN

GRANTEE ST. OF VT.

RECORDED JAMAICA
BOOK 32
PAGE 332-333
DATE 2-23-49
REMARKS.- #11C ON SHEET 21
#11D

Δ 23°25' Rt
D 7°
R 819.02'
T 169.7'
L 33+5'
E 17.3'

CONSTRUCTED DRIVES	
Lt	Rt
36+80	30+20
43+56	42+00

WOOD GUIDE POSTS		
STA	Lt	Rt
36+51	1	1
41+93 - 43+97	7	
43+50		1

B.M.#2-Elev.1186.04 Spike in root 13" Pine 32' left Sta 37+45

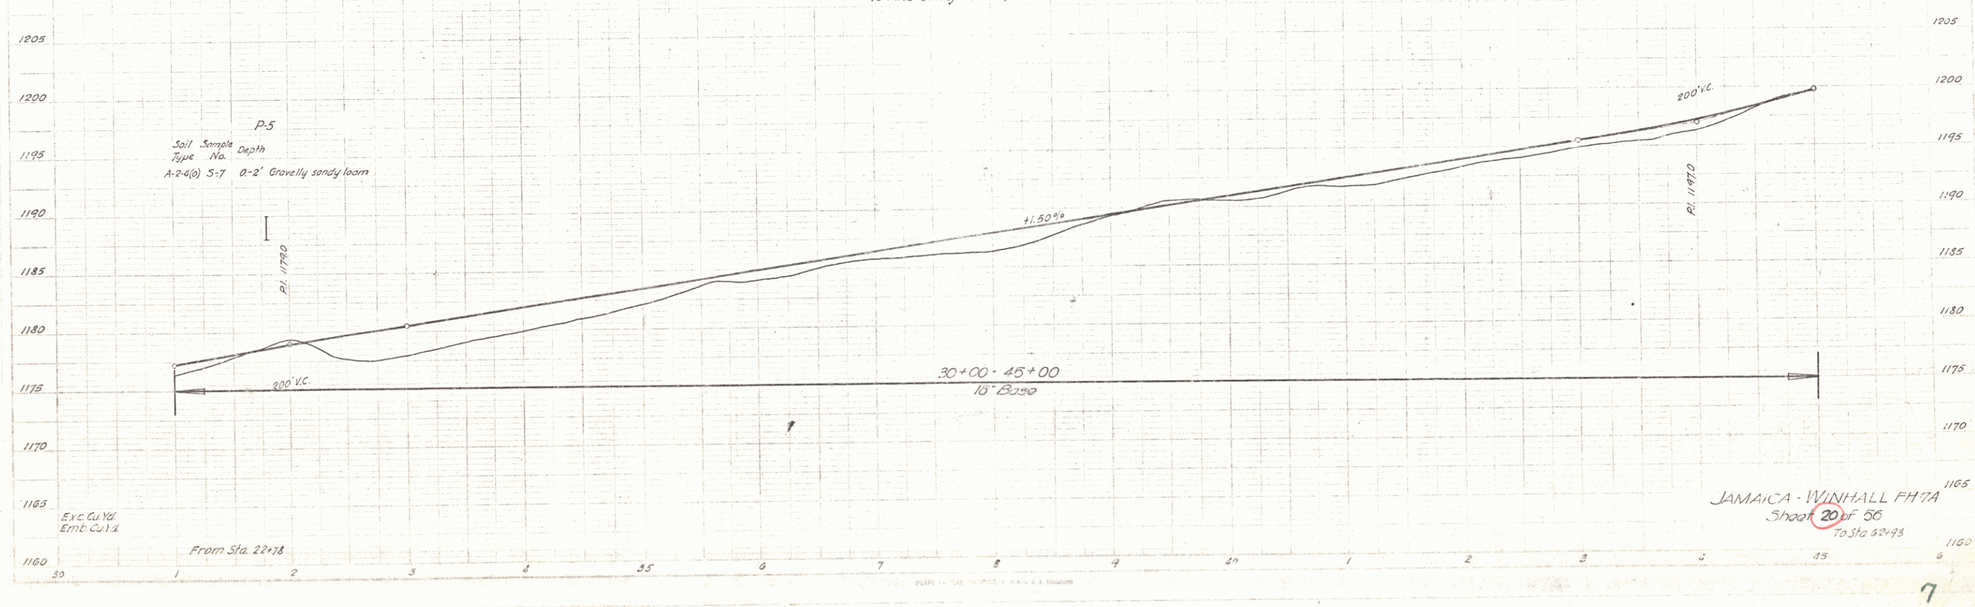

JAMAICA - WINHALL FH 7A
Sheet 20 of 56

7