


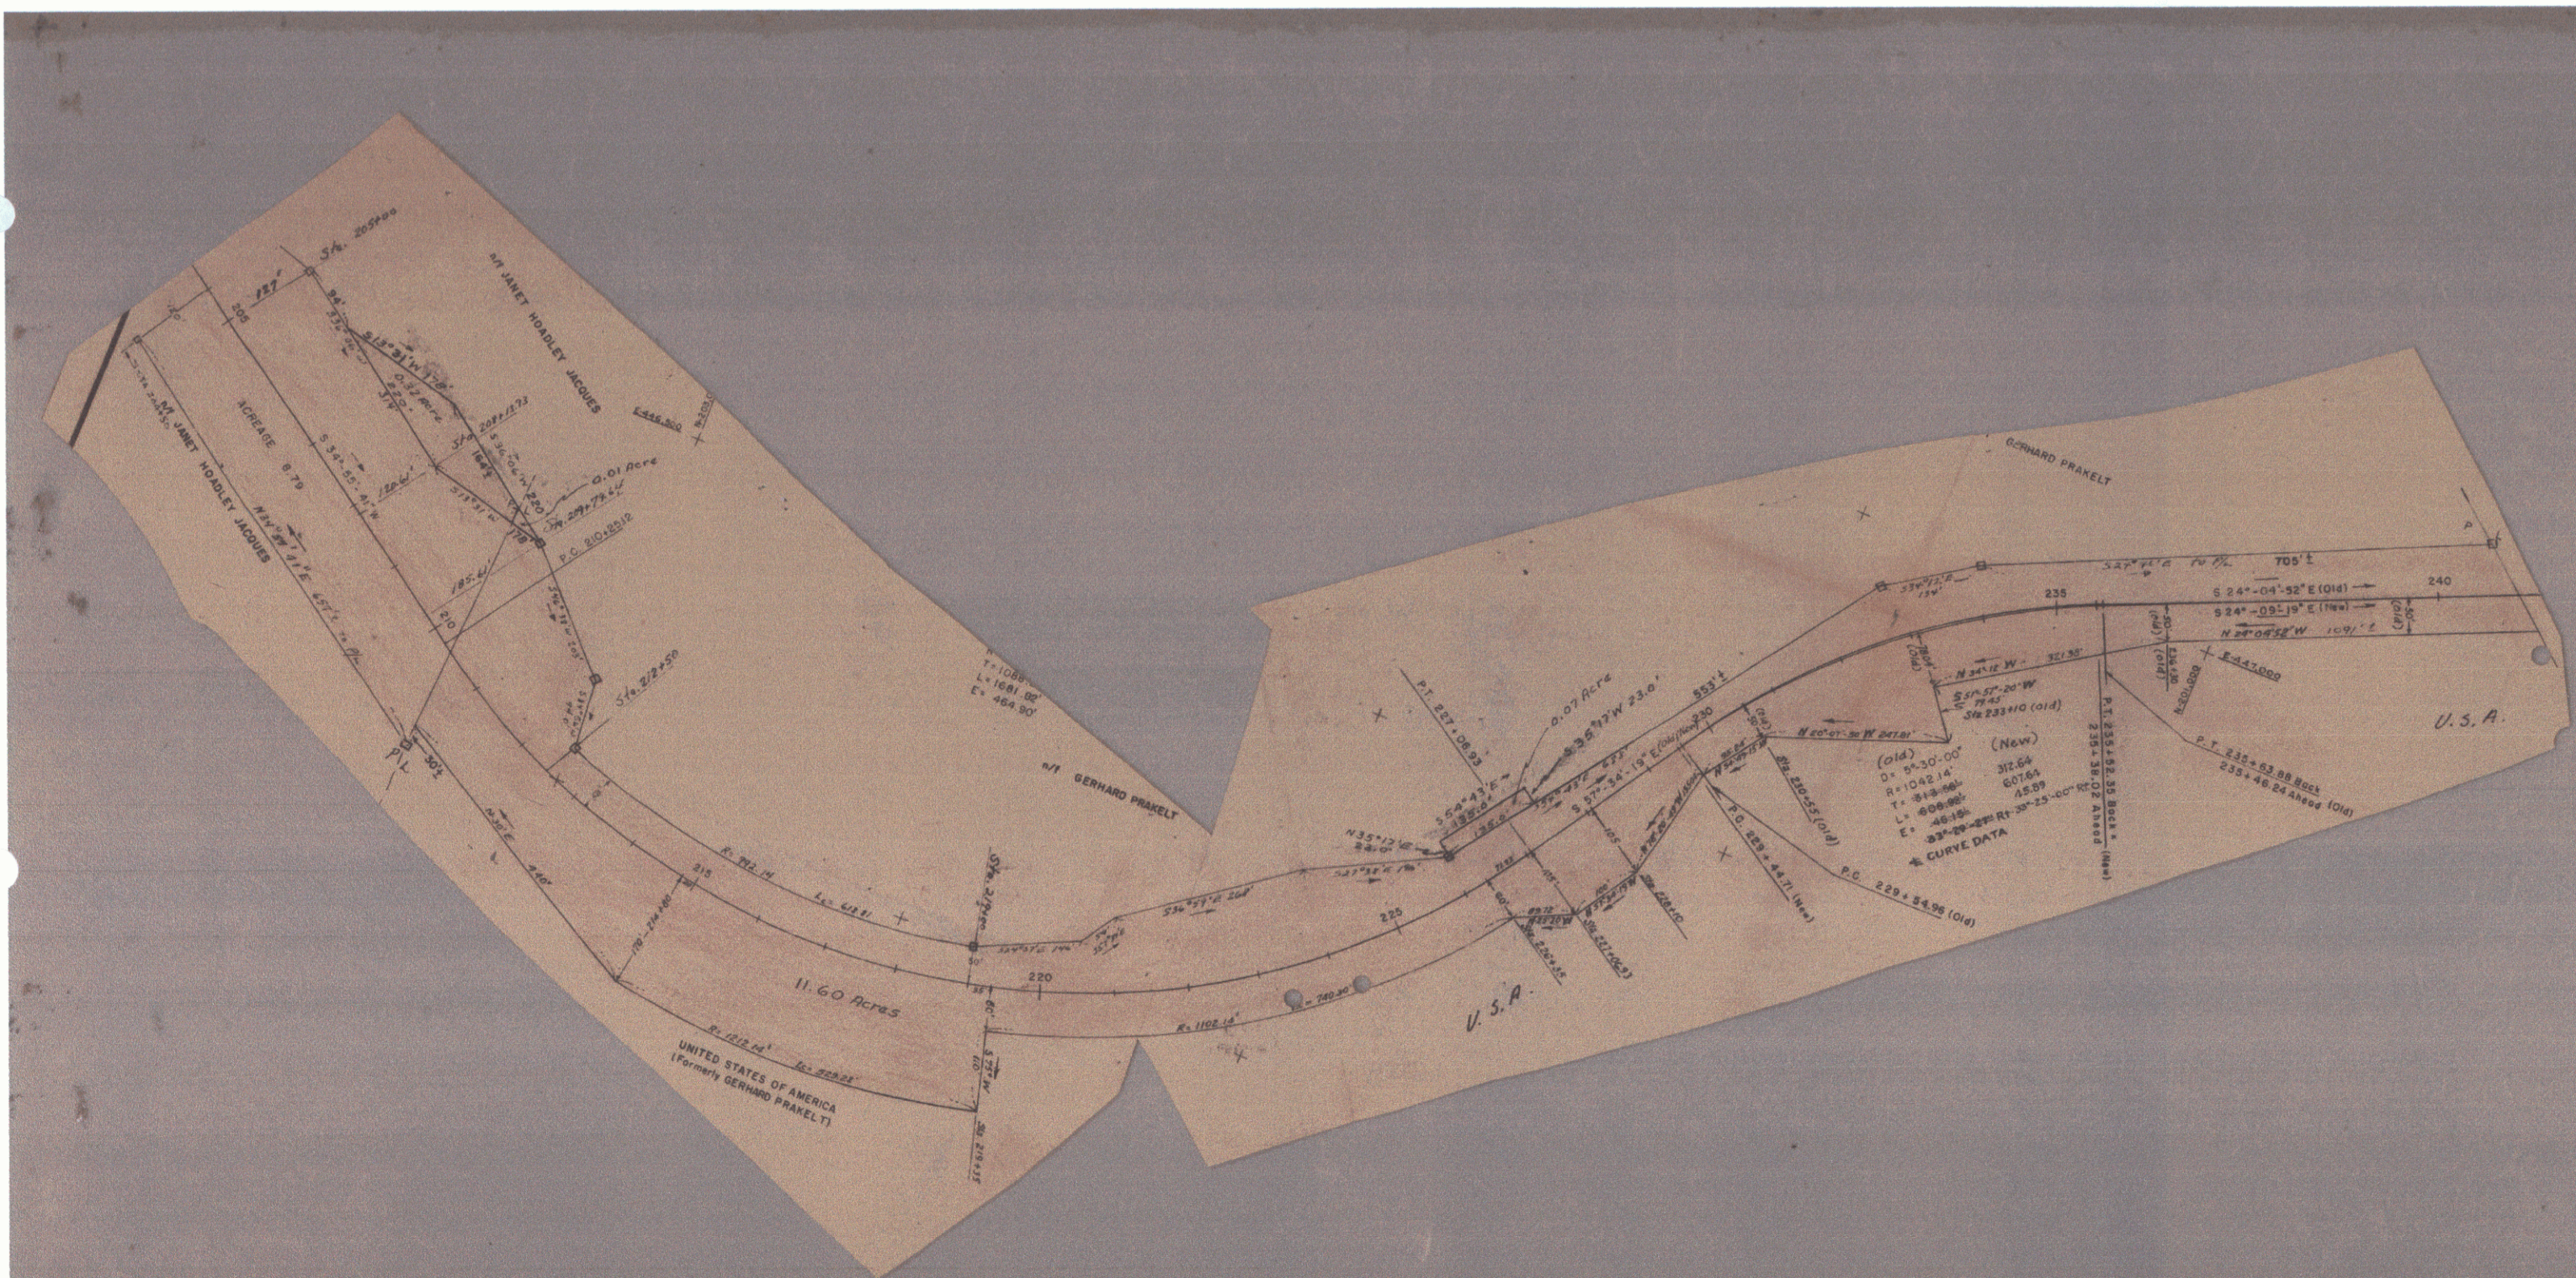

4