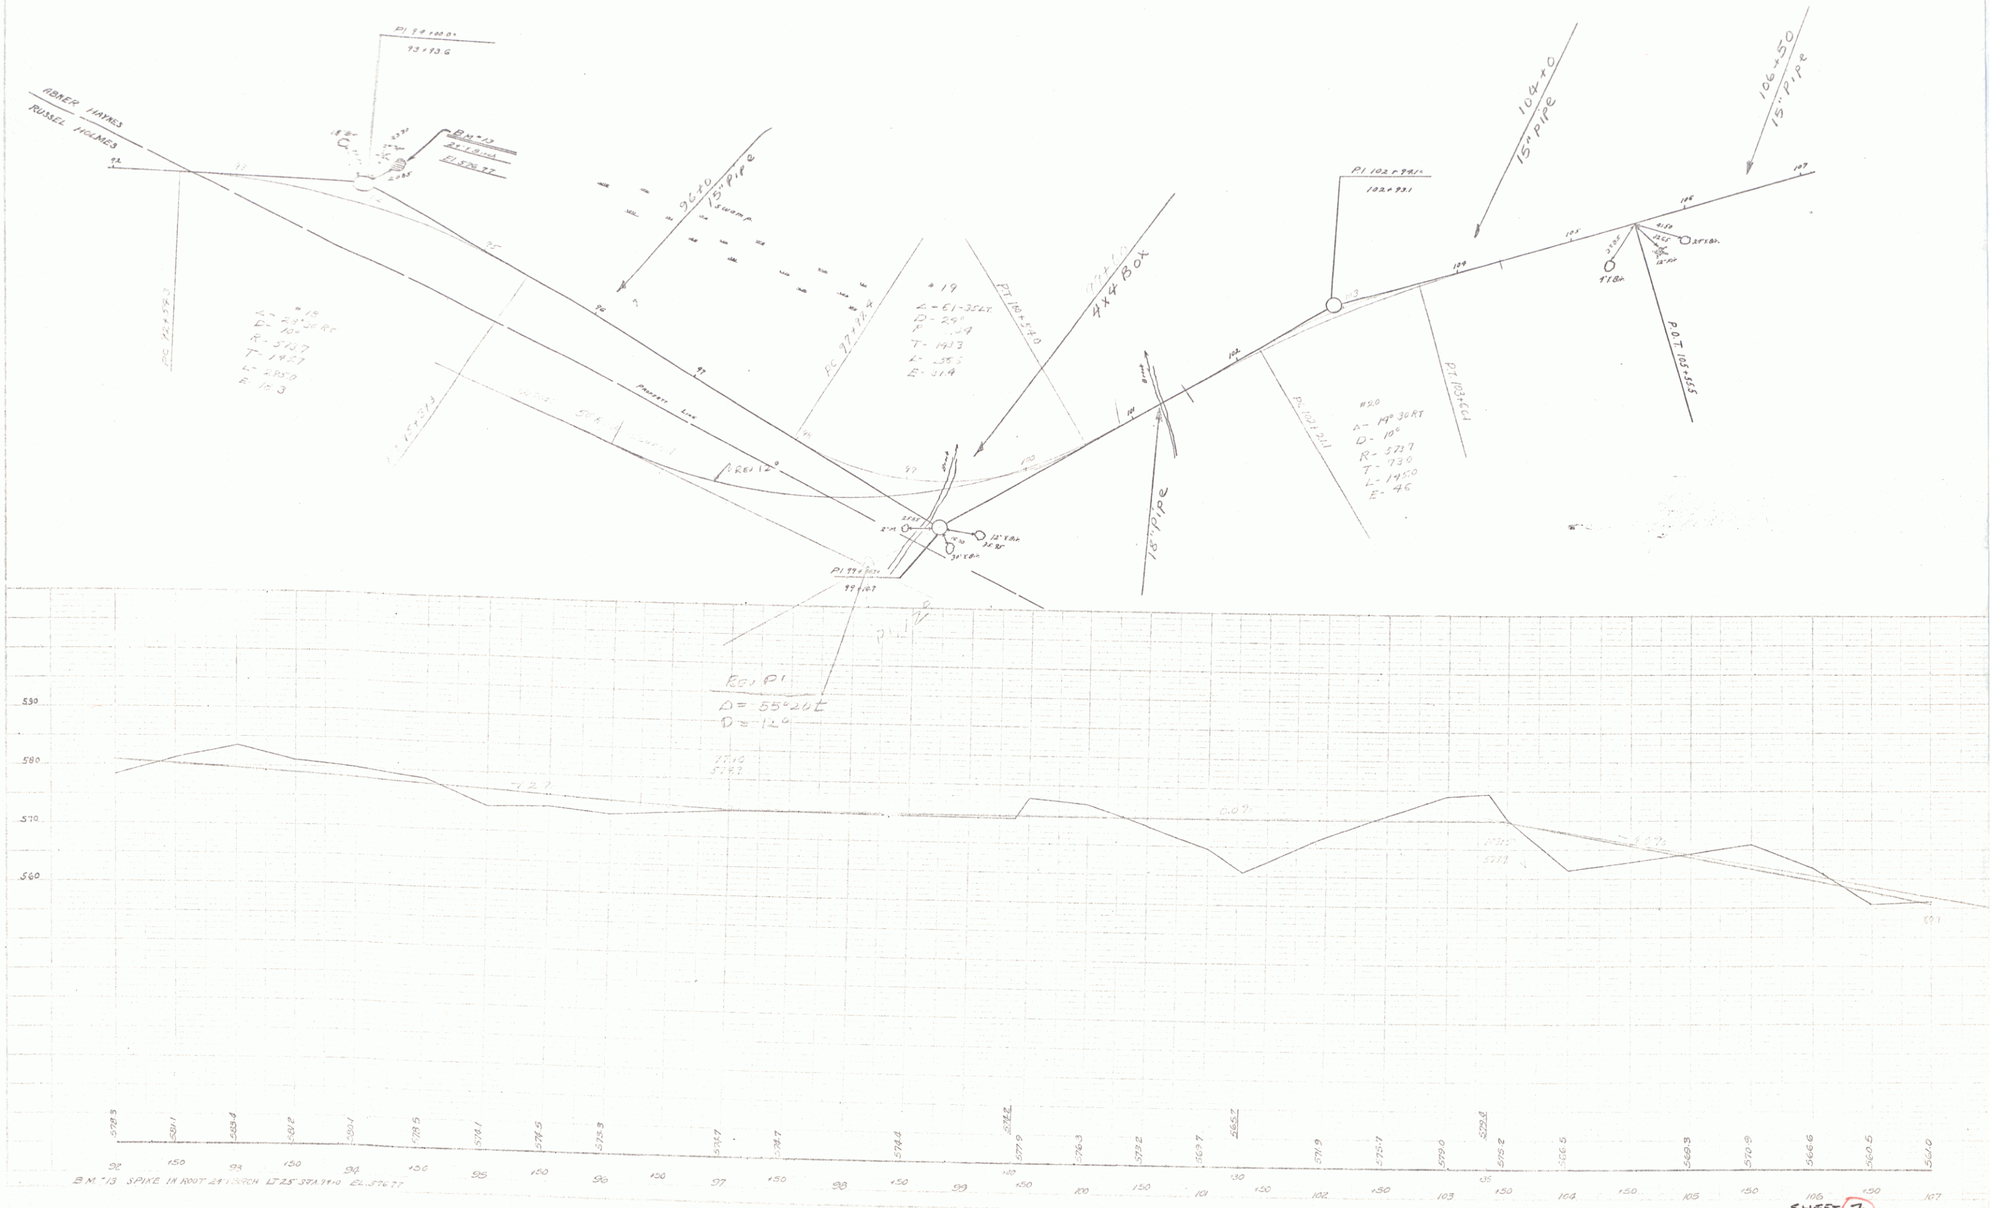
ABNER HAYNES
RUSSEL HOLMES
PI 99+00±
93+13.6
BM #13
96+20
15" PIPE
PC 97+12.4
PT 100+40
4x4 BOX
PI 102+99±
102+93.1
104+10
15" PIPE
106+50
15" PIPE
PC 102+21.1
PT 103+66.1
P.O.T. 103+55
18" PIPE
PI 99+00±
99+07
Rev PI:
Δ = 55°20'Lt
D = 12°
Property Line
Rev 12°
530
580
570
560
B.M. #13 SPIKE IN ROOT 24" BIRCH 17.25' STA 99+10 EL. 576.77

SHEET 7

7