PARCEL	INSTRUMENT	DATE	GRANTOR	GRANTEE	BOOK	PAGE	RECORDED ADDISON DATE	REMARKS
J A	W.D.O.E.	10-10-46	CHARLES L. SEEGER	ST. OF VT.	29	262-263	10-19-46	

5 18(3) 1946 25 117

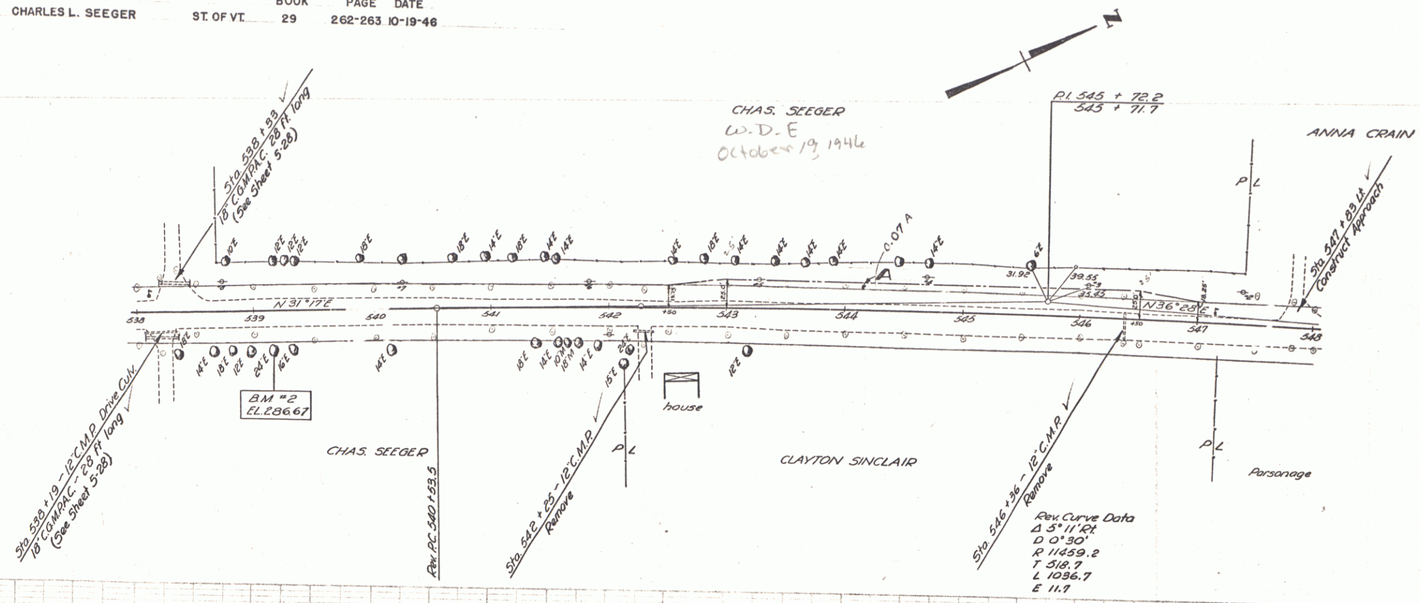

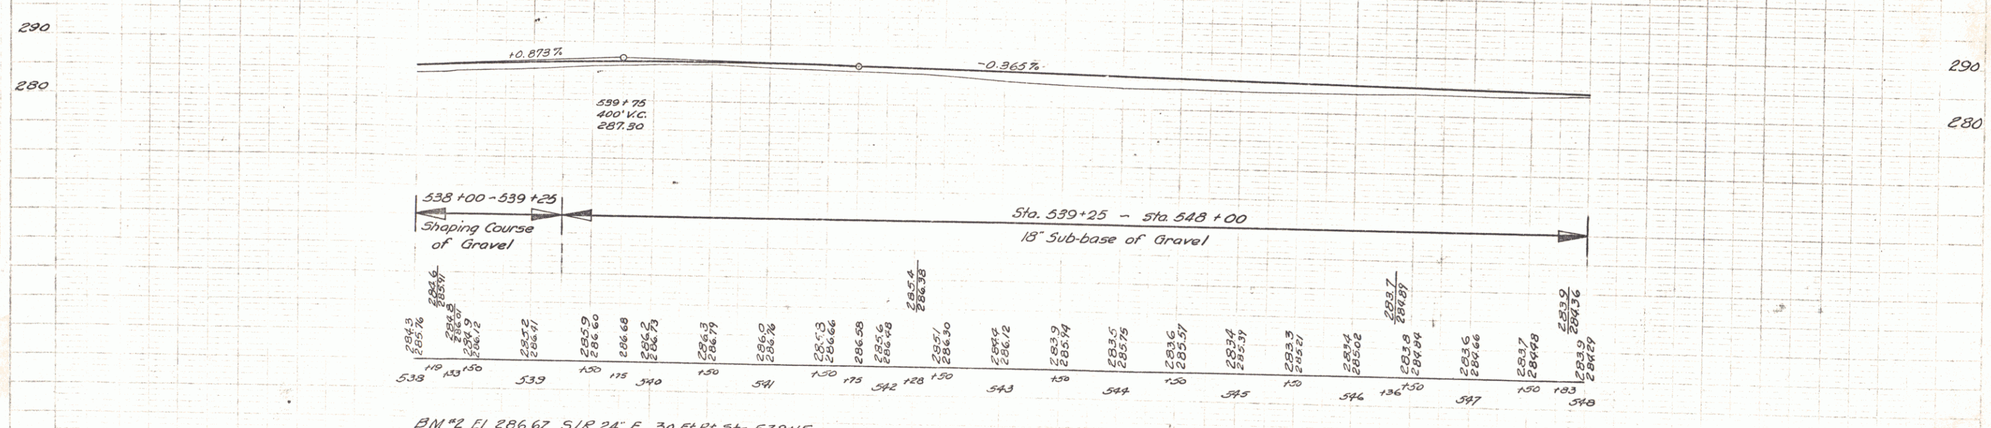

BM #2 El. 286.67 S.I.R. 24" E 30 Ft. Rt. Sta. 539+15

Bridport - Addison
series 5 no. 18(3)
sheet 23 of 117 sheets

23