VERTICAL GRANITE CURB

Lt
36+00 - ~~37+27~~ 37+66
~~37+86 - 39+30~~ 37+84 - 39+28
~~39+39 - 39+44 (Drive)~~
~~39+44 - 39+76~~
39+41 - 39+53
~~39+76 - 0+29 T.H. #26~~
~~0+29 - 0+60~~
~~0+76 - 42+00~~
T 0+60 - 42+00

Rt
36+00 - ~~36+38~~ 36+26
~~36+47 - 36+88~~ 36+48 - 36+79
~~37+00 - 38+00~~ 36+98 - 37+99
38+4 - 38+63
~~38+79 - 39+32~~ 38+81 - 39+89
~~40+24 - 41+63~~ 40+19 - 40+58
40+72 - 41+60
~~41+76 - 41+91~~ 42+00

BITUMINOUS CONCRETE SIDEWALK

Lt
36+00 - ~~39+48~~ 41+55
~~39+73 - 41+18~~
41+84 - 42+00 ✓
40+18 ✓
40+40 ✓
~~41+90~~
39+13 ✓

Rt
36+00 - 42+00 ✓
36+55 ✓
37+15 ✓
37+60 ✓
37+82 ✓
~~38+200~~
~~38+40~~
39+00 ✓
~~39+37~~
~~41+125~~

CONSTRUCT DRIVE

Lt
37+75 ✓
39+35 ✓
~~41+35~~
40+60

Rt
36+41 ✓
36+90 ✓
38+05 ✓
38+71 ✓
40+10 ✓
40+18 ✓
41+70 ✓
40+65

CONSTRUCT APPROACH

Lt
~~39+50~~
41+50 (See Sheet 47 of 52)

REMOVING LARGE TREES

Lt
36+07 ✓
37+37 ✓
39+96 ✓
40+27 ✓

REMOVING LARGE STUMPS

Rt
38+60 ✓

REMOVING SMALL TREES

Lt
40+67 ✓

Rt
37+92 ✓

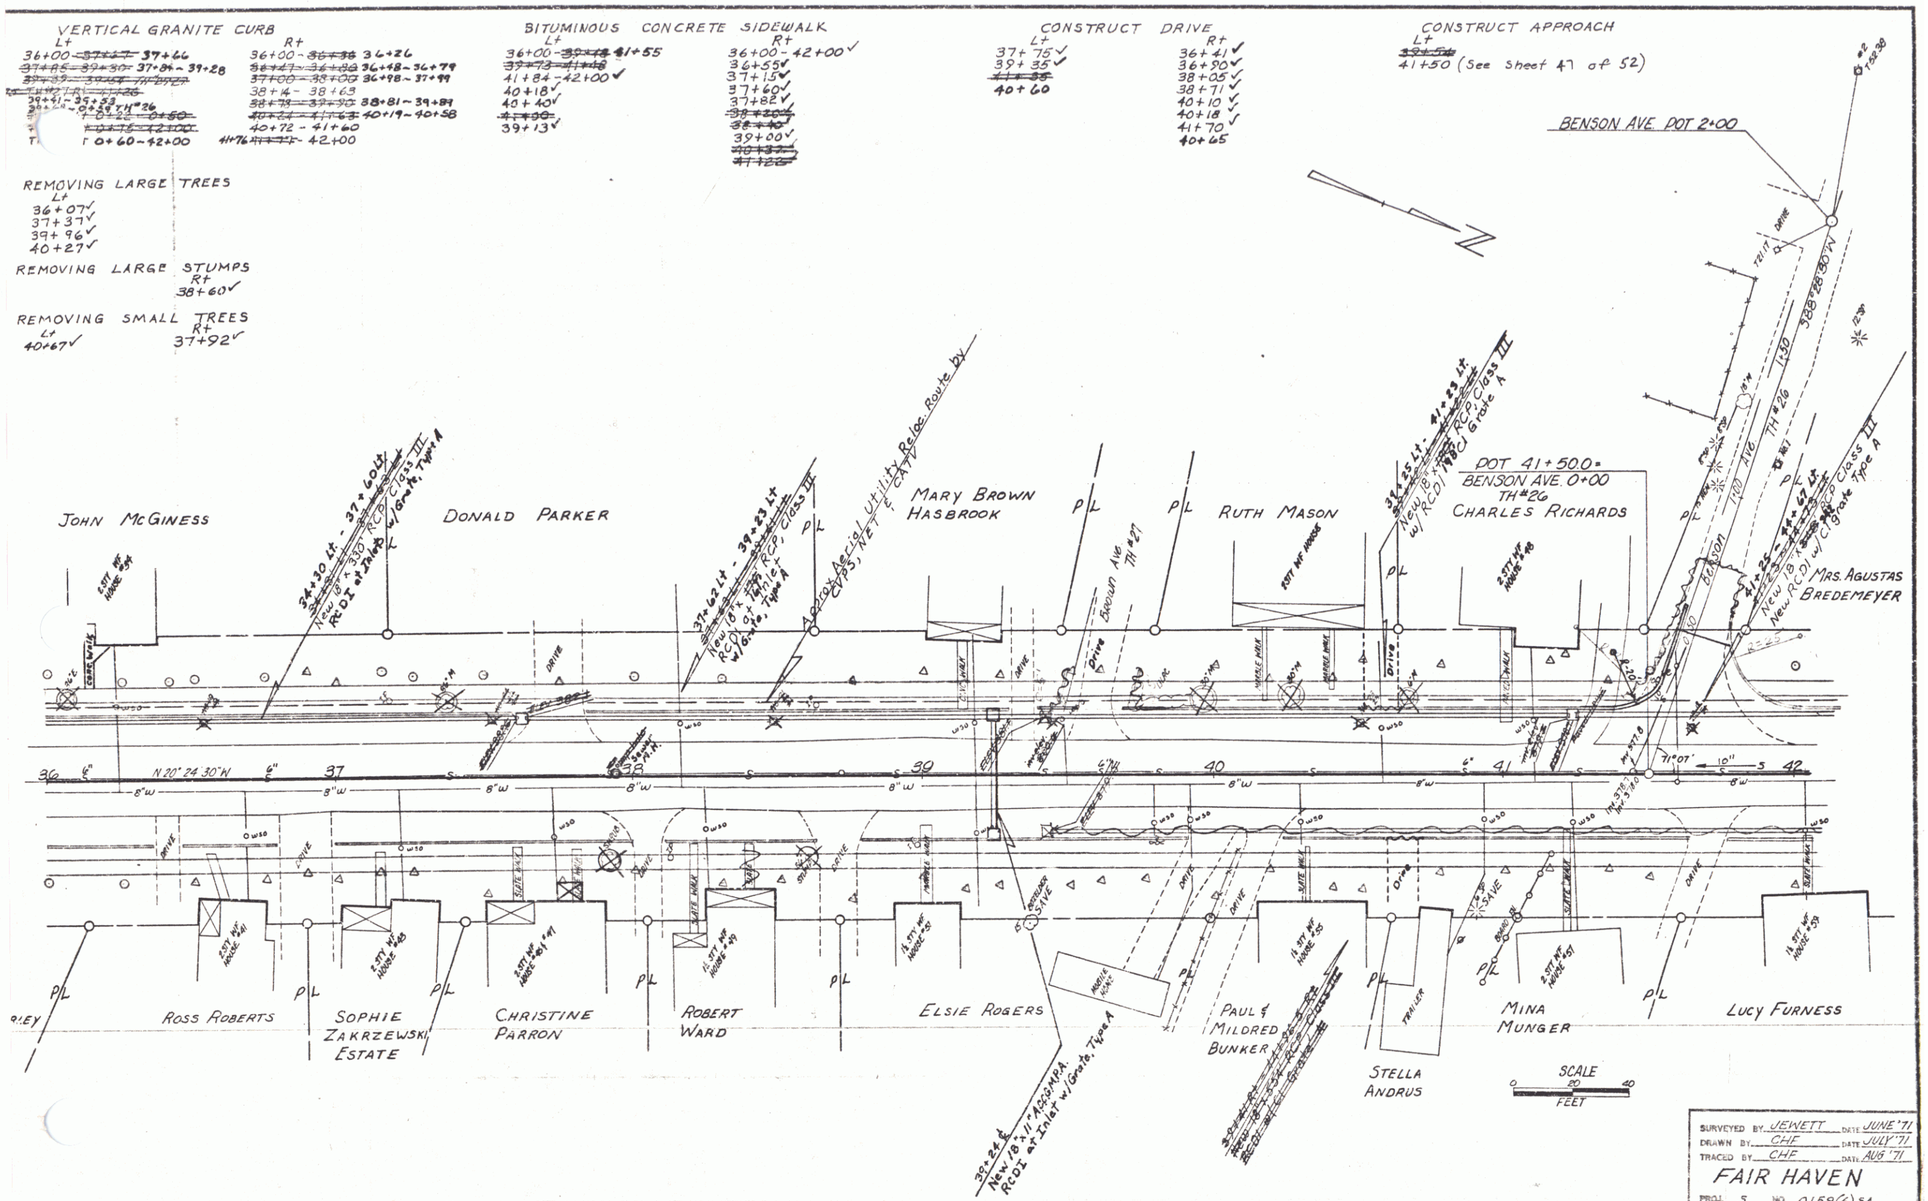

SURVEYED BY JEWETT DATE JUNE '71
DRAWN BY CHF DATE JULY '71
TRACED BY CHF DATE AUG '71

FAIR HAVEN

PROJ. 5 NO. 0159(6) SA
SHEET 8 OF 52

D-7

3