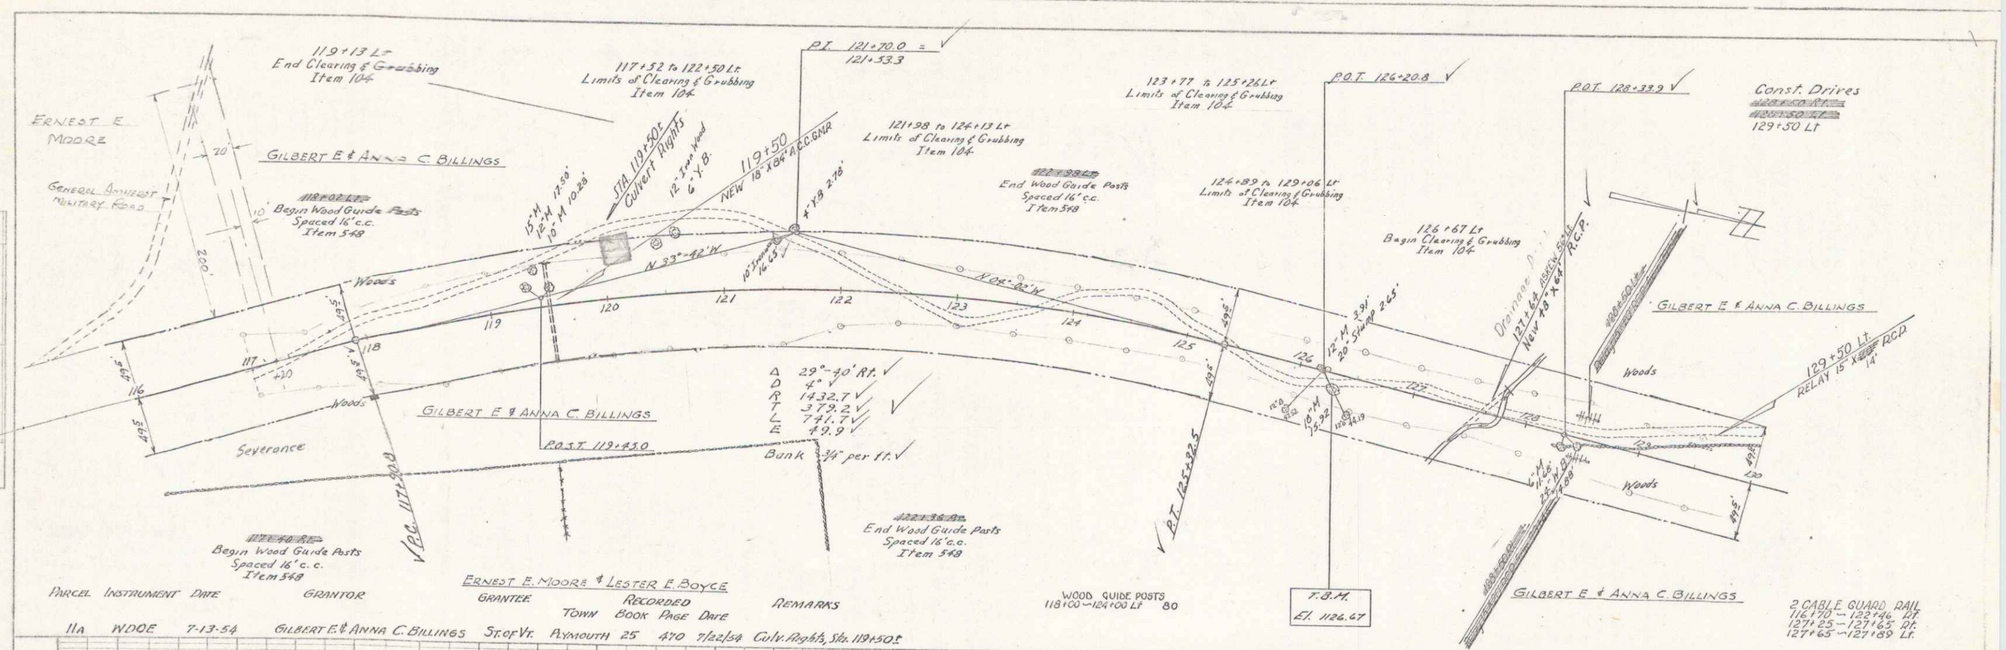

Parcel	Instrument	Date	Grantor	Grantee	Town	Book	Page	Date	Remarks
11a	WDOE	7-13-54	Gilbert E. & Anna C. Billings	St. of Vt.	Plymouth	25	470	7/22/54	Culv. Rights, Sta. 119+50 ±

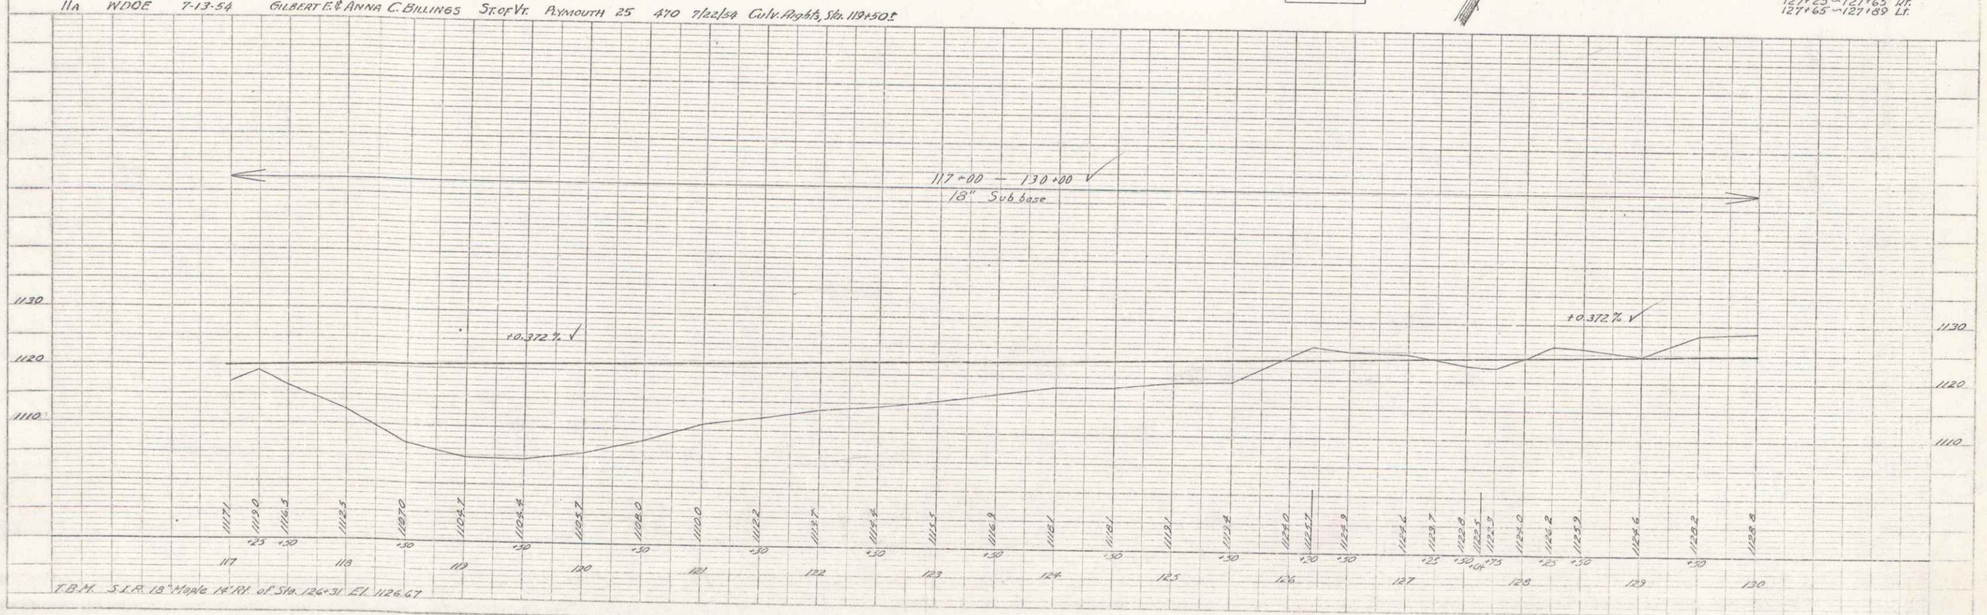

PLAN: Initials, Plotted, Traced, Checked, Grade Checked, Note Book, No.

PROFILE: Initials, Plotted, Traced, Checked, Grade Checked, Note Book, No.

PLATE 1—PLAN-PROFILE of T. R. & R. R. of VERMONT
BUTTON & BLISS CO., NEW YORK

PLYMOUTH
Project S-IM-4(1)
Sheet 13 of 160

13