


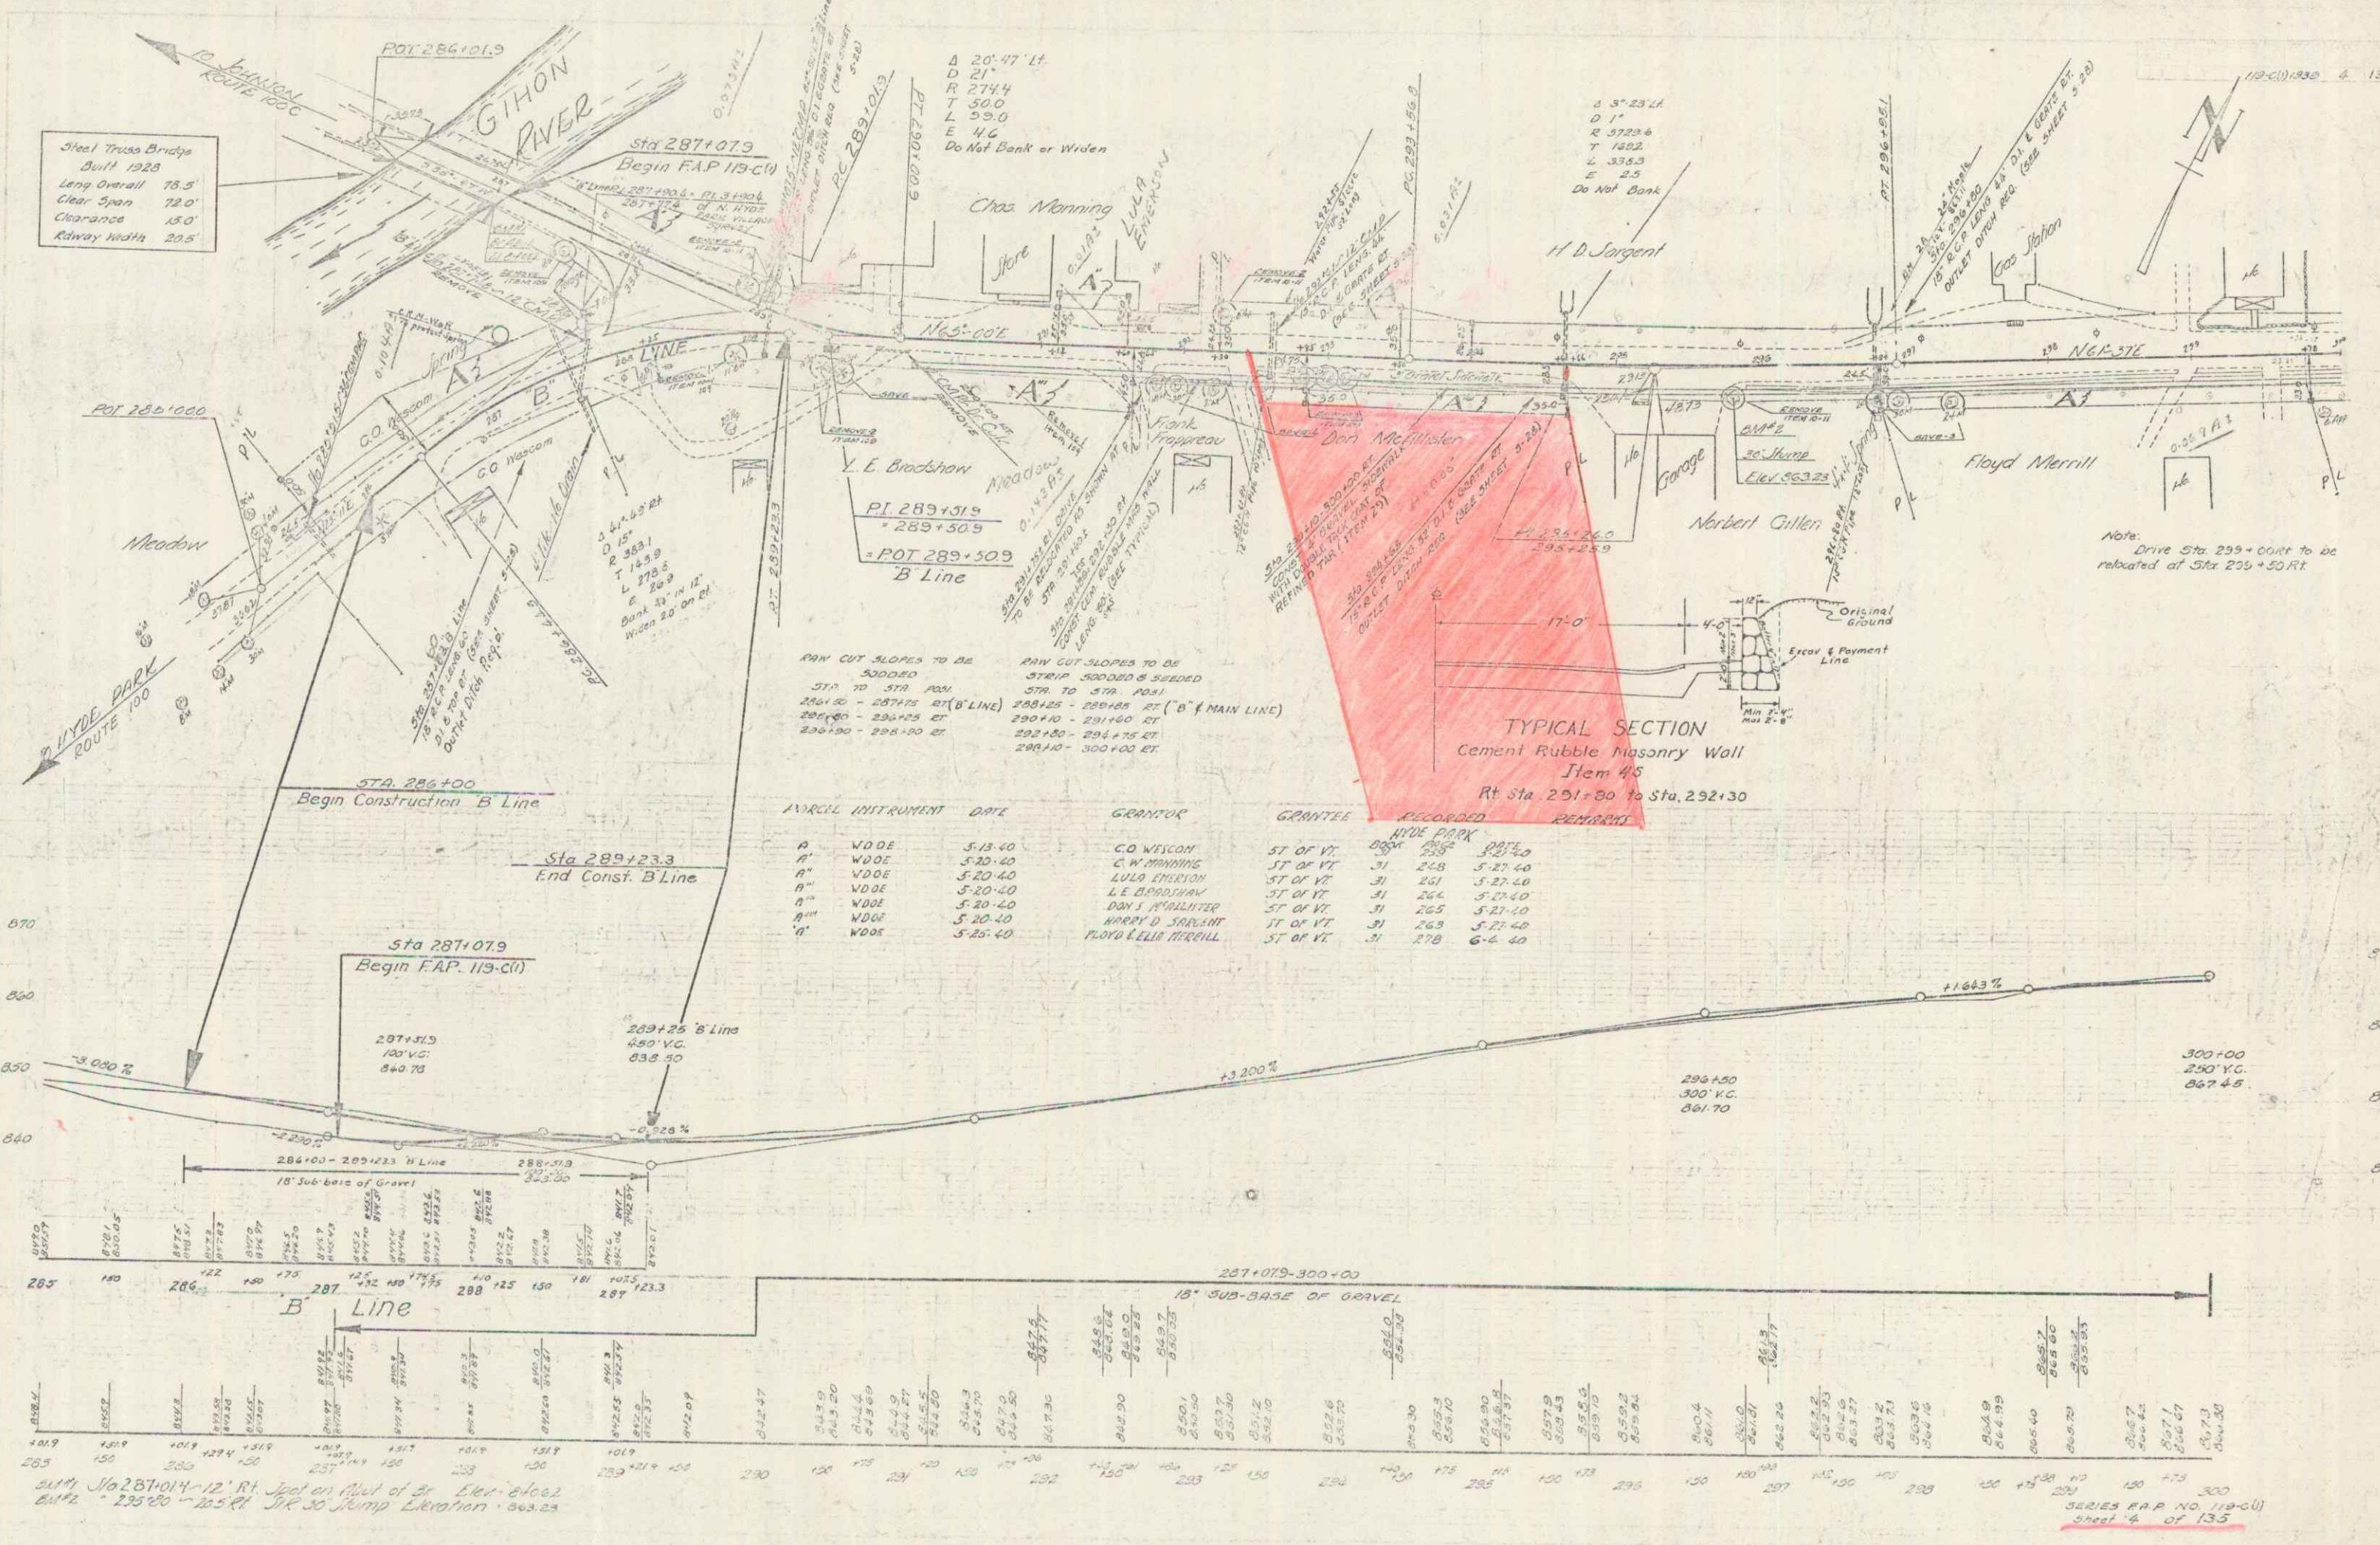

INSTRUMENT	DATE	GRANTOR	GRANTEE	RECORDED	REMARKS
W.D.C.	5-13-40	C.O. WISCOM	ST. OF VT.	263	5-27-40
W.D.C.	5-20-40	C.W. MANNING	ST. OF VT.	31	5-27-40
W.D.C.	5-20-40	L.E. BROADSHAW	ST. OF VT.	31	5-27-40
W.D.C.	5-20-40	DON J. McFILLISTER	ST. OF VT.	31	5-27-40
W.D.C.	5-25-40	FLOYD & ELIZ. MERRILL	ST. OF VT.	31	5-27-40

SERIES F.A.P. NO. 119-C1
