


POOR ORIGINAL COPY

TOWN OF SHERBURNE

Route 100
PROJECT FAE 101 G
DATE: 01/01/1934
PIN: 008651

MP 0.00 - 2.19
RIGHT-OF-WAY DIVISION
TOWN FILE
PERMIT
14100
[To Be Returned To H.O.W. Division]

SHERBURNE
14100

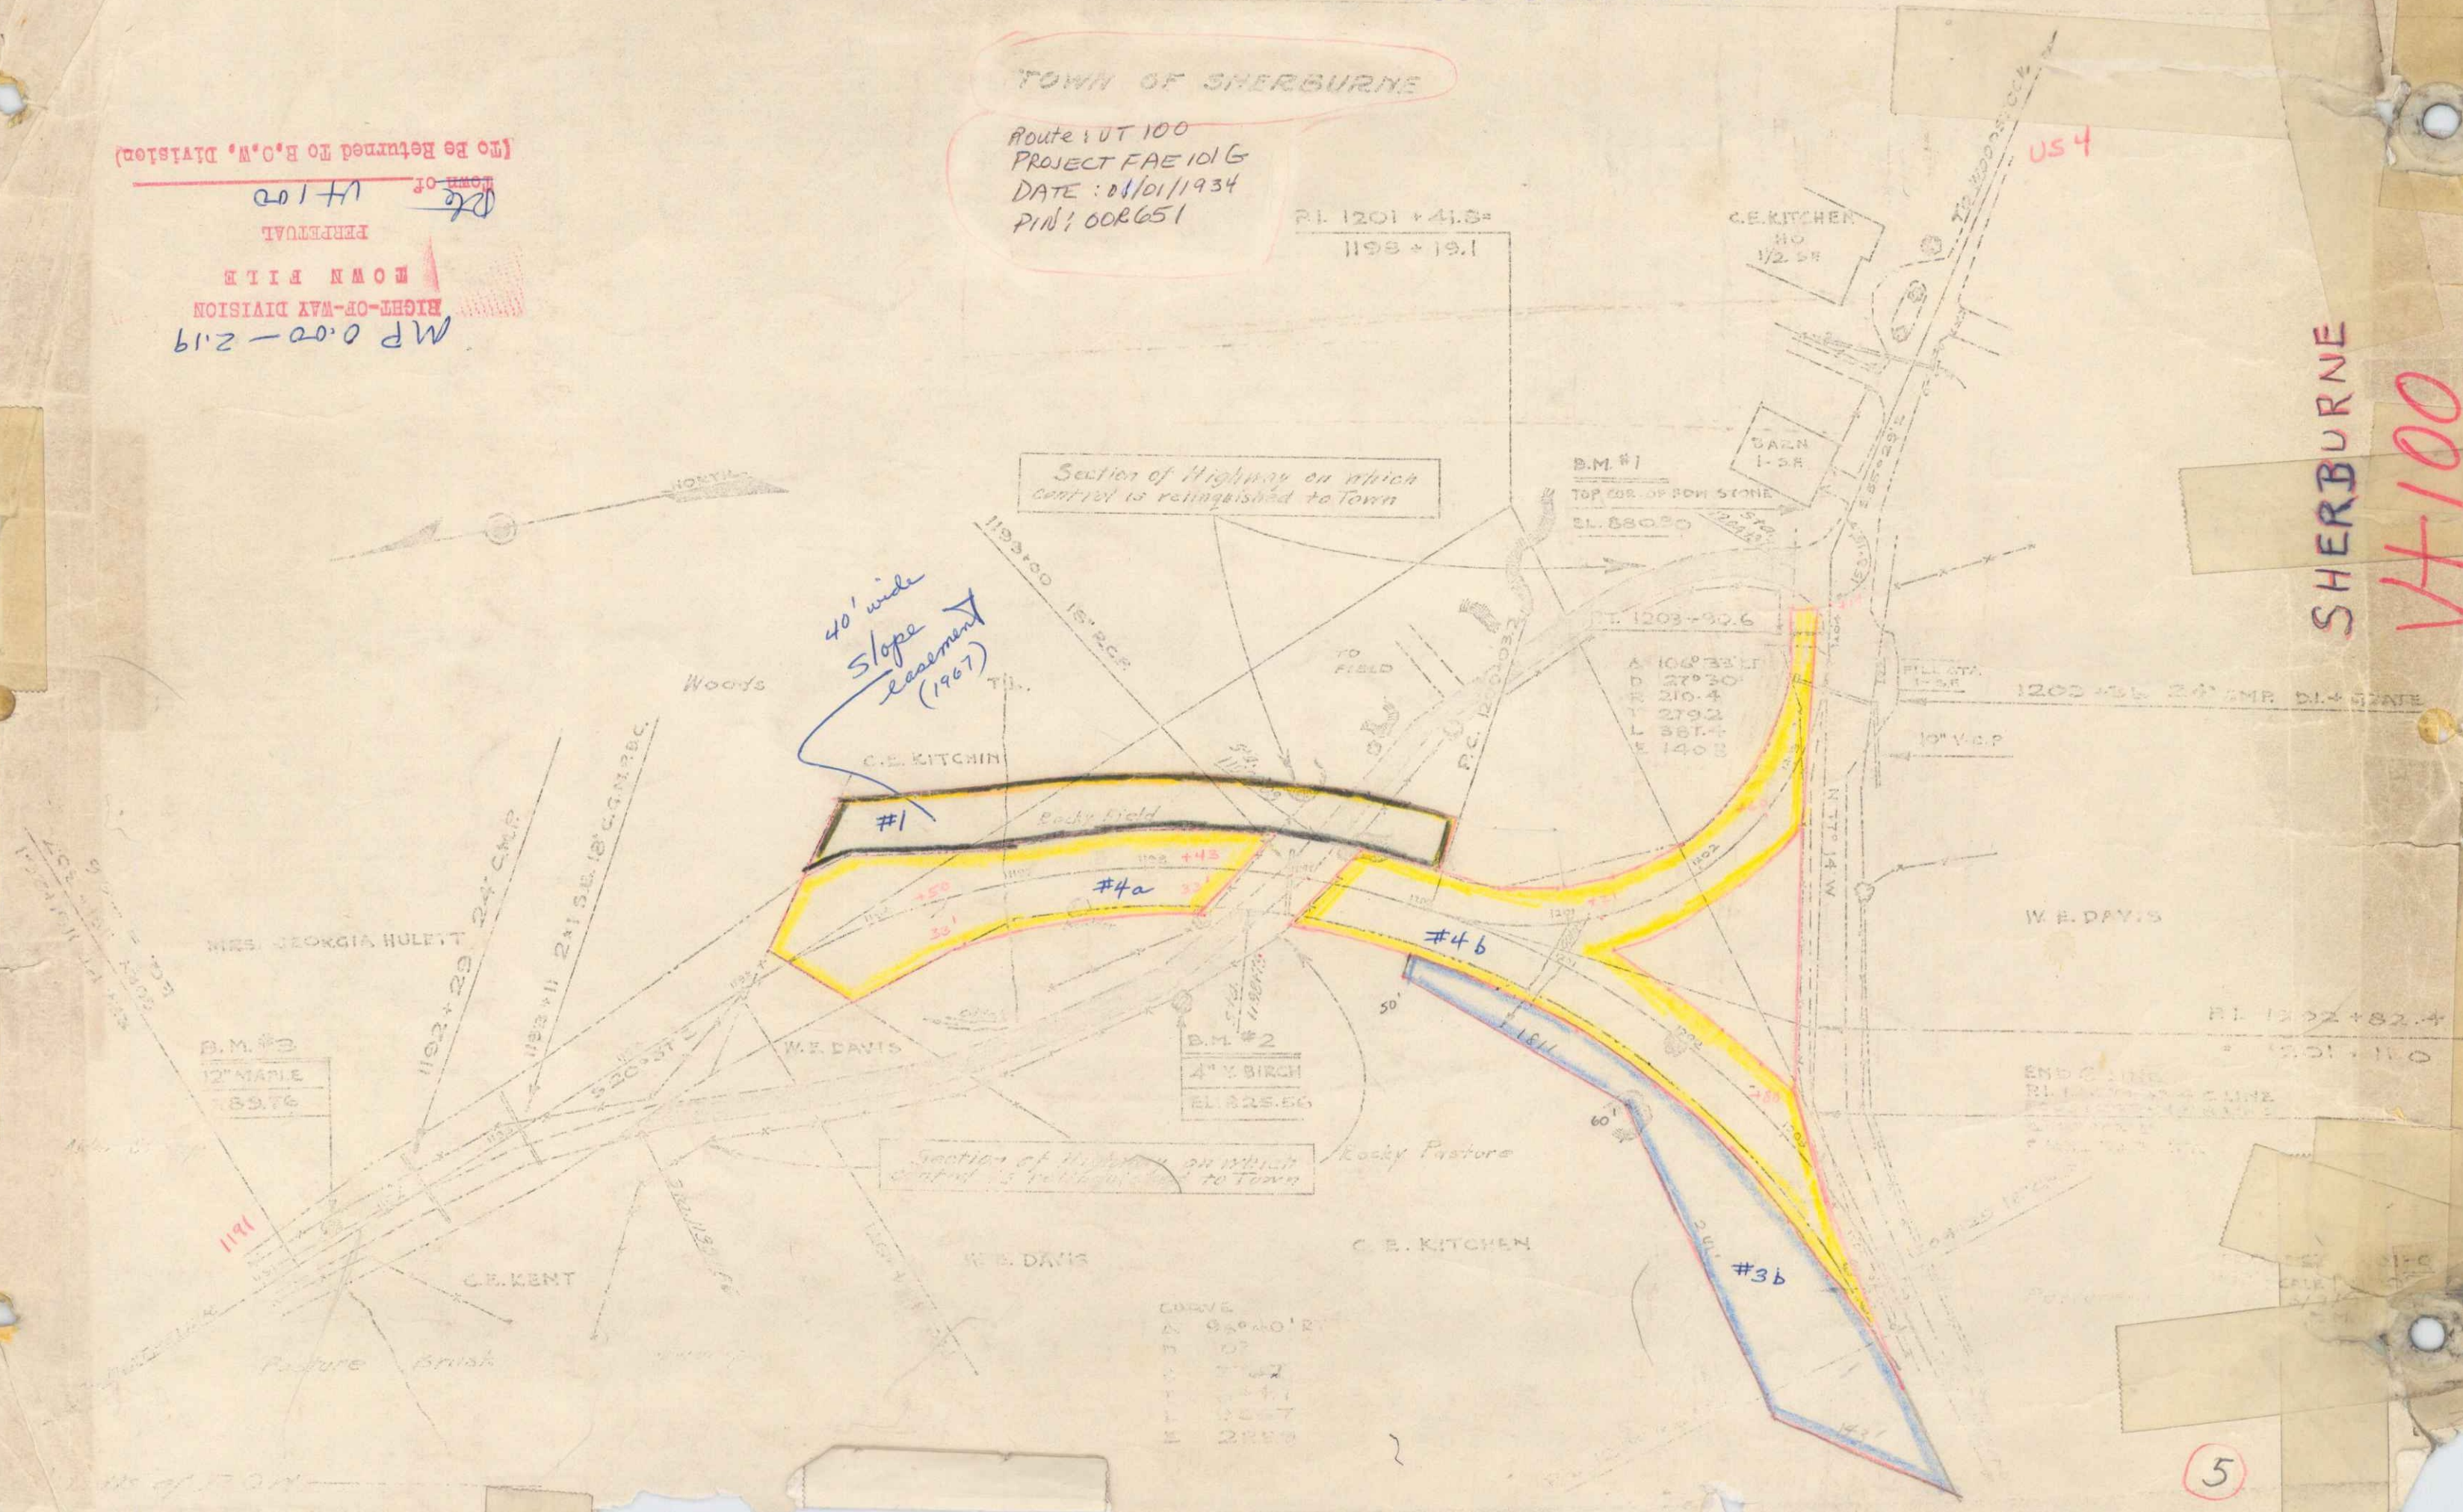

5
3