




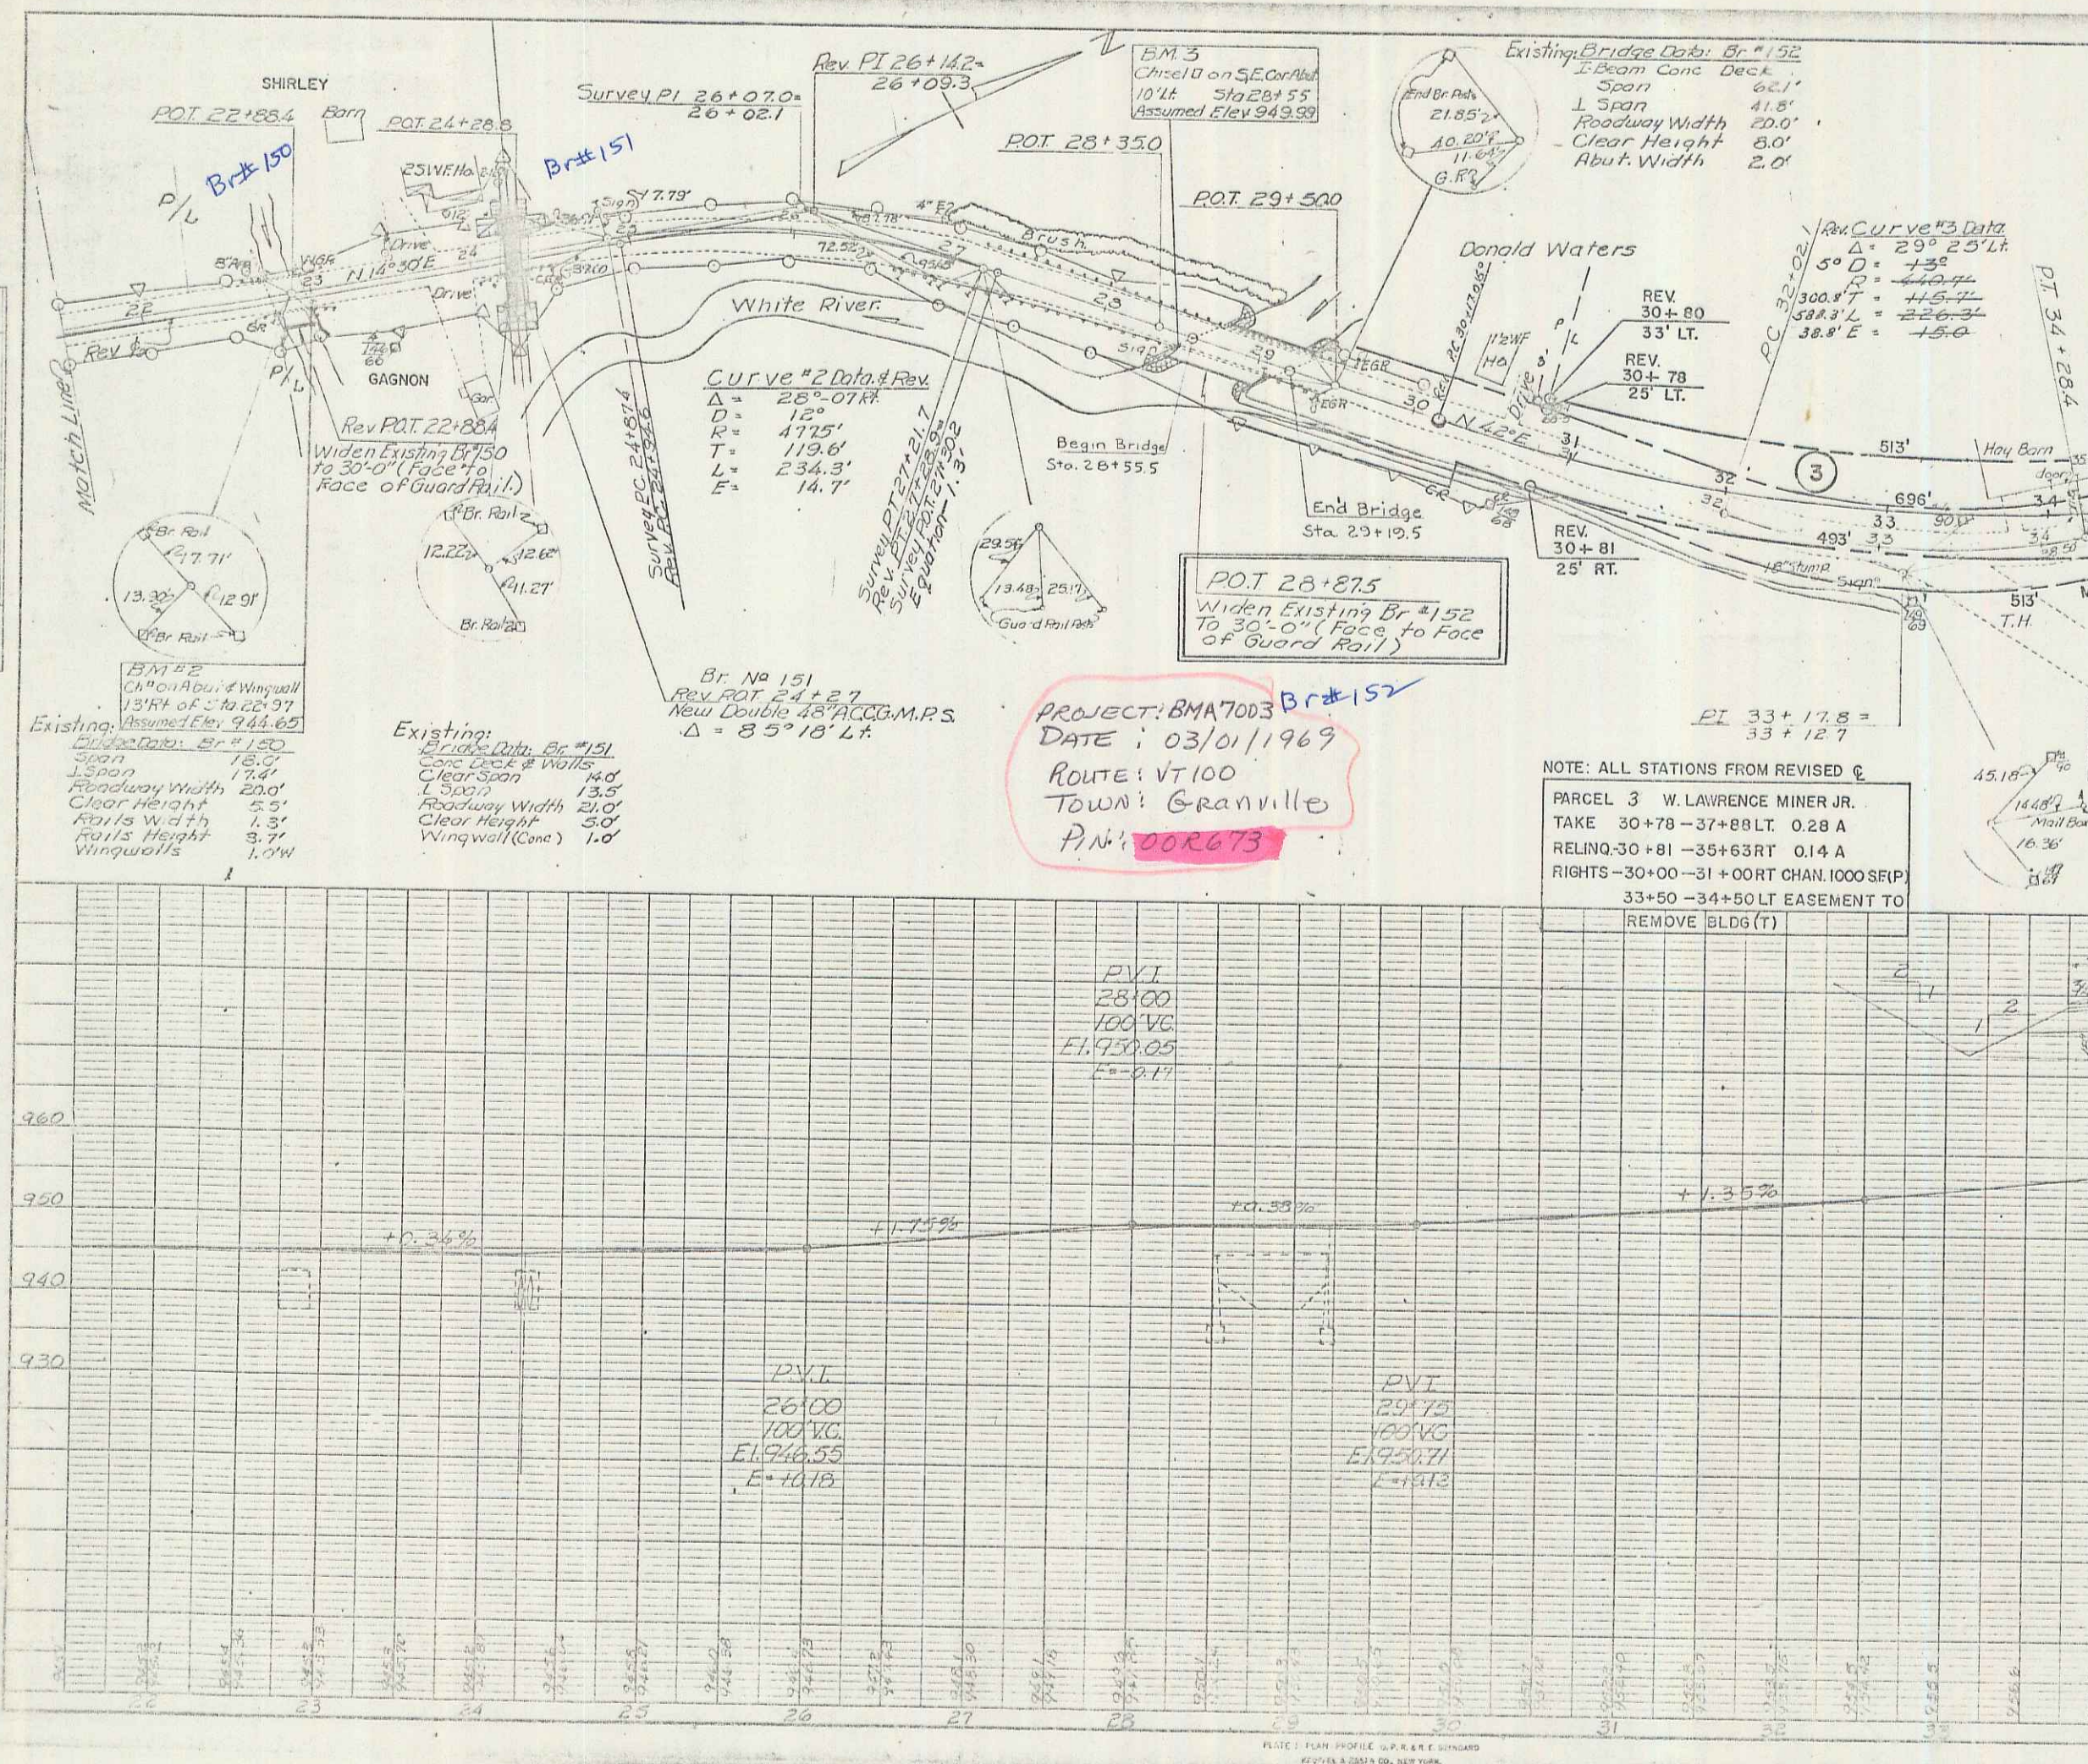

PROJECT: BMA7003 Br. #152
 DATE: 03/01/1969
 ROUTE: VT 100
 TOWN: GRANVILLE
 PIN: 000673

NOTE: ALL STATIONS FROM REVISED C
 PARCEL 3 W. LAWRENCE MINER JR.
 TAKE 30+78-37+88 LT. 0.28 A
 RELINQ. 30+81-35+63 RT. 0.14 A
 RIGHTS-30+00-31+00 RT. CHAN. 1000 SEIP
 33+50-34+50 LT. EASEMENT TO
 REMOVE BLDG (T)