Parcel	Kind of Instrument	Date of Instrument	Grantor	Grantee	Recorded Granville Book	Page	Date	Remarks
A	Q.C.D.	5-19-36	Clarence Holden	St. of Vt.	19	100	5-29-36	

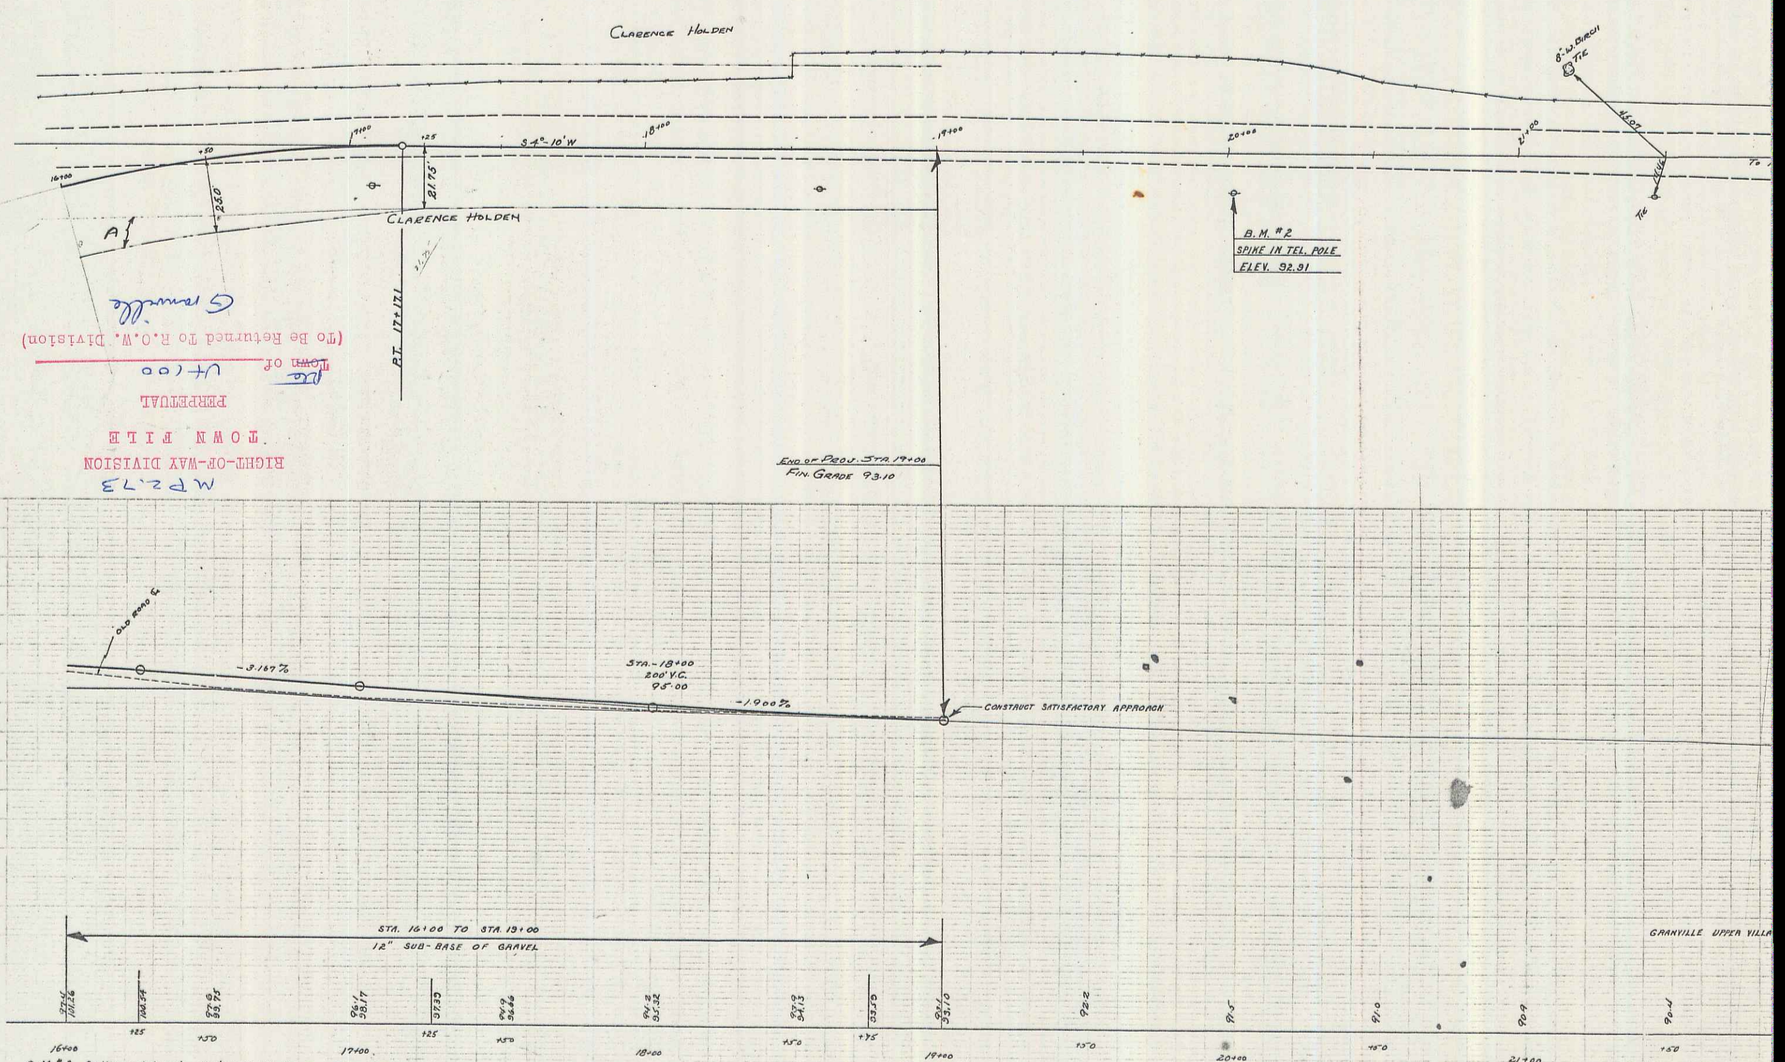

MP2.73
RIGHT-OF-WAY DIVISION
"TOWN FILE
PERPETUAL
~~Dec~~ Town of Vt 100
(To Be Returned To R.O.W. Division)
Granville

2