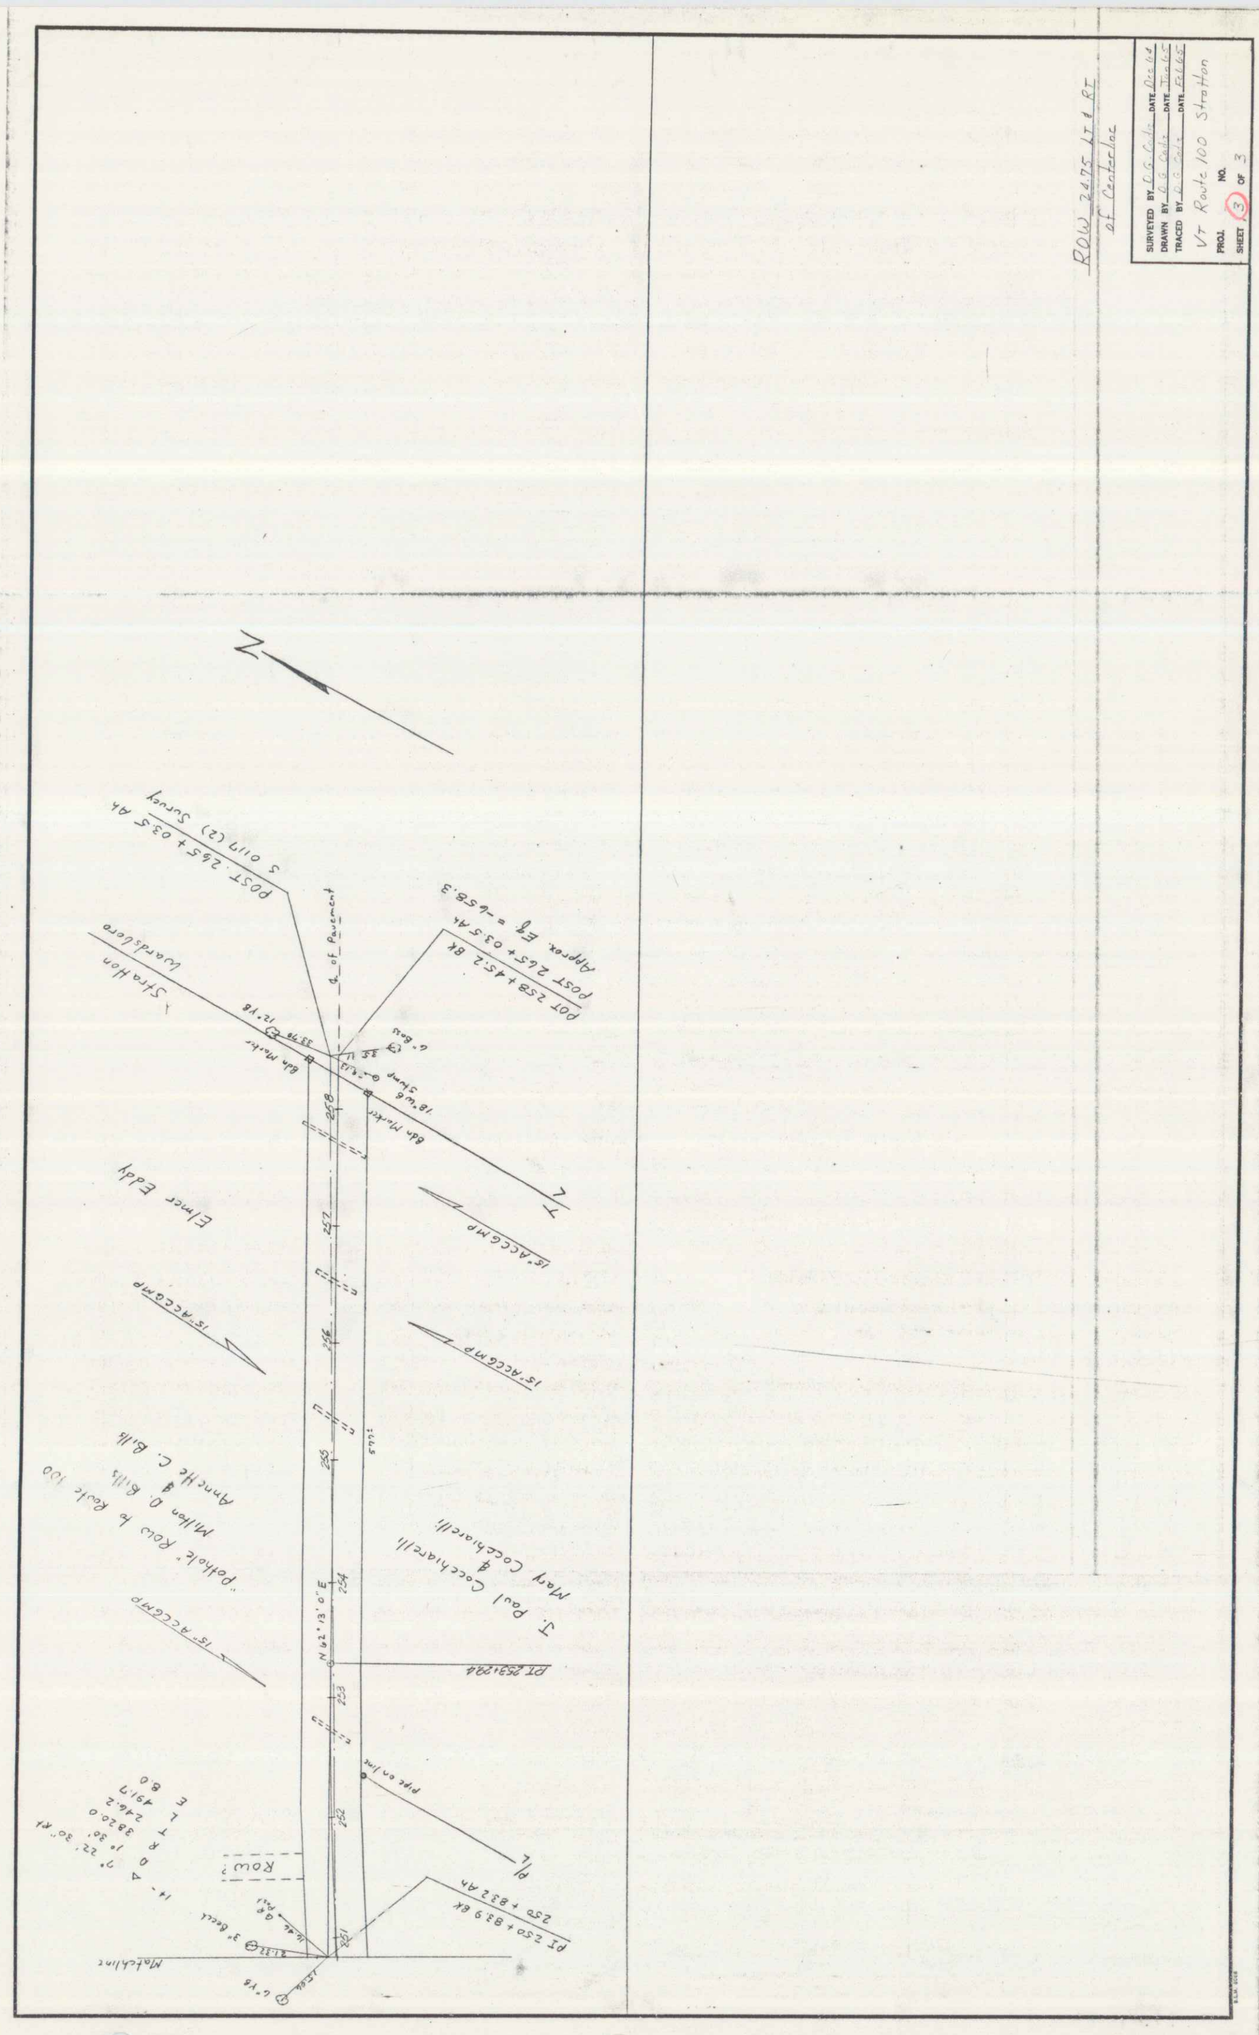

ROW 24.75 Lt & Rt
of Centerline

SURVEYED BY [illegible] DATE [illegible]
DRAWN BY [illegible] DATE [illegible]
TRACED BY [illegible] DATE [illegible]

VT Route 100 Stratton

PROJ. NO.
SHEET 3 OF 3

3