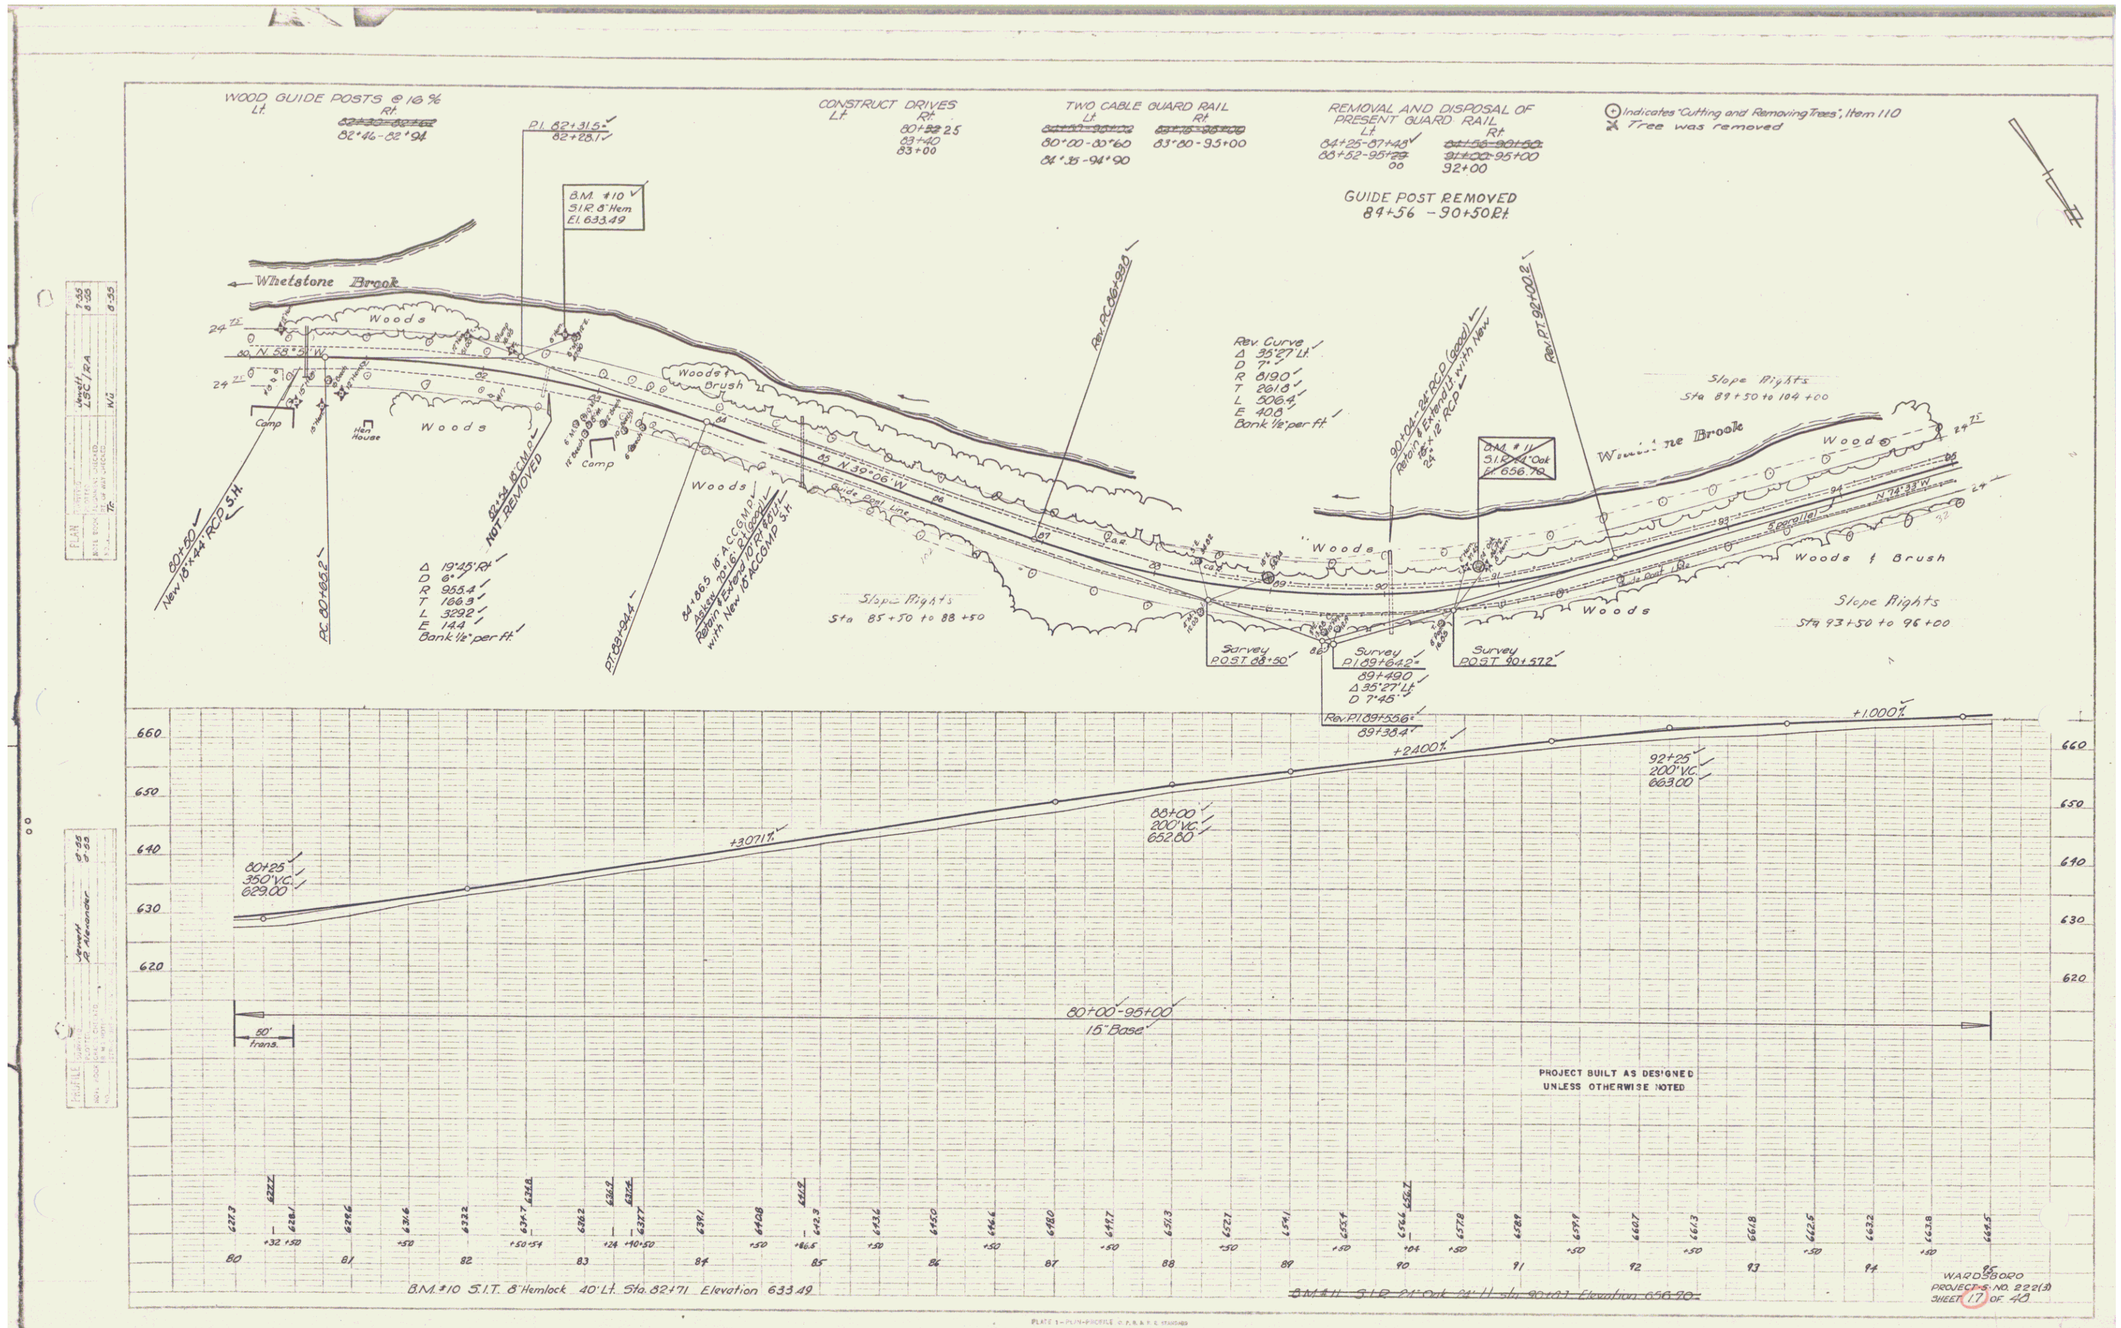
WOOD GUIDE POSTS @ 16 % Lt. Rt.
82+46-82+94
CONSTRUCT DRIVES Lt. Rt.
80+25
83+40
83+00
TWO CABLE GUARD RAIL Lt. Rt.
80+00-80+60
84+35-94+90
83+80-95+00
REMOVAL AND DISPOSAL OF PRESENT GUARD RAIL Lt. Rt.
84+25-87+48
88+52-95+00
92+00
Indicates "Cutting and Removing Trees", Item 110
Tree was removed
GUIDE POST REMOVED
84+56 - 90+50 Rt.
P.I. 82+31.5
82+28.1
B.M. #10
S.I.R. 8" Hem
El. 633.49
Whetstone Brook
Woods
Woods & Brush
Camp
Hen House
N 58°-30' W
N 39°-06' W
N 44°-33' W
Guide Post Line
Rev. PC 86+98.1
Rev. PT 92+02.2
Rev. Curve
Δ 35°27' Lt.
D 7°
R 819.0'
T 261.8'
L 506.4'
E 40.9
Bank 1/2" per ft.
90+04 - 24" RCP (Good) Nylon & Extend Lt. with New 24" x 18' RCP
B.M. #11
S.I.R. 21" Oak
El. 656.70
Slope Rights
Sta 89+50 to 104+00
Slope Rights
Sta 85+50 to 88+50
Slope Rights
Sta 93+50 to 96+00
Parallel
60+50
New 18" x 44' RCP S.H.
PC 80+86.2
82+54 RCMP NOT REMOVED
Δ 19°45' Rt.
D 6°
R 955.4'
T 166.9'
L 329.2'
E 14.4'
Bank 1/2" per ft.
PT 88+34.4
84+86.5 18" ACCMP
Remove 20+16 of Culvert
Return & Extend 10+16 Left with New 18" ACCMP S.H.
Survey POST 88+50
Survey P.I. 89+64.2
89+49.0
Δ 35°27' Lt.
D 7°45'
Survey POST 90+57.2
Rev. P.I. 89+55.6
89+38.4
+3071%
+2400%
+1000%
80+25
350' VC.
629.00
88+00
200' VC.
652.00
92+25
200' VC.
663.00
80+00-95+00
15" Base
50' trans.
PROJECT BUILT AS DESIGNED UNLESS OTHERWISE NOTED
B.M. #10 S.I.T. 8" Hemlock 40' Lt. Sta. 82+71 Elevation 633.49
~~B.M. #11 S.I.R. 21" Oak 24' Lt. Sta. 90+03 Elevation 656.70~~
WARDSBORO
PROJECT NO. 222(3)
SHEET 17 OF 40