


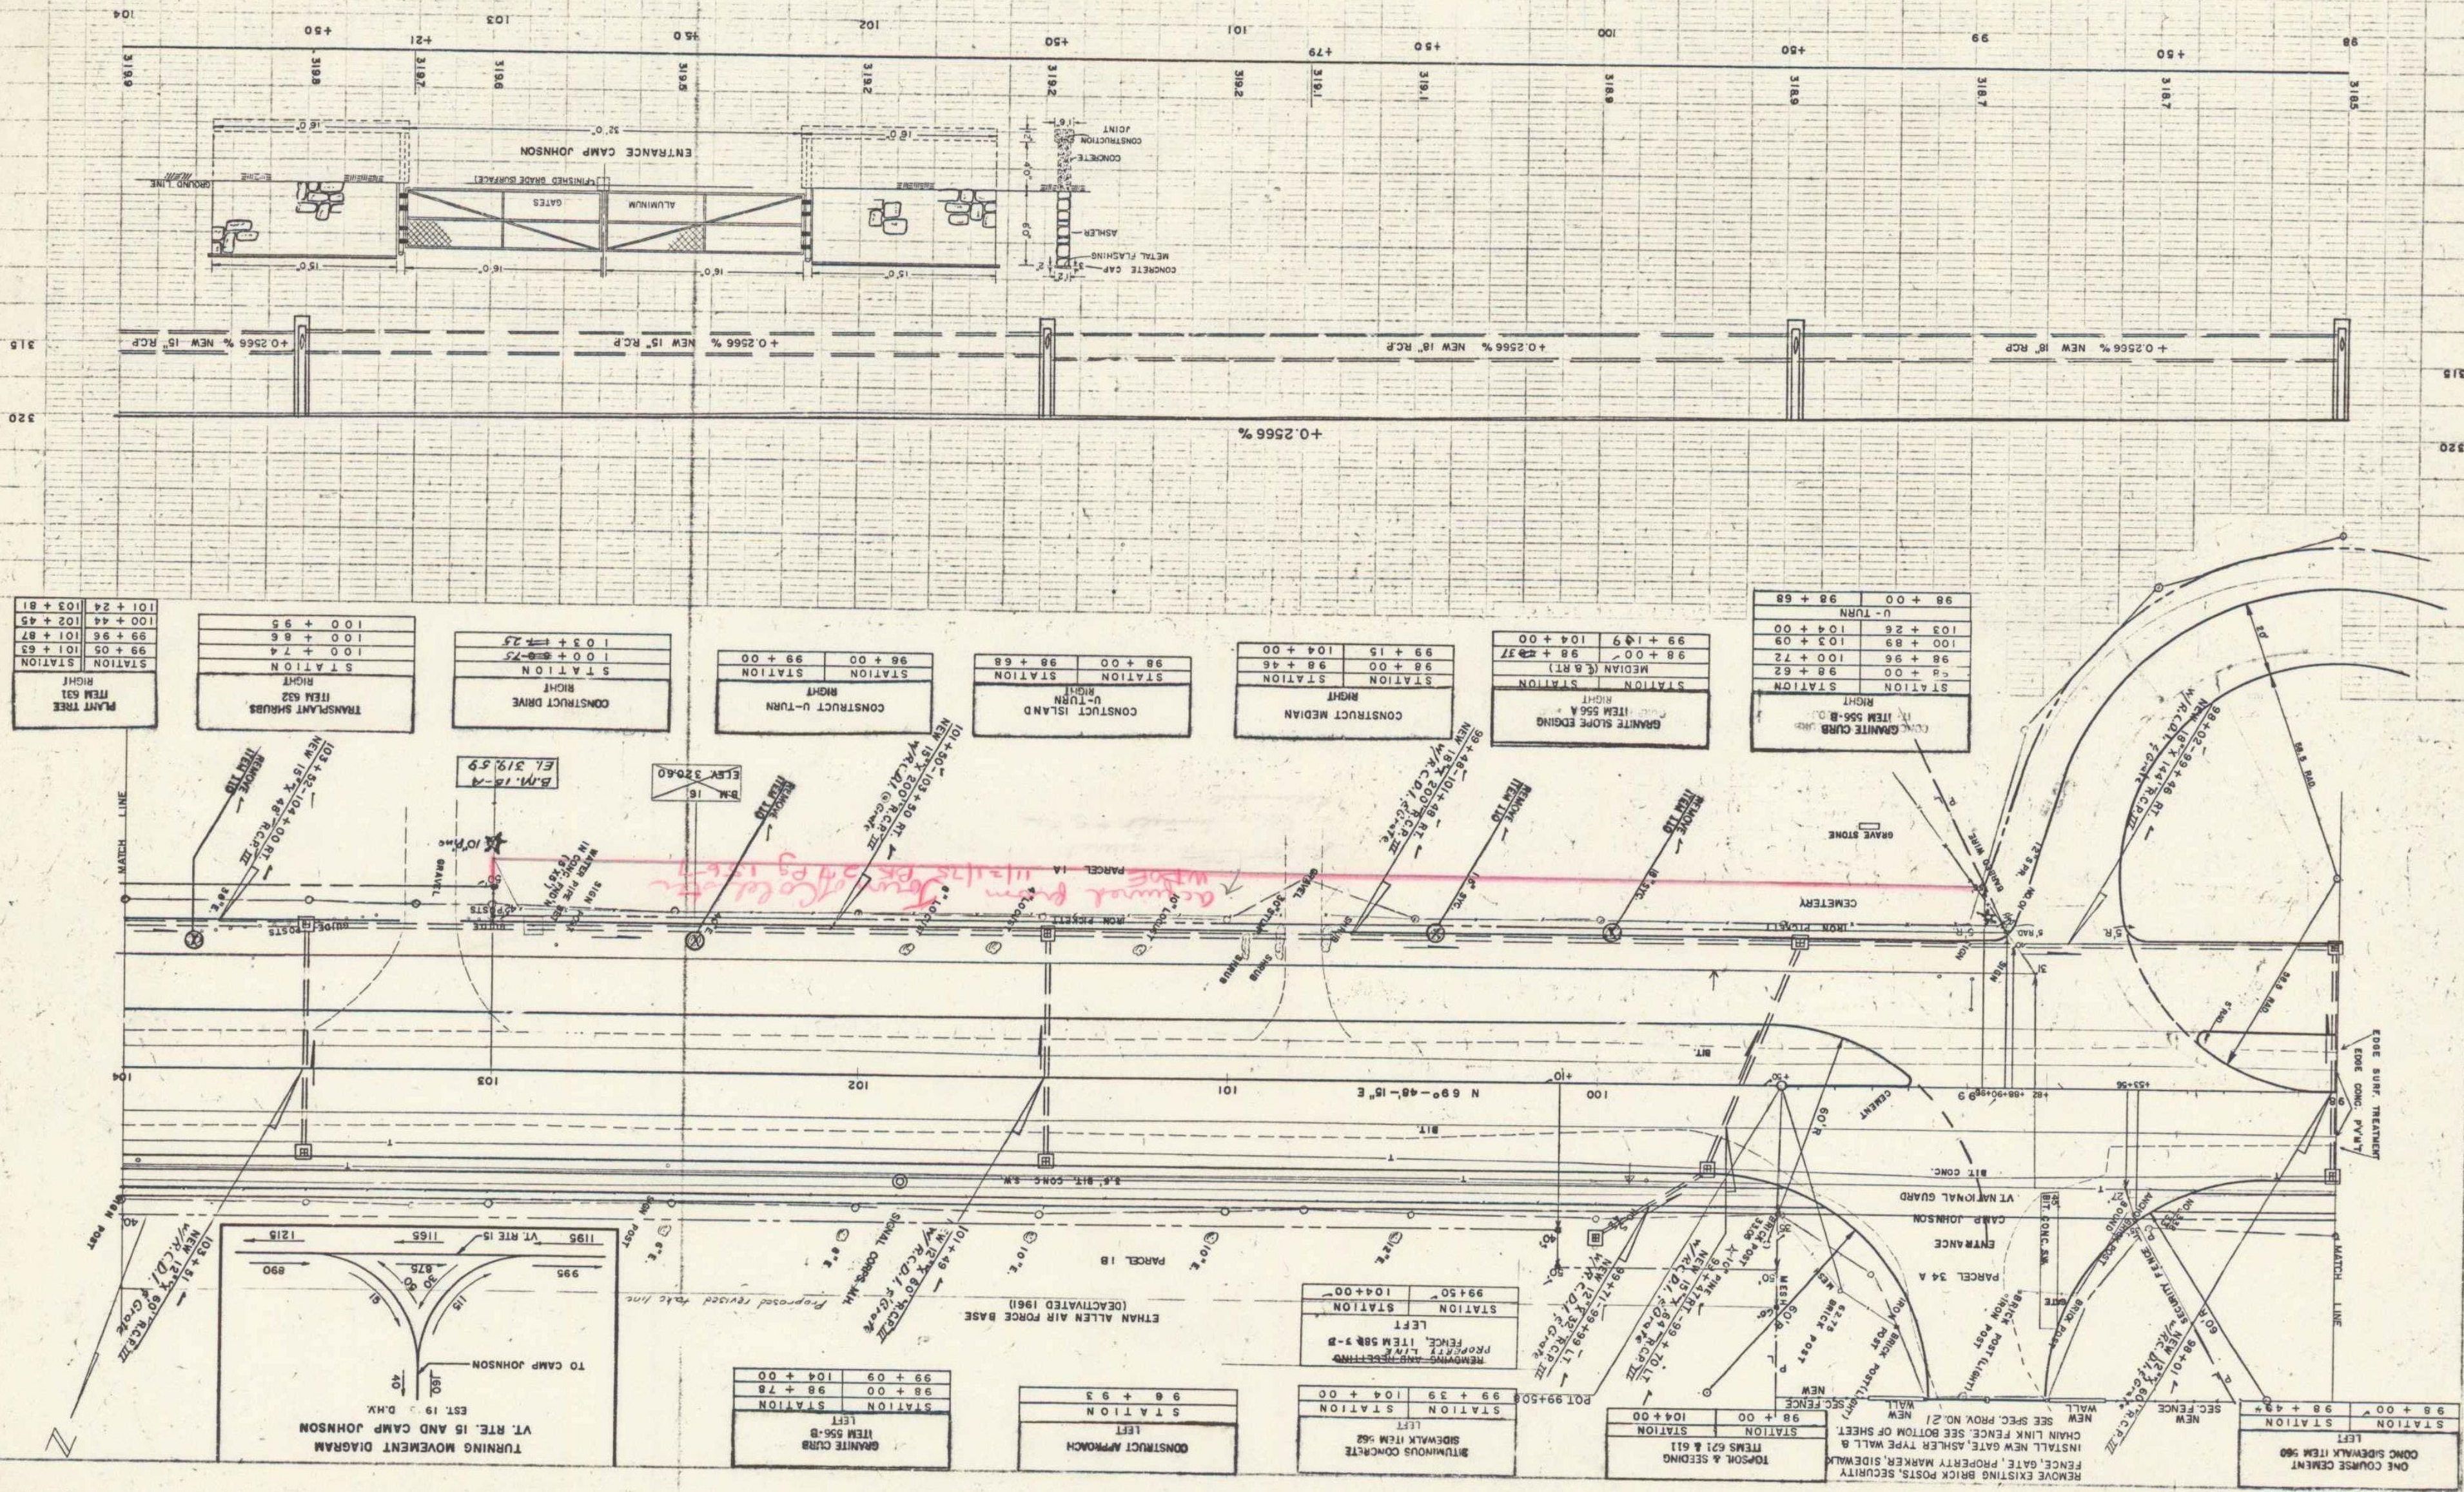

WESTER-MARTIN, INC.
7-57

PLAN
WESTER-MARTIN, INC.
7-57