

Ut. Route 15  
Appr. NM 0.39

| INDEX OF SHEETS |                                                 |
|-----------------|-------------------------------------------------|
| SHEET NO. 1     | TITLE PAGE                                      |
| " 2             | TYPICAL CROSS-SECTION OF IMPROVEMENT 24' GRAVEL |
| " 3-4           | PLAN AND PROFILE                                |
| " 5-6           | SUPERSTRUCTURE DETAILS                          |
| " 7             | SERIES S.B.NO.1                                 |
| " 8-9           | ABUTMENT DETAILS                                |
| " 10            | SERIES S.B.NO.2                                 |
| " 11            | " S.B.NO.2A                                     |
| " 12-13-14      | CROSS SECTIONS                                  |
| " 15            | S22 STANDARD STRUCTURES                         |

STATE OF VERMONT  
STATE HIGHWAY DEPARTMENT

PLAN AND PROFILE OF PROPOSED  
STATE HIGHWAY

FEDERAL AID PROJECT

TOWN OF JERICHO Pin#COR-714

JERICHO VILLAGE BRIDGE  
OVER BROWNS RIVER

LOCATED IN WEST END OF JERICHO VILLAGE  
ON THE CAMBRIDGE-ESSEX JCT. ROAD.


LENGTH 450.0 FEET-0.085 MILES

FOR LAYOUT SEE SHEETS NO.3+4

SCALES  
PLAN 20 FEET = 1 INCH  
PROFILE VERTICAL 20 FEET = 1 INCH  
HORIZONTAL 20 FEET = 1 INCH  
SECTIONS 5 FEET = 1 INCH

THIS PROJECT TO BE CONSTRUCTED IN ACCORDANCE  
WITH STANDARD SPECIFICATIONS ON FILE WITH THE  
U.S. BUREAU OF PUBLIC ROADS. APPROVED 7/7/26.

THESE PLANS ARE SUBJECT TO SUCH REVISIONS AS  
MAY BE REQUIRED BY THE BUREAU OF PUBLIC  
ROADS OR THE CHIEF ENGINEER.

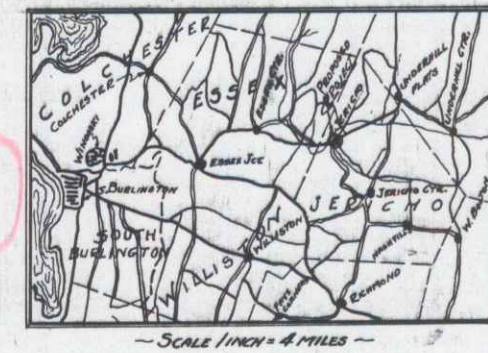

Project No. FAP 98B

BRIDGE NO. F.A.P. 98B  
DISTRICT NO. 8  
JERICHO, VT.

APPROVED May 3, 1929

CHIEF ENGINEER

SUBMITTED BY ORDER OF THE STATE HIGHWAY BOARD

COMMISSIONER OF HIGHWAYS

CONVENTIONAL SIGNS

COUNTY LINE  
TOWN LINE  
FENCE LINE  
STONE WALL  
UNFENCED PROPERTY  
GUARD RAIL  
TRAVELED WAY  
RAILROAD  
RETAINING WALL  
CENTER LINE  
SURVEY LINE  
CULVERT  
DROP INLET  
TROLLEY POLE  
POWER POLE  
TELEPHONE POLE  
TREE  
HEDGE

GROUND ELEVATION  
GRADE ELEVATION

CURVE DATA  
DEFLECTION ANGLE  
DEGREE OF CURVE  
RADIUS OF CURVE  
TANGENT DISTANCE  
LENGTH OF CURVE  
EXTERNAL DISTANCE  
POINT OF INTERSECTION  
POINT OF CURVE  
POINT OF TANGENT  
POINT ON TANGENT

RIGHT-OF-WAY DIVISION  
TOWN FILE

PERPETUAL

Town of JERICHO

(To Be Returned To R.O.W. Division)

Ut. Rte 15

00.39

F98B

RECOMMENDED

DISTRICT ENGINEER

BUREAU OF PUBLIC ROADS

RECOMMENDED FOR APPROVAL

CHIEF ENGINEER

BUREAU OF PUBLIC ROADS


APPROVED

DIRECTOR - BUREAU OF PUBLIC ROADS

SERIES F.A.P. NO. 98B FILED  
SHEET 1 OF 15



| DIST. NO. | STATE | PROJ. NO. | YEAR | NO. | SHEETS |
|-----------|-------|-----------|------|-----|--------|

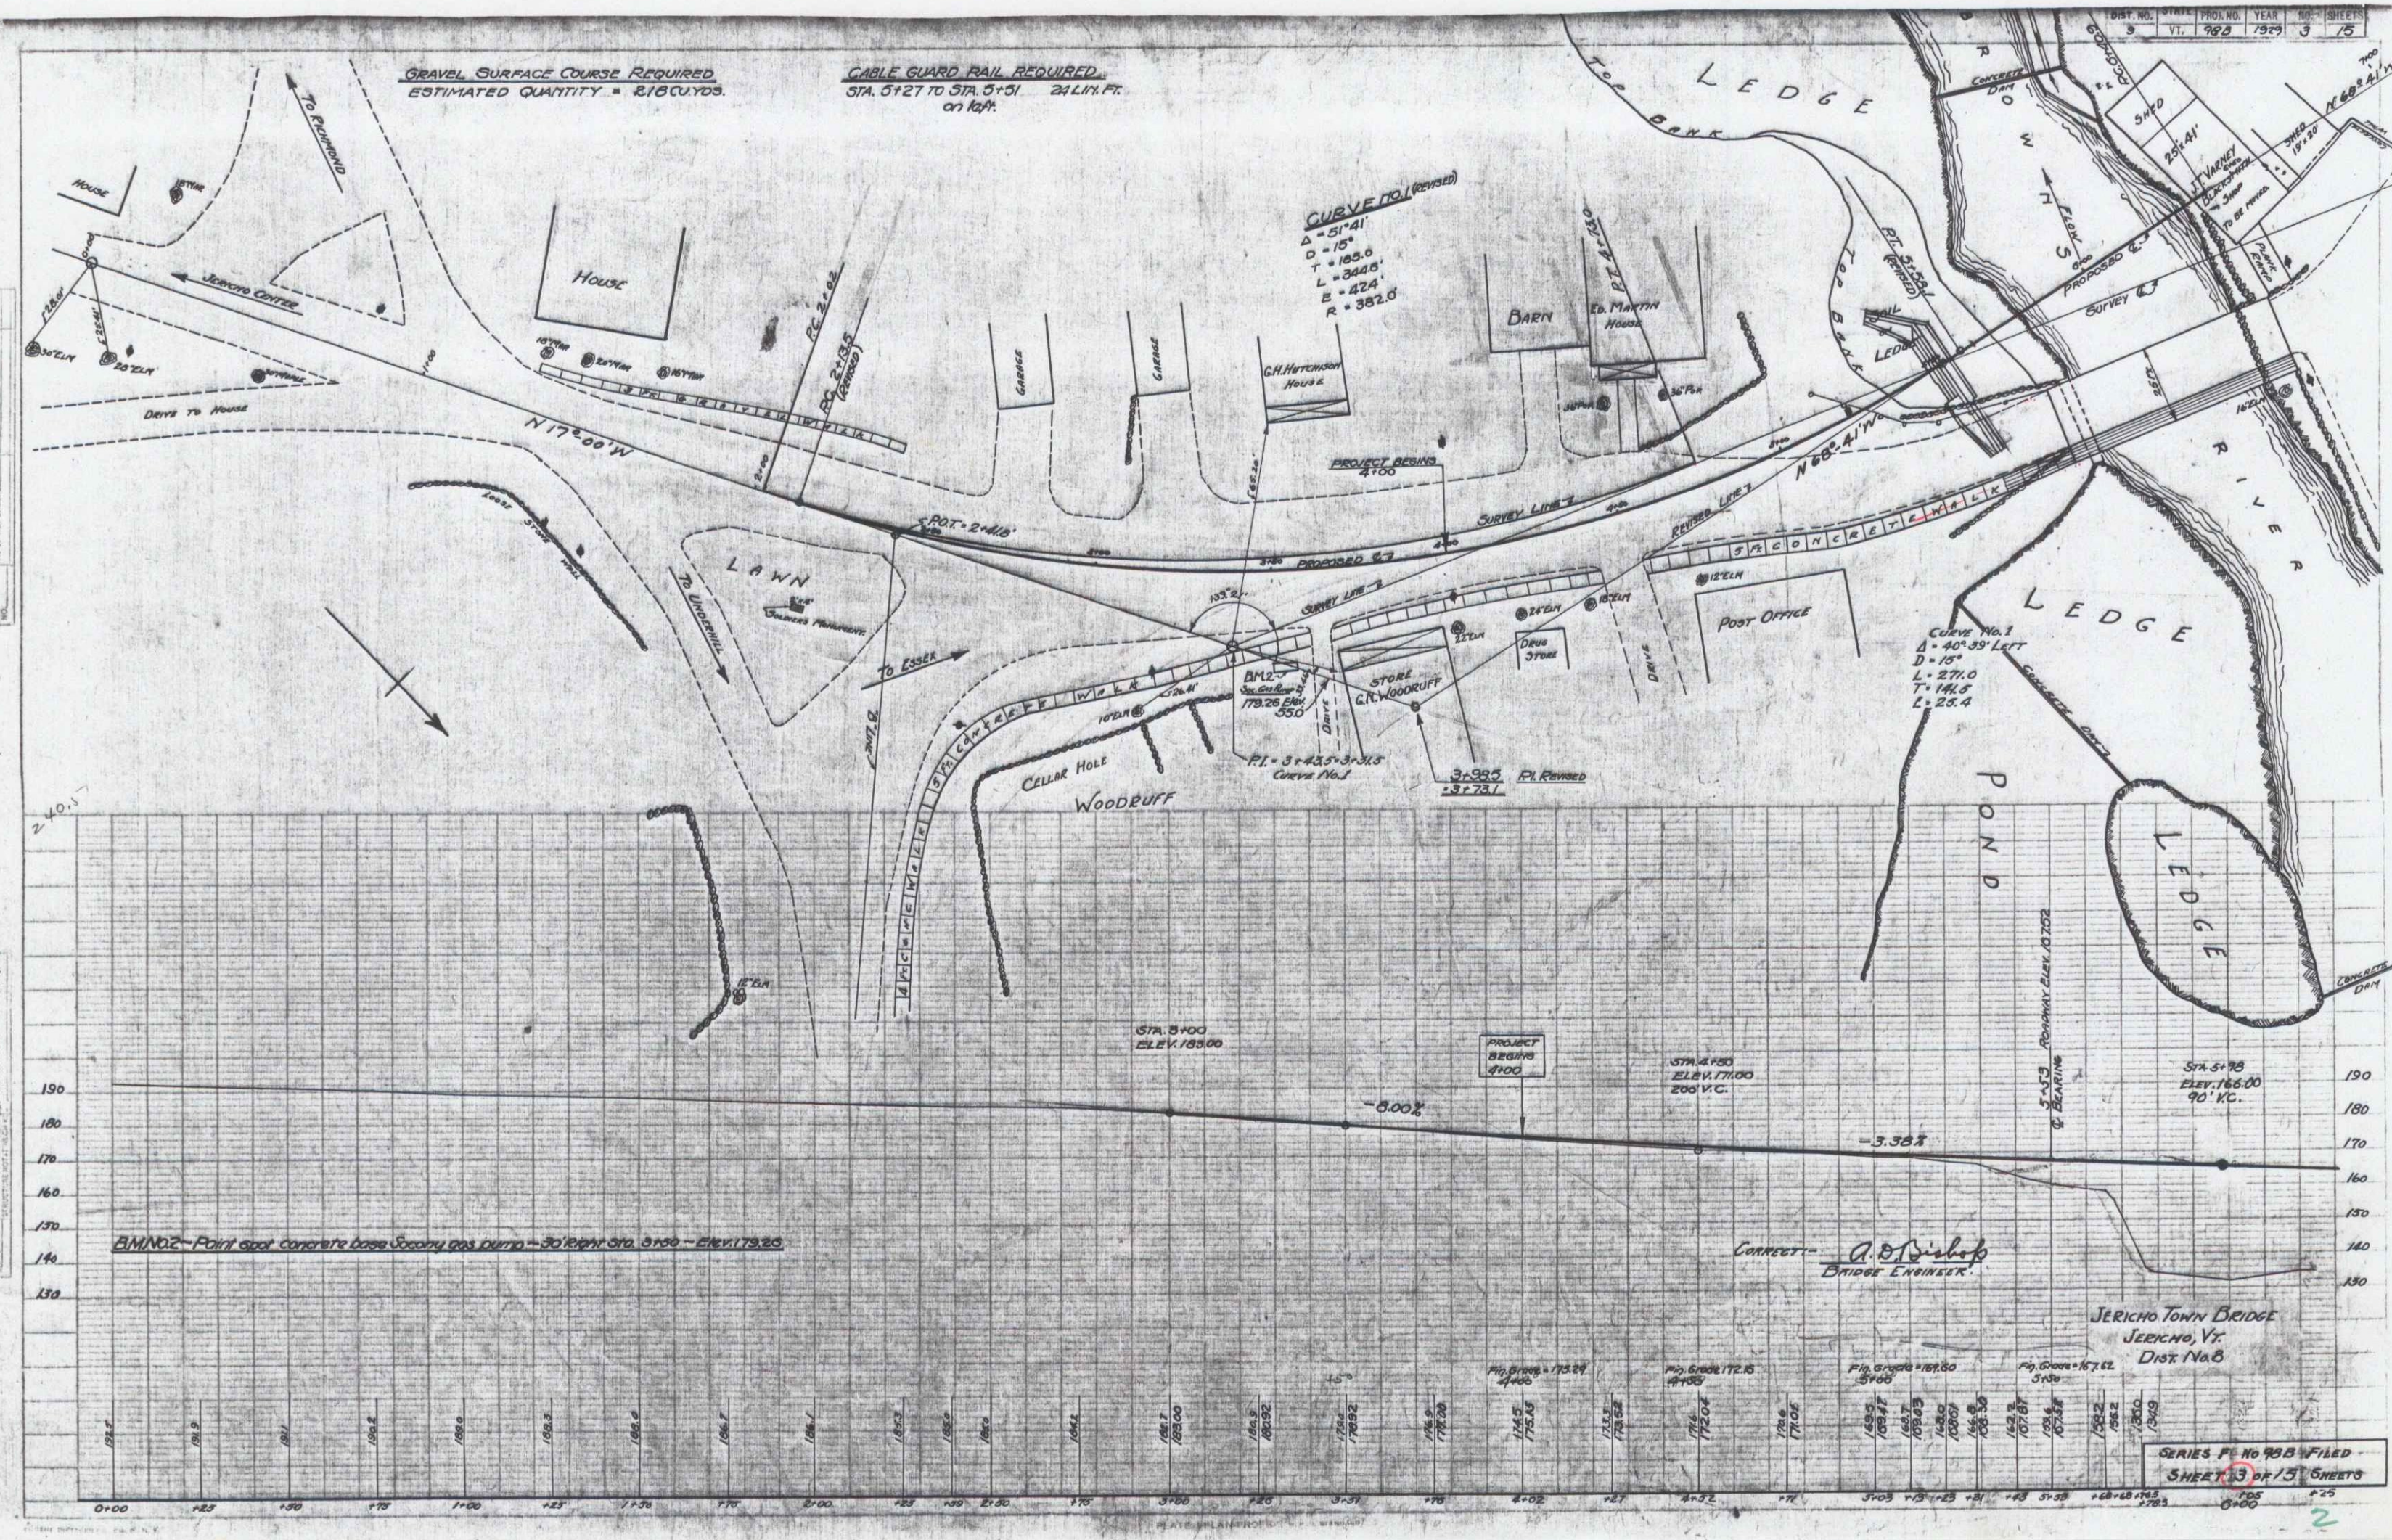

SHEET 3 OF 15 SHEETS



