

INDEX OF SHEETS		
SHEET NO.	1	TITLE PAGE
"	2	TYPICAL CROSS-SECTION OF IMPROVEMENT 2 1/2" CRUSHED GRAVEL MIXED IN PLACE SURFACE COURSE, WITH REFINED TAR, ITEMS 25 & 30
"	3	BANKING AND WIDENING TABLES

STATE OF VERMONT
STATE HIGHWAY DEPARTMENT

PLAN AND PROFILE OF PROPOSED
STATE HIGHWAY

FEDERAL AID PROJECT

TOWN OF SHARON Pin# 006738

VERMONT ROUTE 14

WHITE RIVER JUNCTION-ROYALTON ROAD

BEGINNING AT A POINT 664 FEET EAST OF THE INTERSECTION WITH THE TOWN ROAD TO POMFRET,
ACROSS THE WHITE RIVER, IN SHARON VILLAGE AND EXTENDING WESTERLY ON VT. ROUTE 14
0.681 MILES

LENGTH OF PROJECT: 3600 FEET=0.681 MILES

FED. ROAD DIST. NO.	STATE	FED. AID PROJ. NO.	FISCAL YEAR	SHEET NO.	TOTAL SHEETS
9	VT.	94B(2)	1942	1	3



SCALE: 1"=1 MILE

Documentation shows
MP 6.439-7.461

RIGHT-OF-WAY DIVISION
TOWN FILE

PERPETUAL


Rte
Town of U14
(To Be Returned To R.O.W. Division)

APPROVED: JUNE 23, 1941


SUBMITTED BY ORDER OF THE STATE HIGHWAY BOARD

Project No. SN-FAP 94B(2)

RECOMMENDED FOR APPROVAL

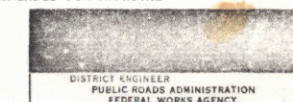

APPROVED

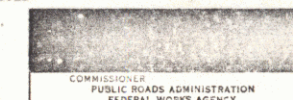


THESE PLANS ARE SUBJECT TO SUCH REVISIONS AS MAY BE REQUIRED BY THE PUBLIC ROADS ADMINISTRATION OR THE COMMISSIONER OF HIGHWAYS.
CONSTRUCTION IS TO BE CARRIED ON IN ACCORDANCE WITH THE PLANS AND THE STANDARD ROAD AND BRIDGE SPECIFICATIONS OF 1936, AS APPROVED DECEMBER 29TH, 1936 BY THE PUBLIC ROADS ADMINISTRATION, INCLUDING ALL SUBSEQUENT APPROVED REVISIONS AND SUCH REVISED SPECIFICATIONS AND SPECIAL PROVISIONS AS ARE SUBMITTED WITH THE PLANS.

APPROVED: June 19, 1941
ROAD ENGINEER

APPROVED: 6-17-41
DISTRICT HIGHWAY COMMISSIONER

SERIES FAP No. 94B(2) FILED
SHEET 1 OF

DIST. # 4 PLANS

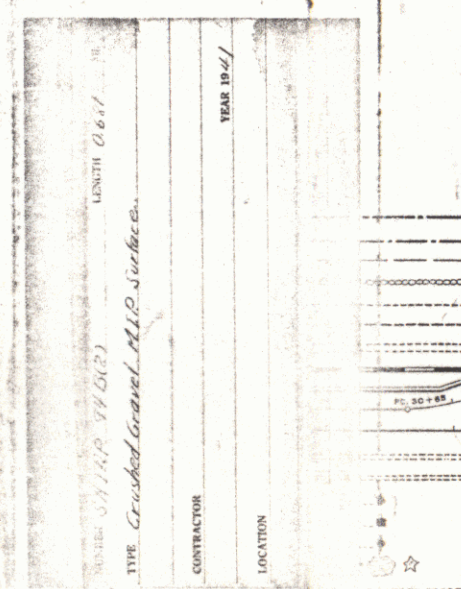


GROUND ELEVATION	DATUM	LINE
GRADE ELEVATION	DATUM	LINE

CURVE DATA	
DEFLECTION ANGLE	Δ
DEGREE OF CURVE	D
RADIUS OF CURVE	R
TANGENT DISTANCE	T
LENGTH OF CURVE	L
EXTERNAL DISTANCE	E
POINT OF INTERSECTION	P. I.
POINT OF CURVE	P. C.
POINT OF TANGENT	P. T.
POINT ON TANGENT	P. O. T.

SCALES	
TITLE	1"=300'
TYPICAL	1"=2'
PLAN	1"=
PROFILE HORIZONTAL	1"=
PROFILE VERTICAL	1"=
CROSS SECTIONS	1"=

PLAN	11-40	11-40
NOTES	11-40	11-40

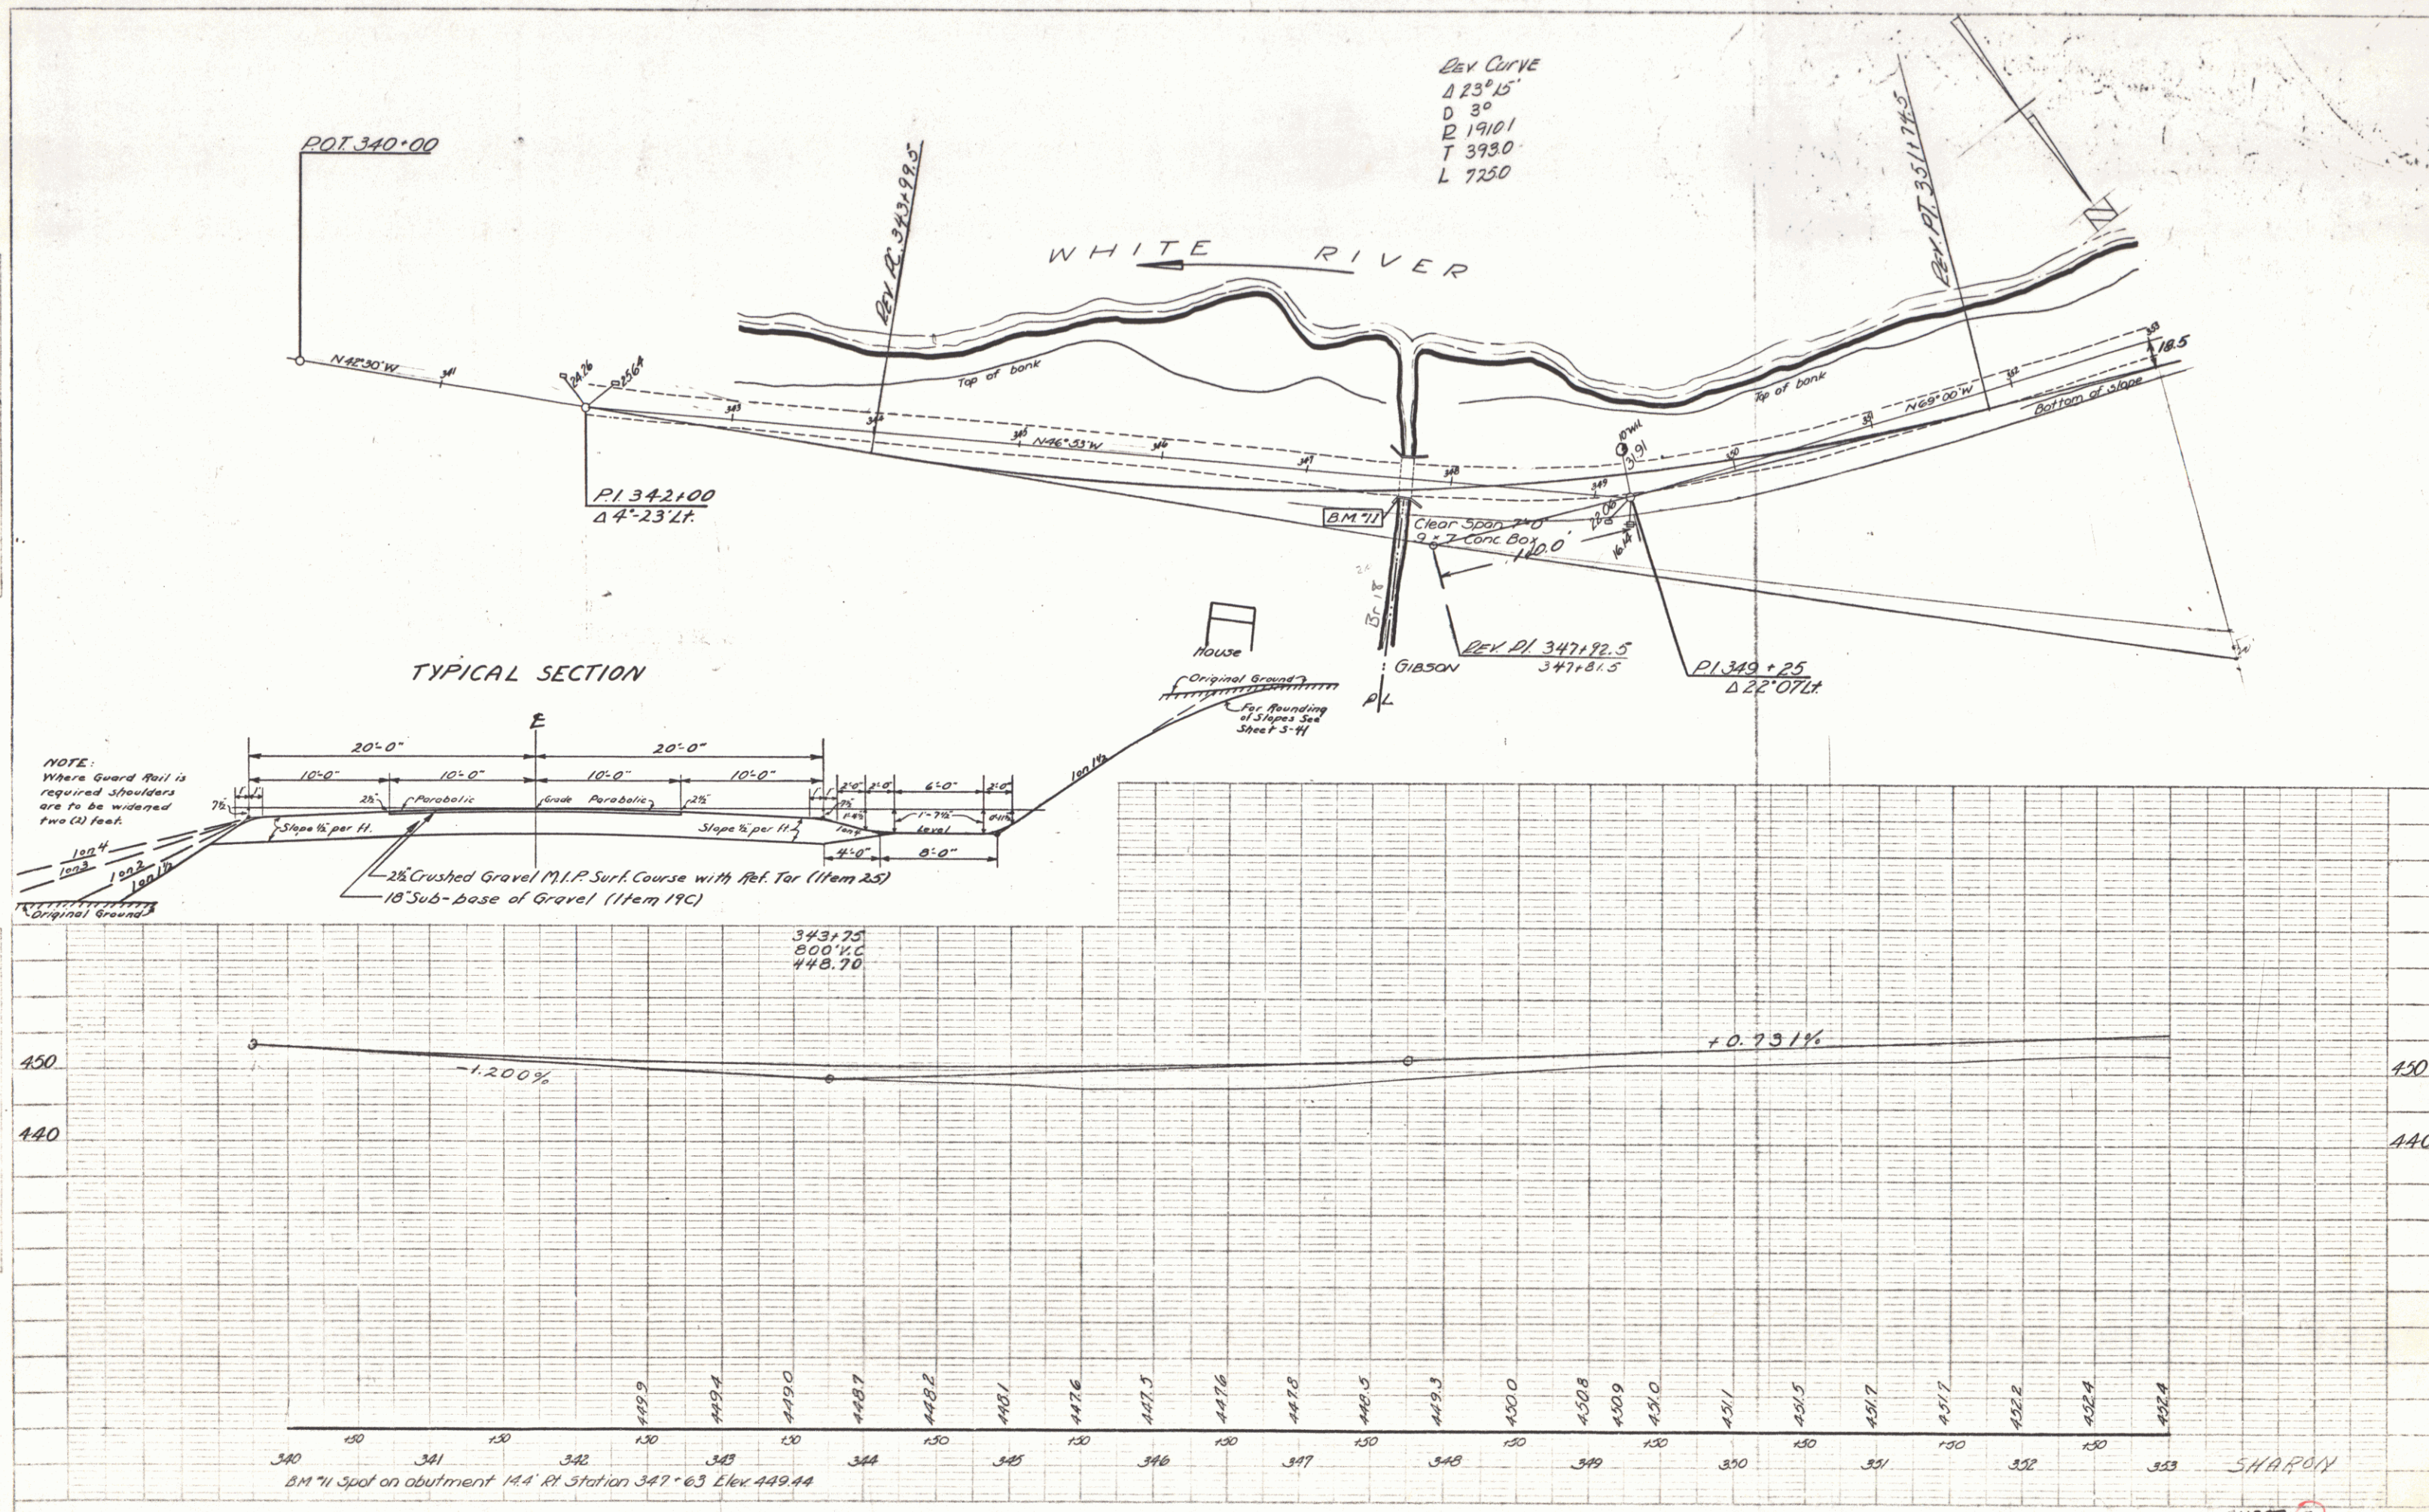

SHEET 5


PLAN
 DATE 11-40
 BY [Signature]
 CHECKED [Signature]
 REVISIONS

PROFILE
 DATE 11-40
 BY [Signature]
 CHECKED [Signature]
 REVISIONS

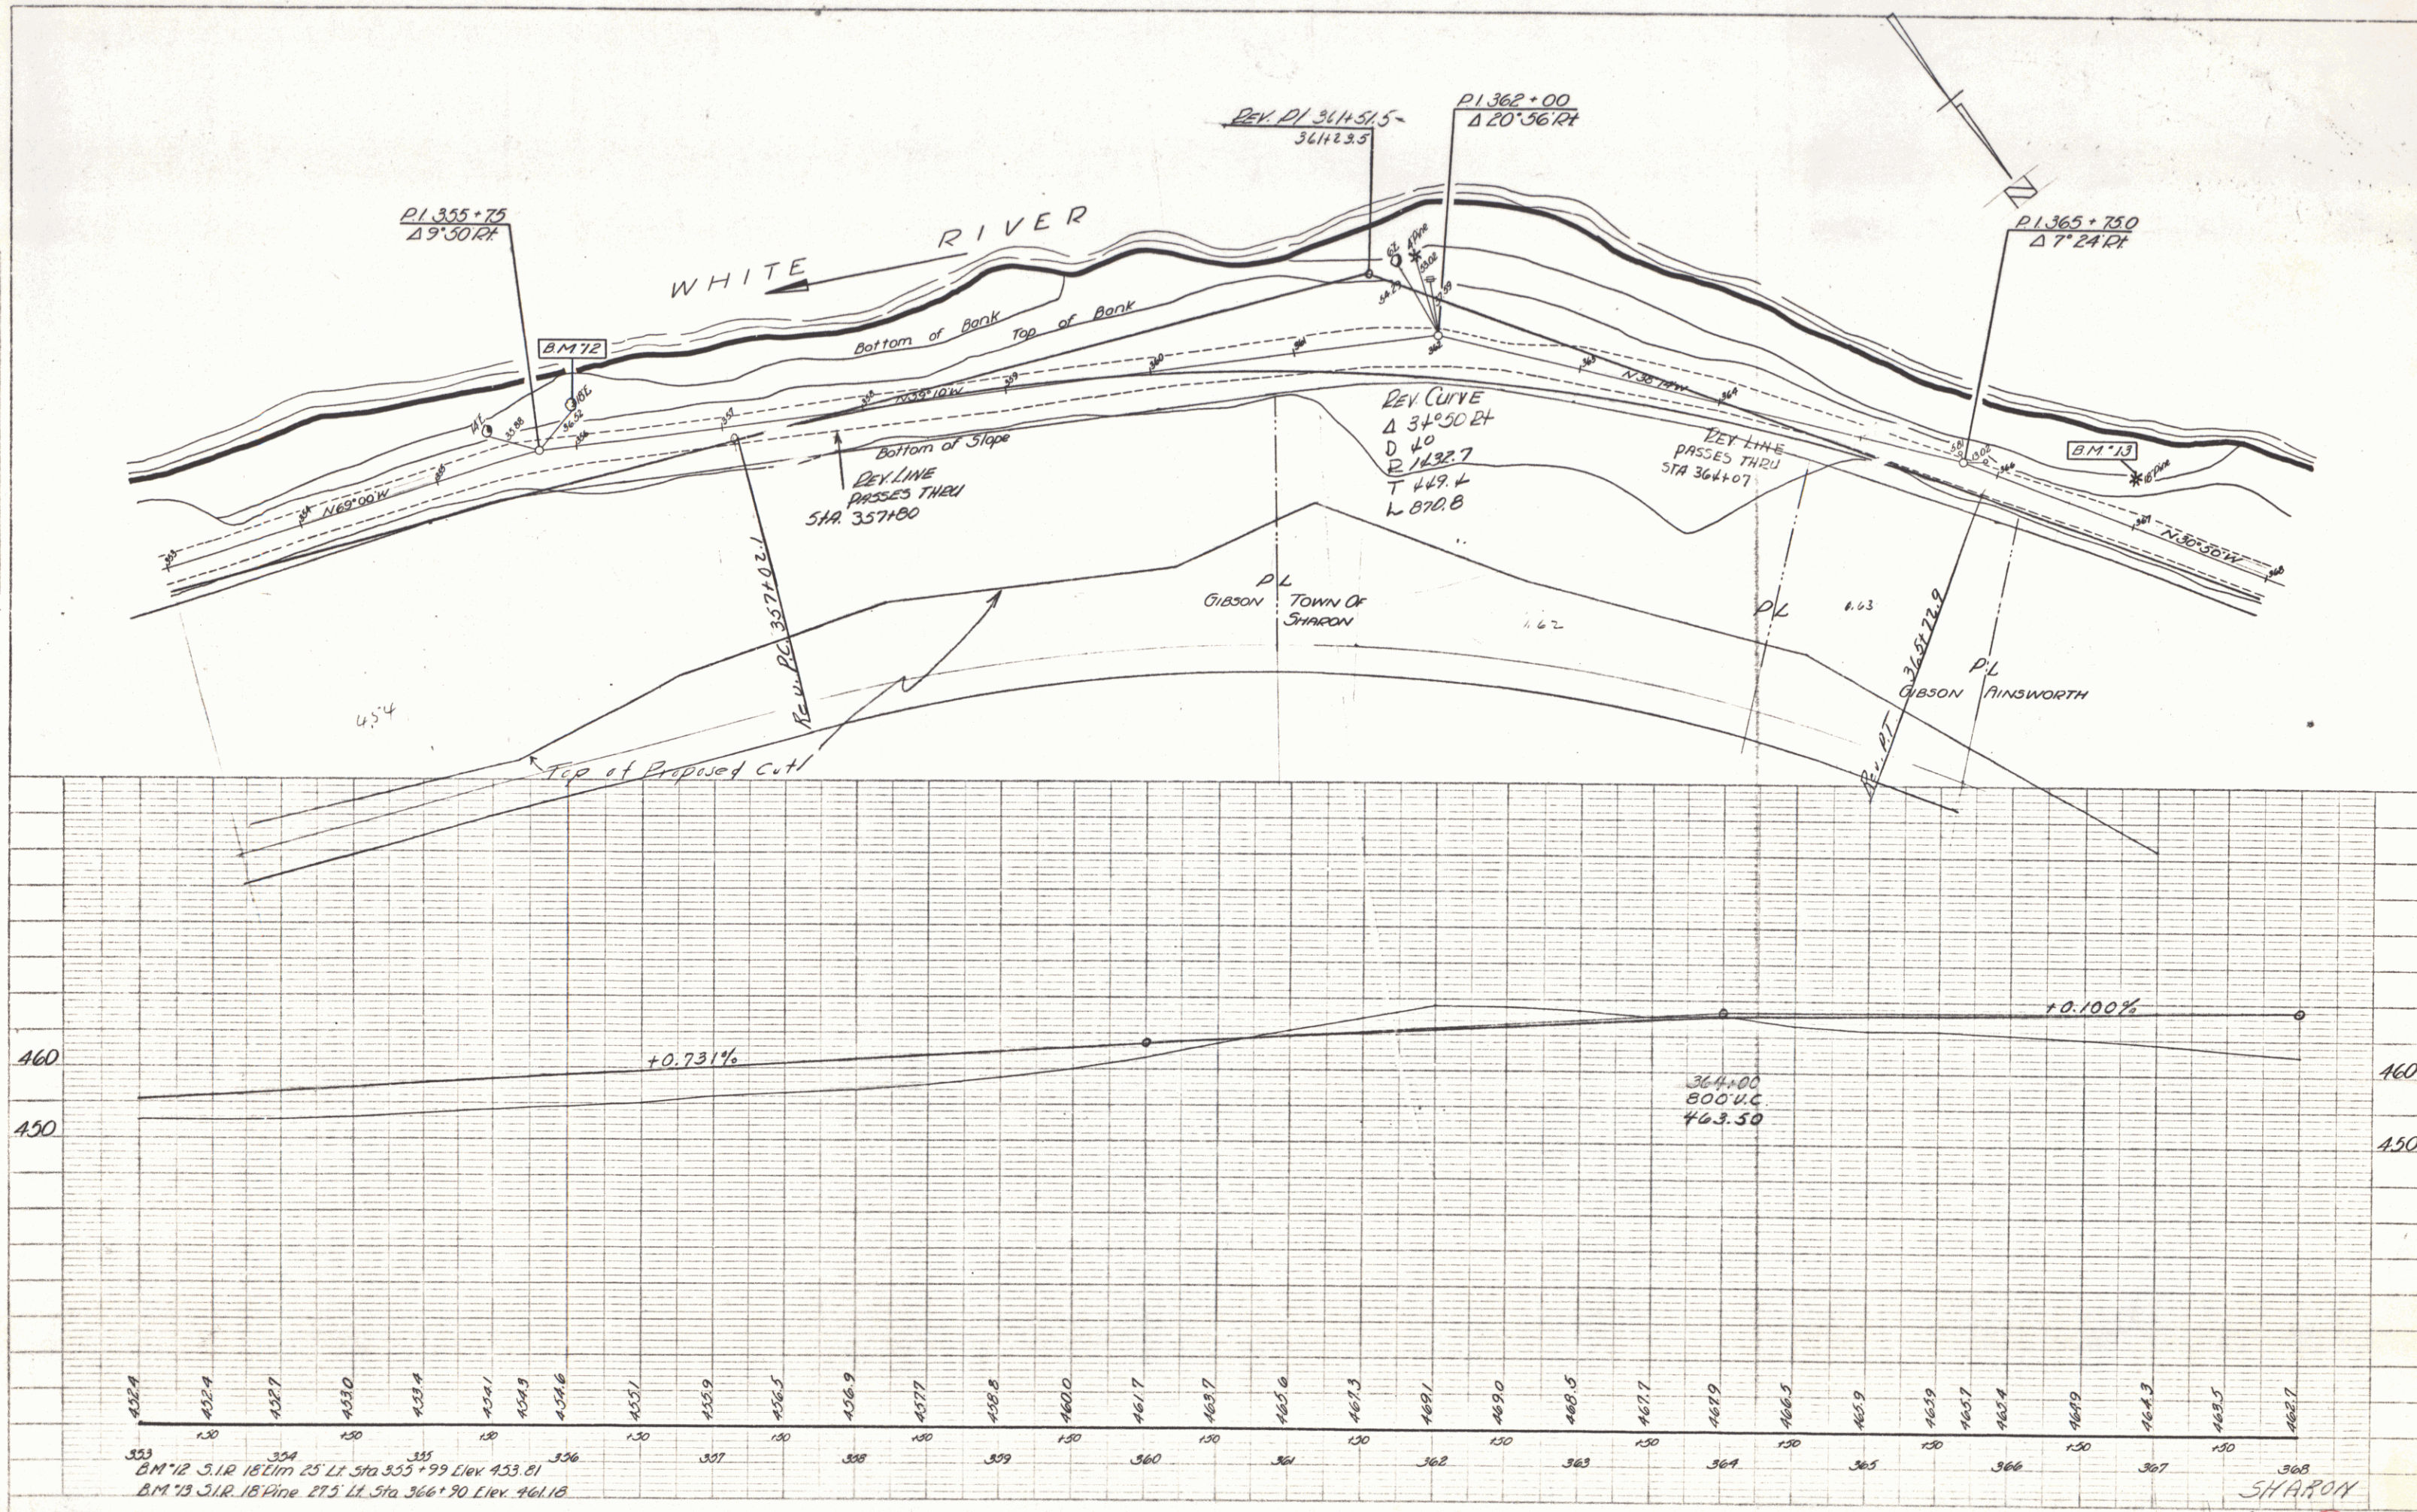

SHARON
 SHEET 6

3

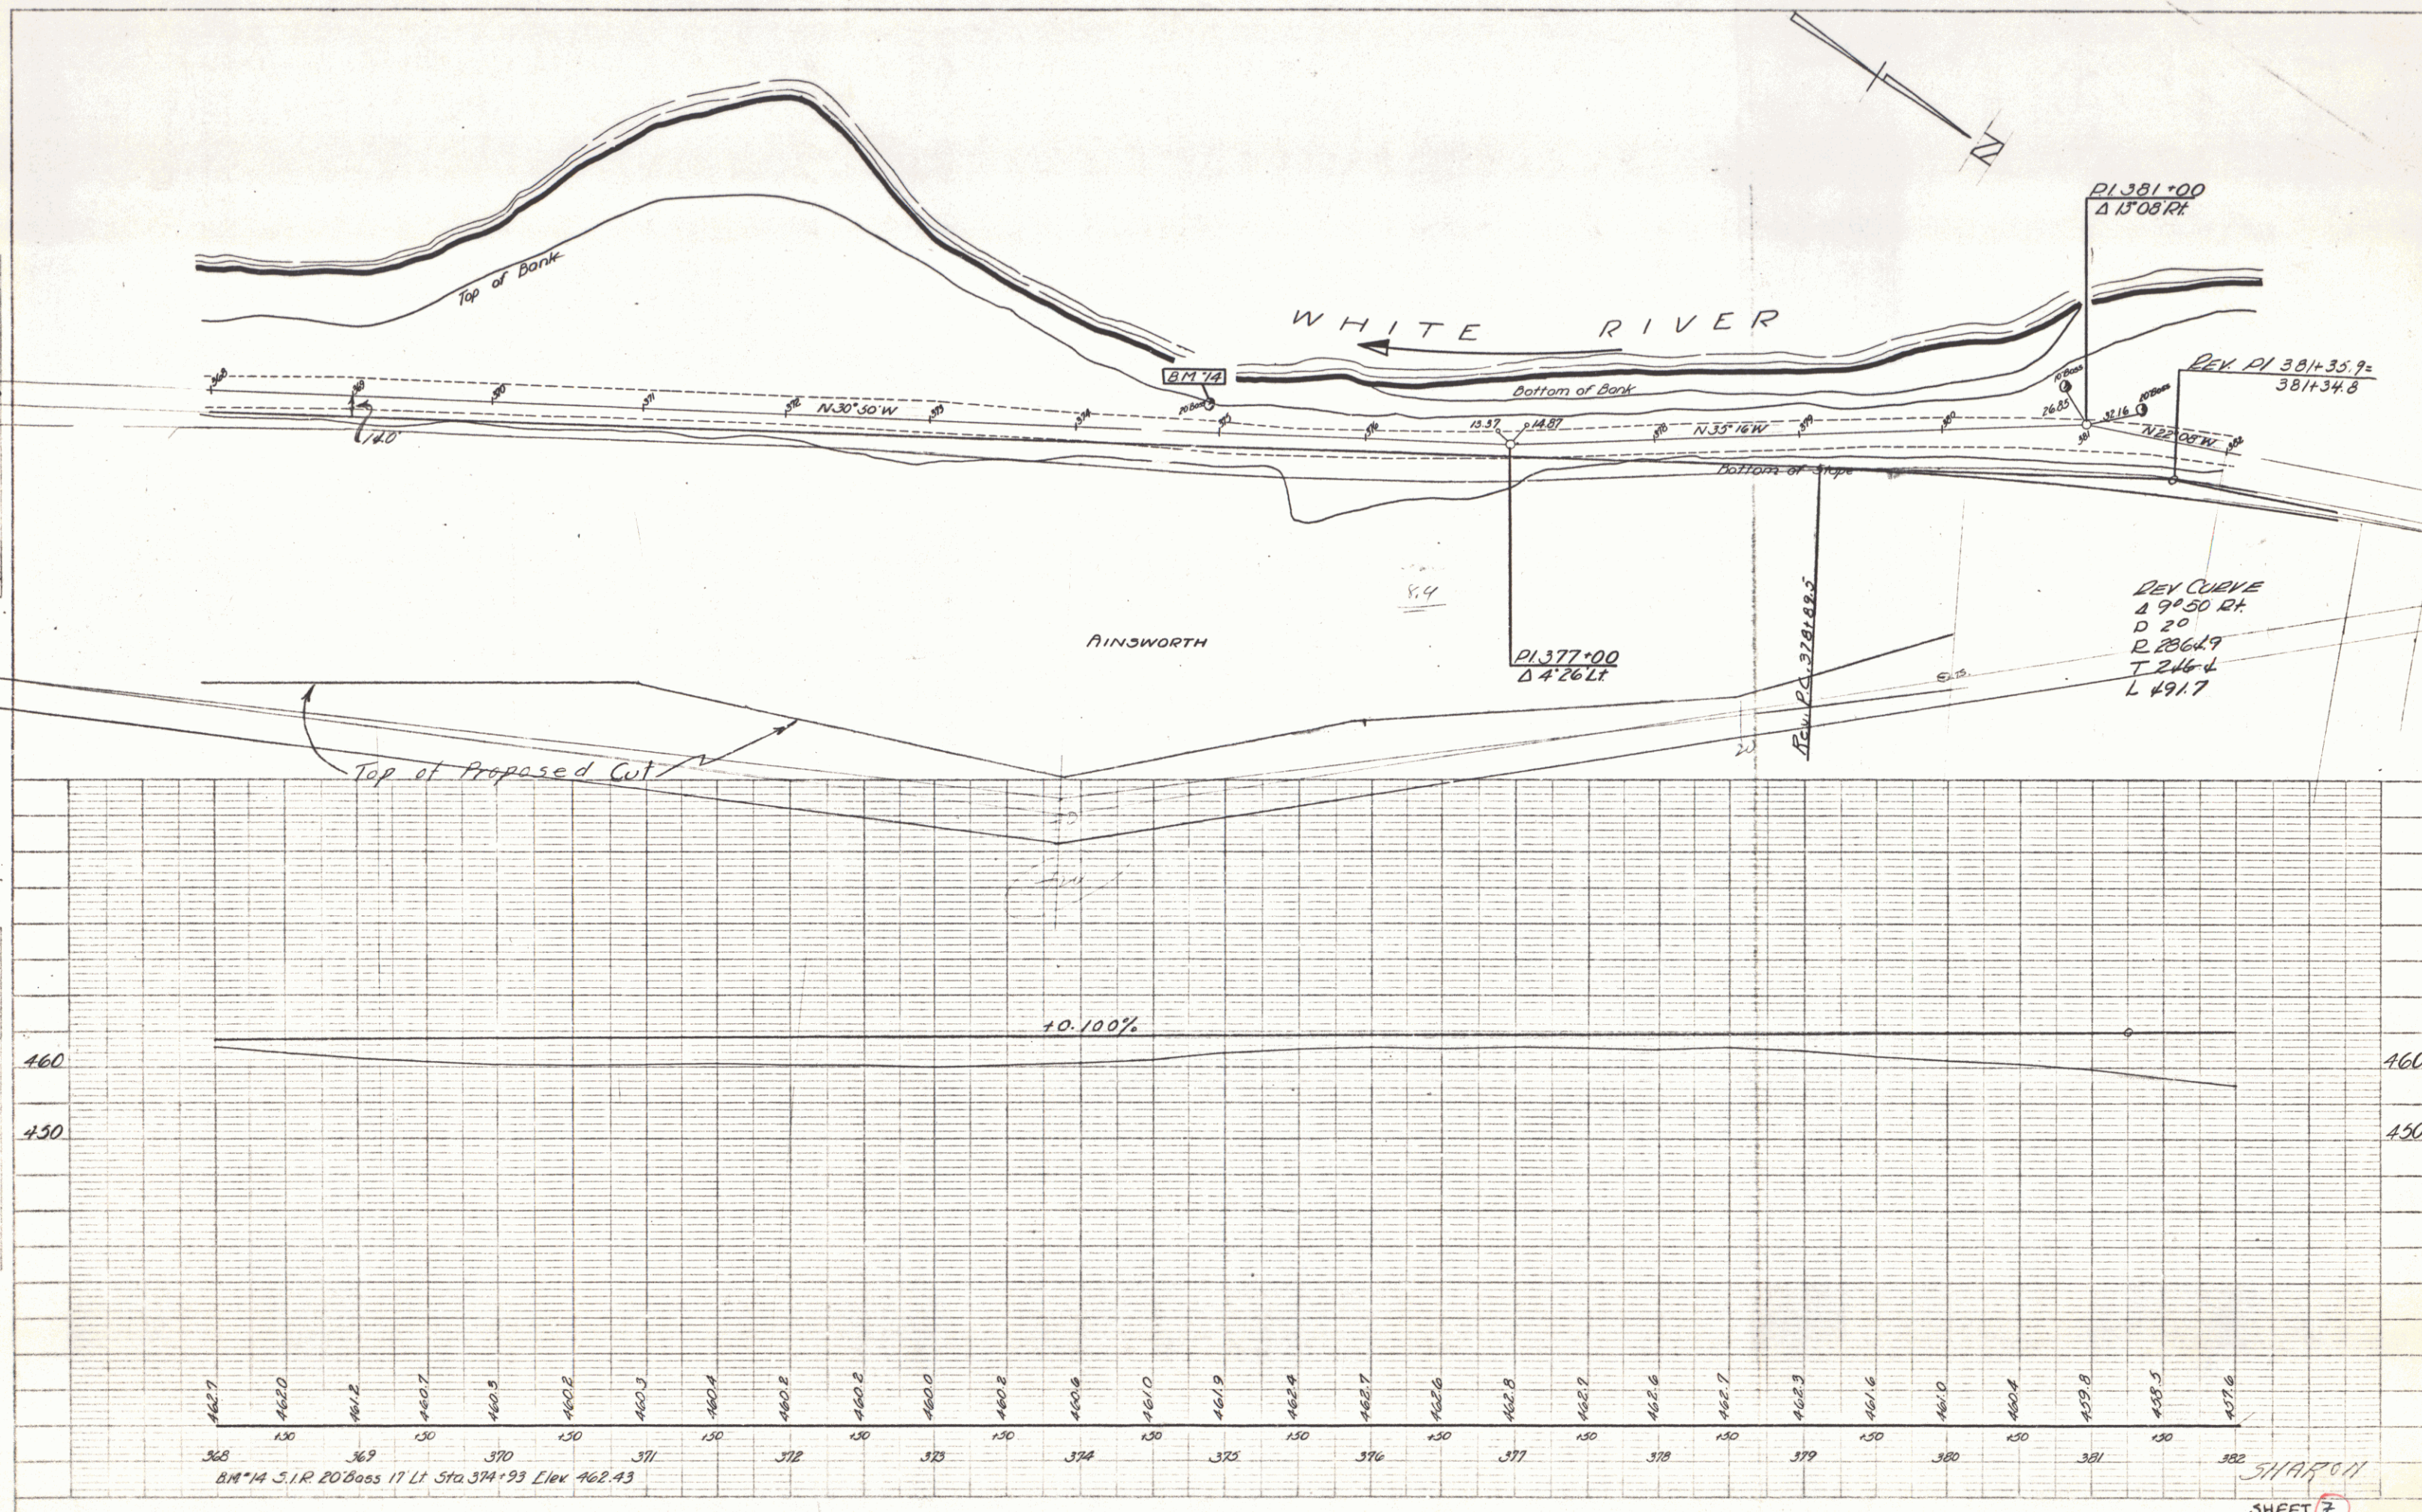


SHARON
SHEET 7


4

PLAN
 DATE: 11/30
 DRAWN BY: [Signature]
 CHECKED BY: [Signature]
 NO. 1

FIG. 1
 DATE: 11/30
 DRAWN BY: [Signature]
 CHECKED BY: [Signature]
 NO. 1

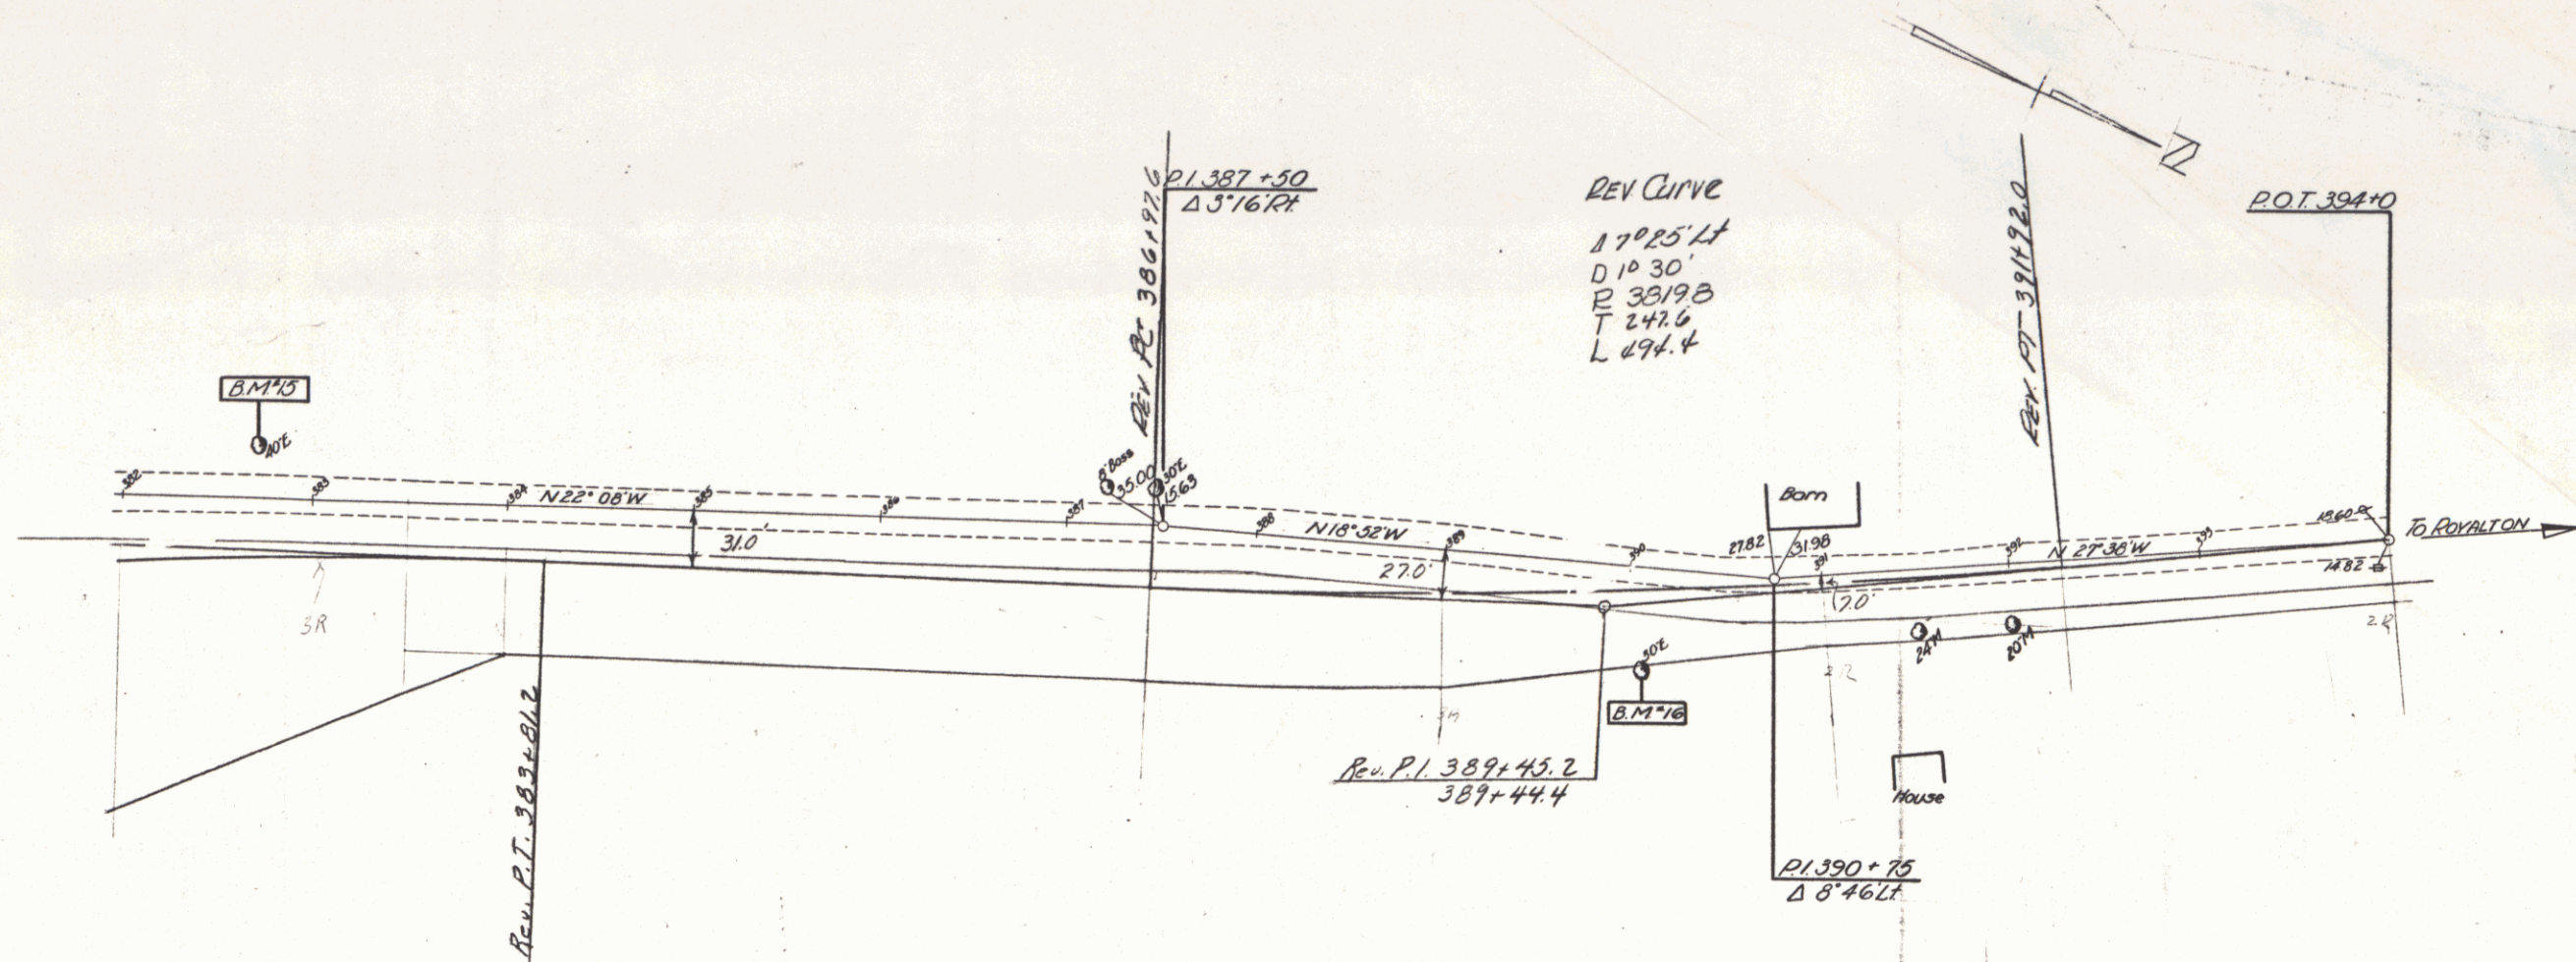

REV. CURVE
 $\Delta 7^\circ 25' L$
 $D 10' 30''$
 $R 38198$
 $T 242.6$
 $L 494.4$

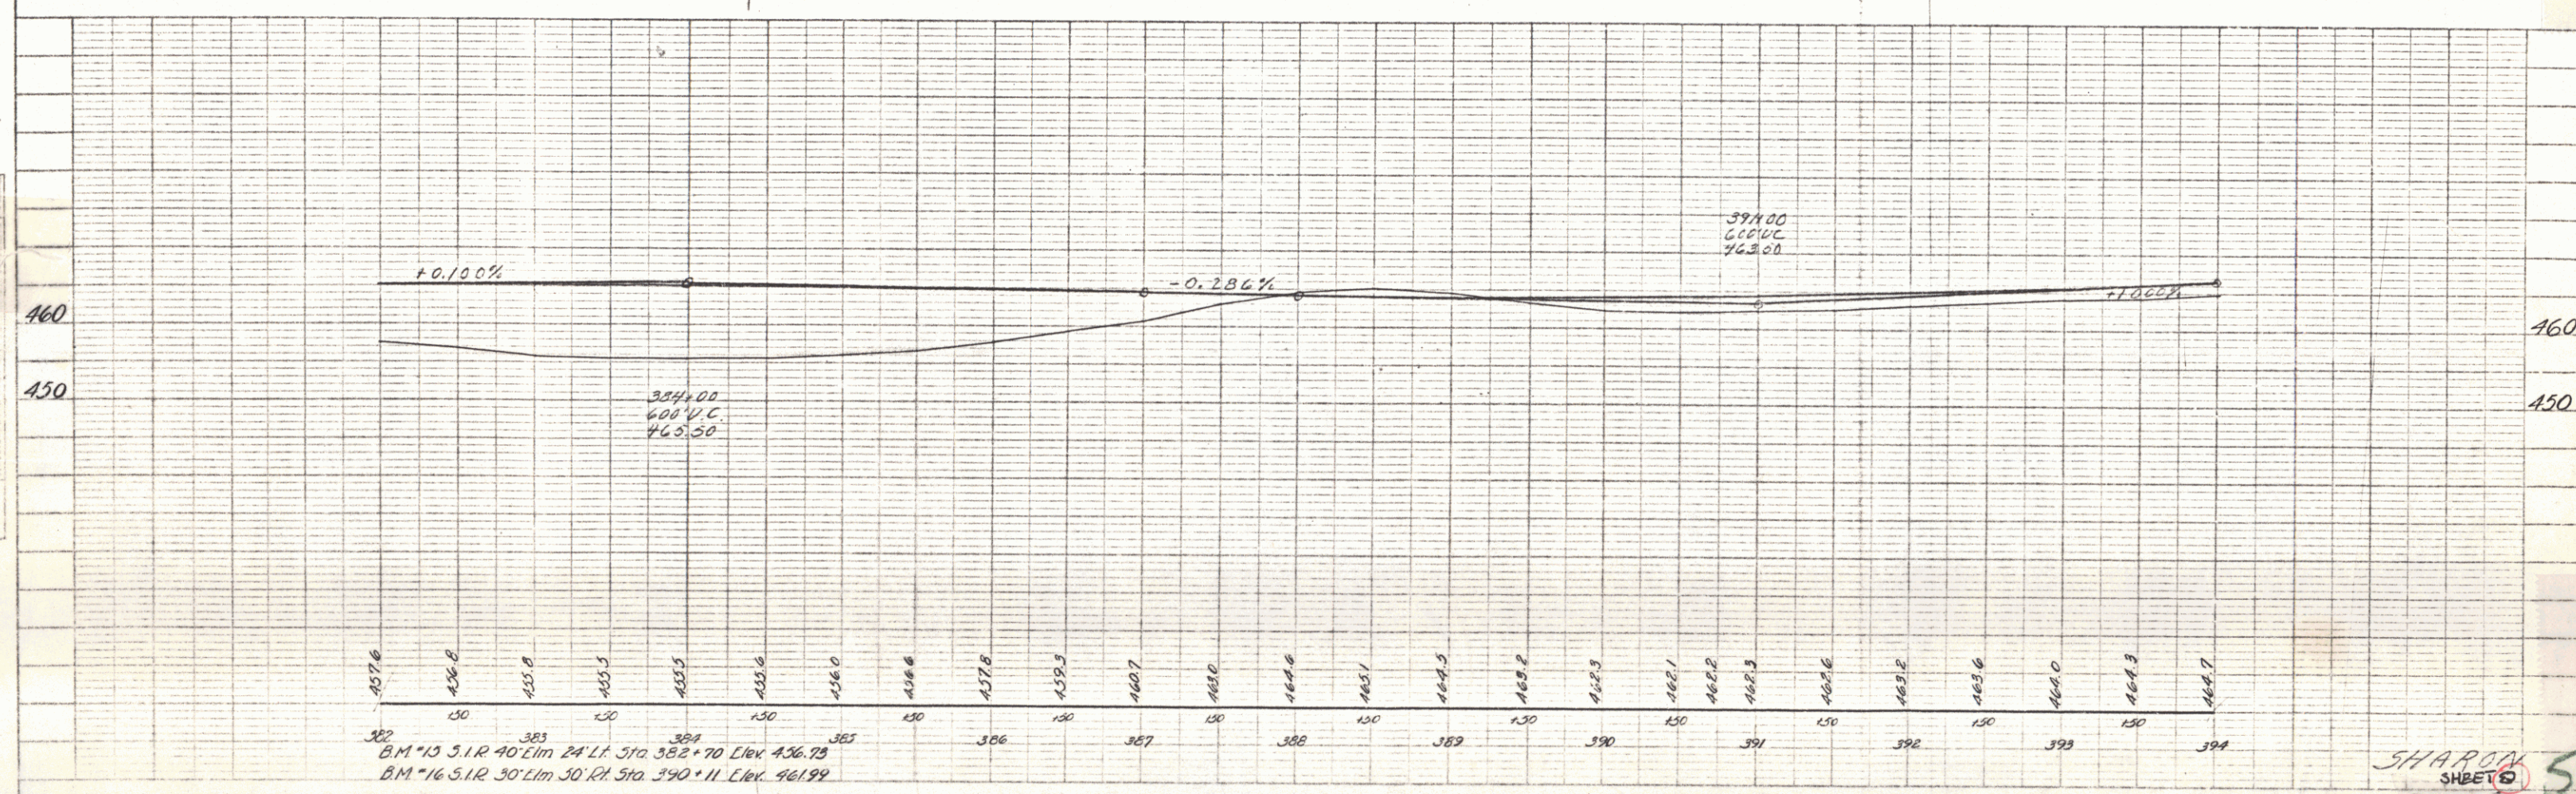

382 B.M. 15 S.I.R. 40' Lm 24' LT Sta. 382+70 Elev. 456.78
 383 B.M. 16 S.I.R. 30' Lm 50' RT Sta. 390+11 Elev. 461.99

SHARON
 SHEETS 5