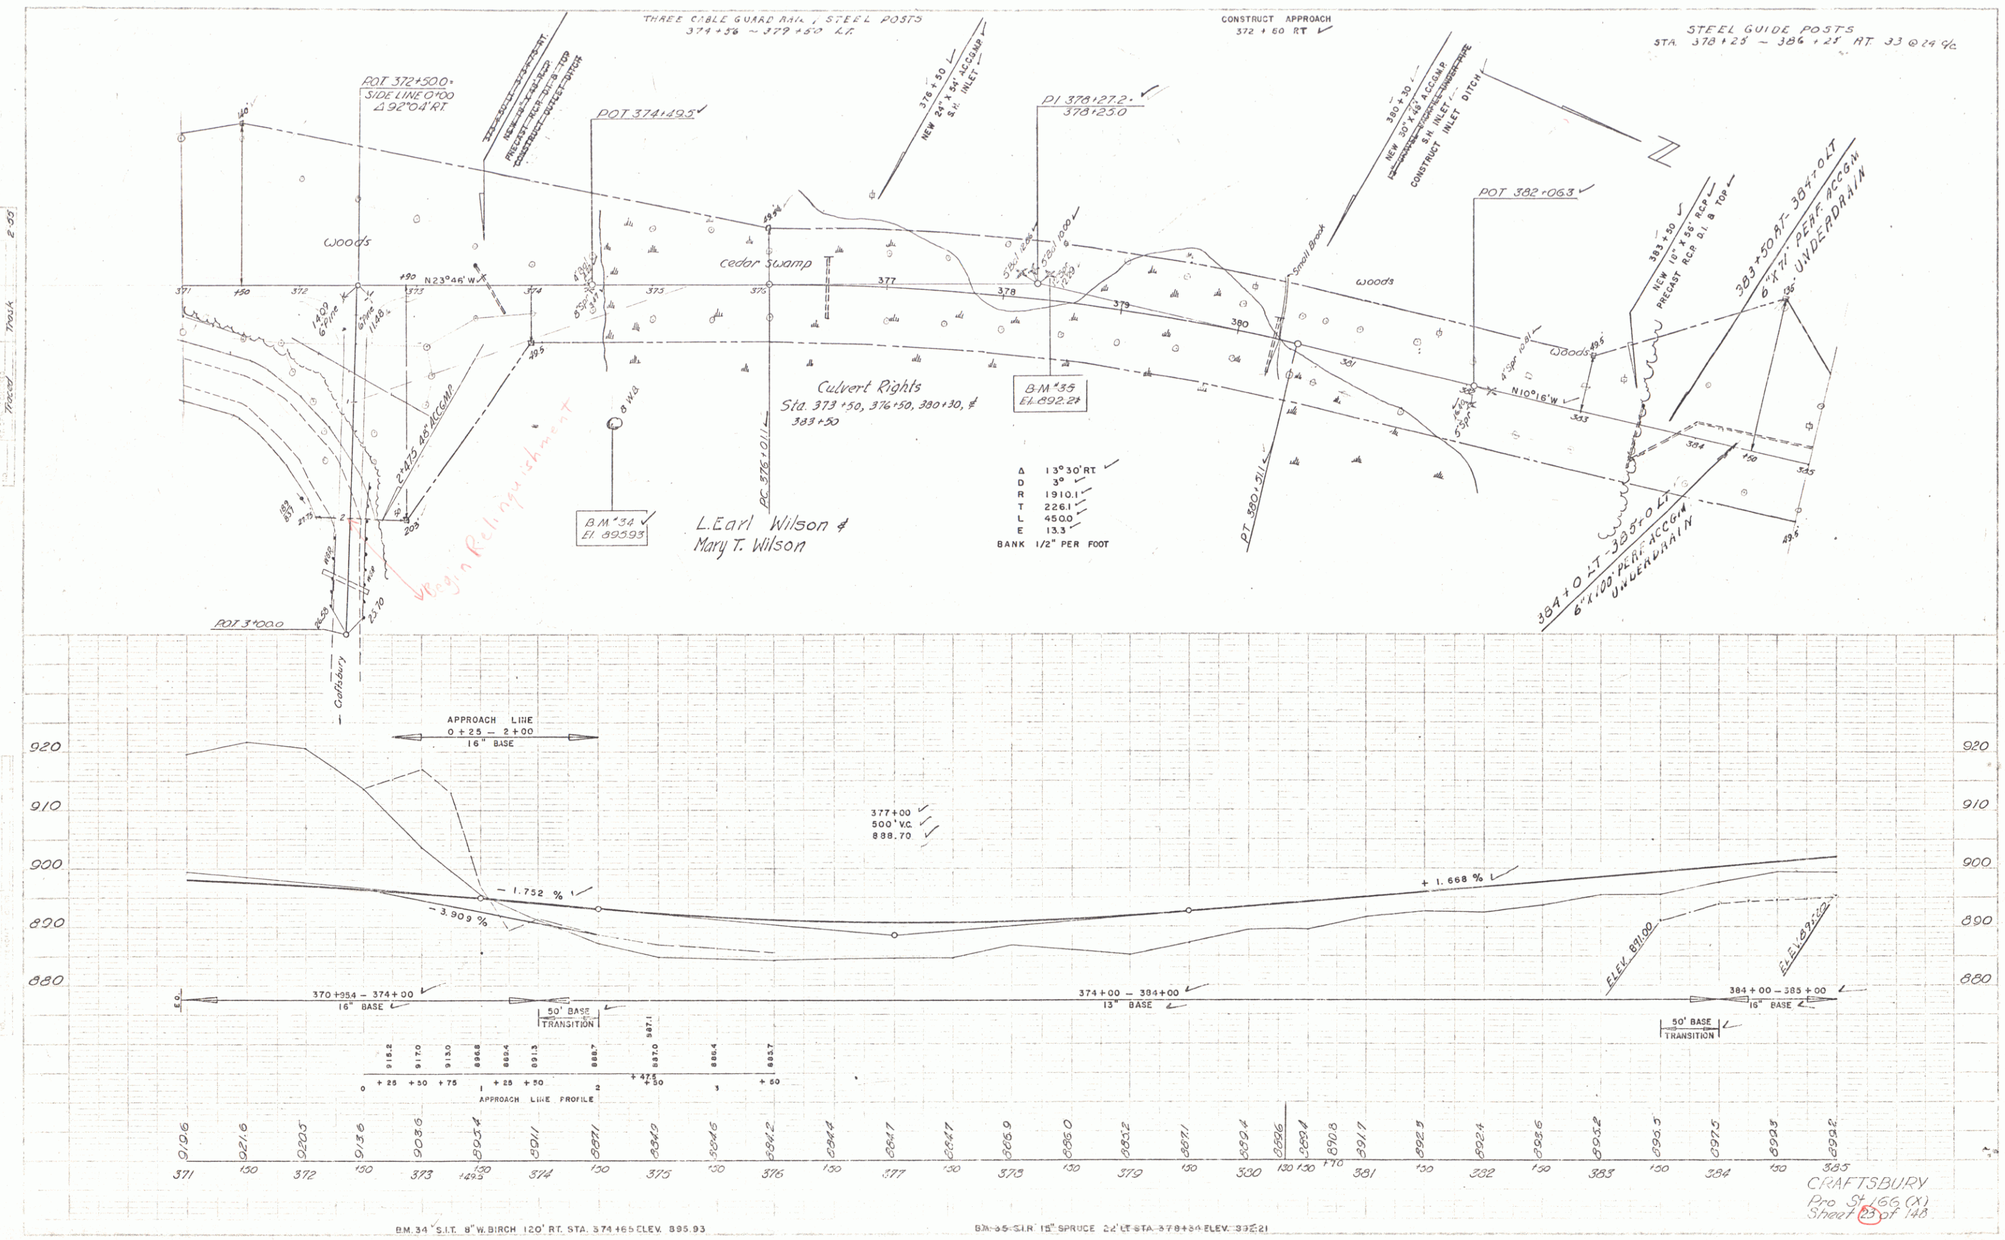

Sprinkling 1:93
Spreading 1:85
Tack 2.55
Mixed
Truck

DELANO 1-65

3