


POOR ORIGINAL COPY

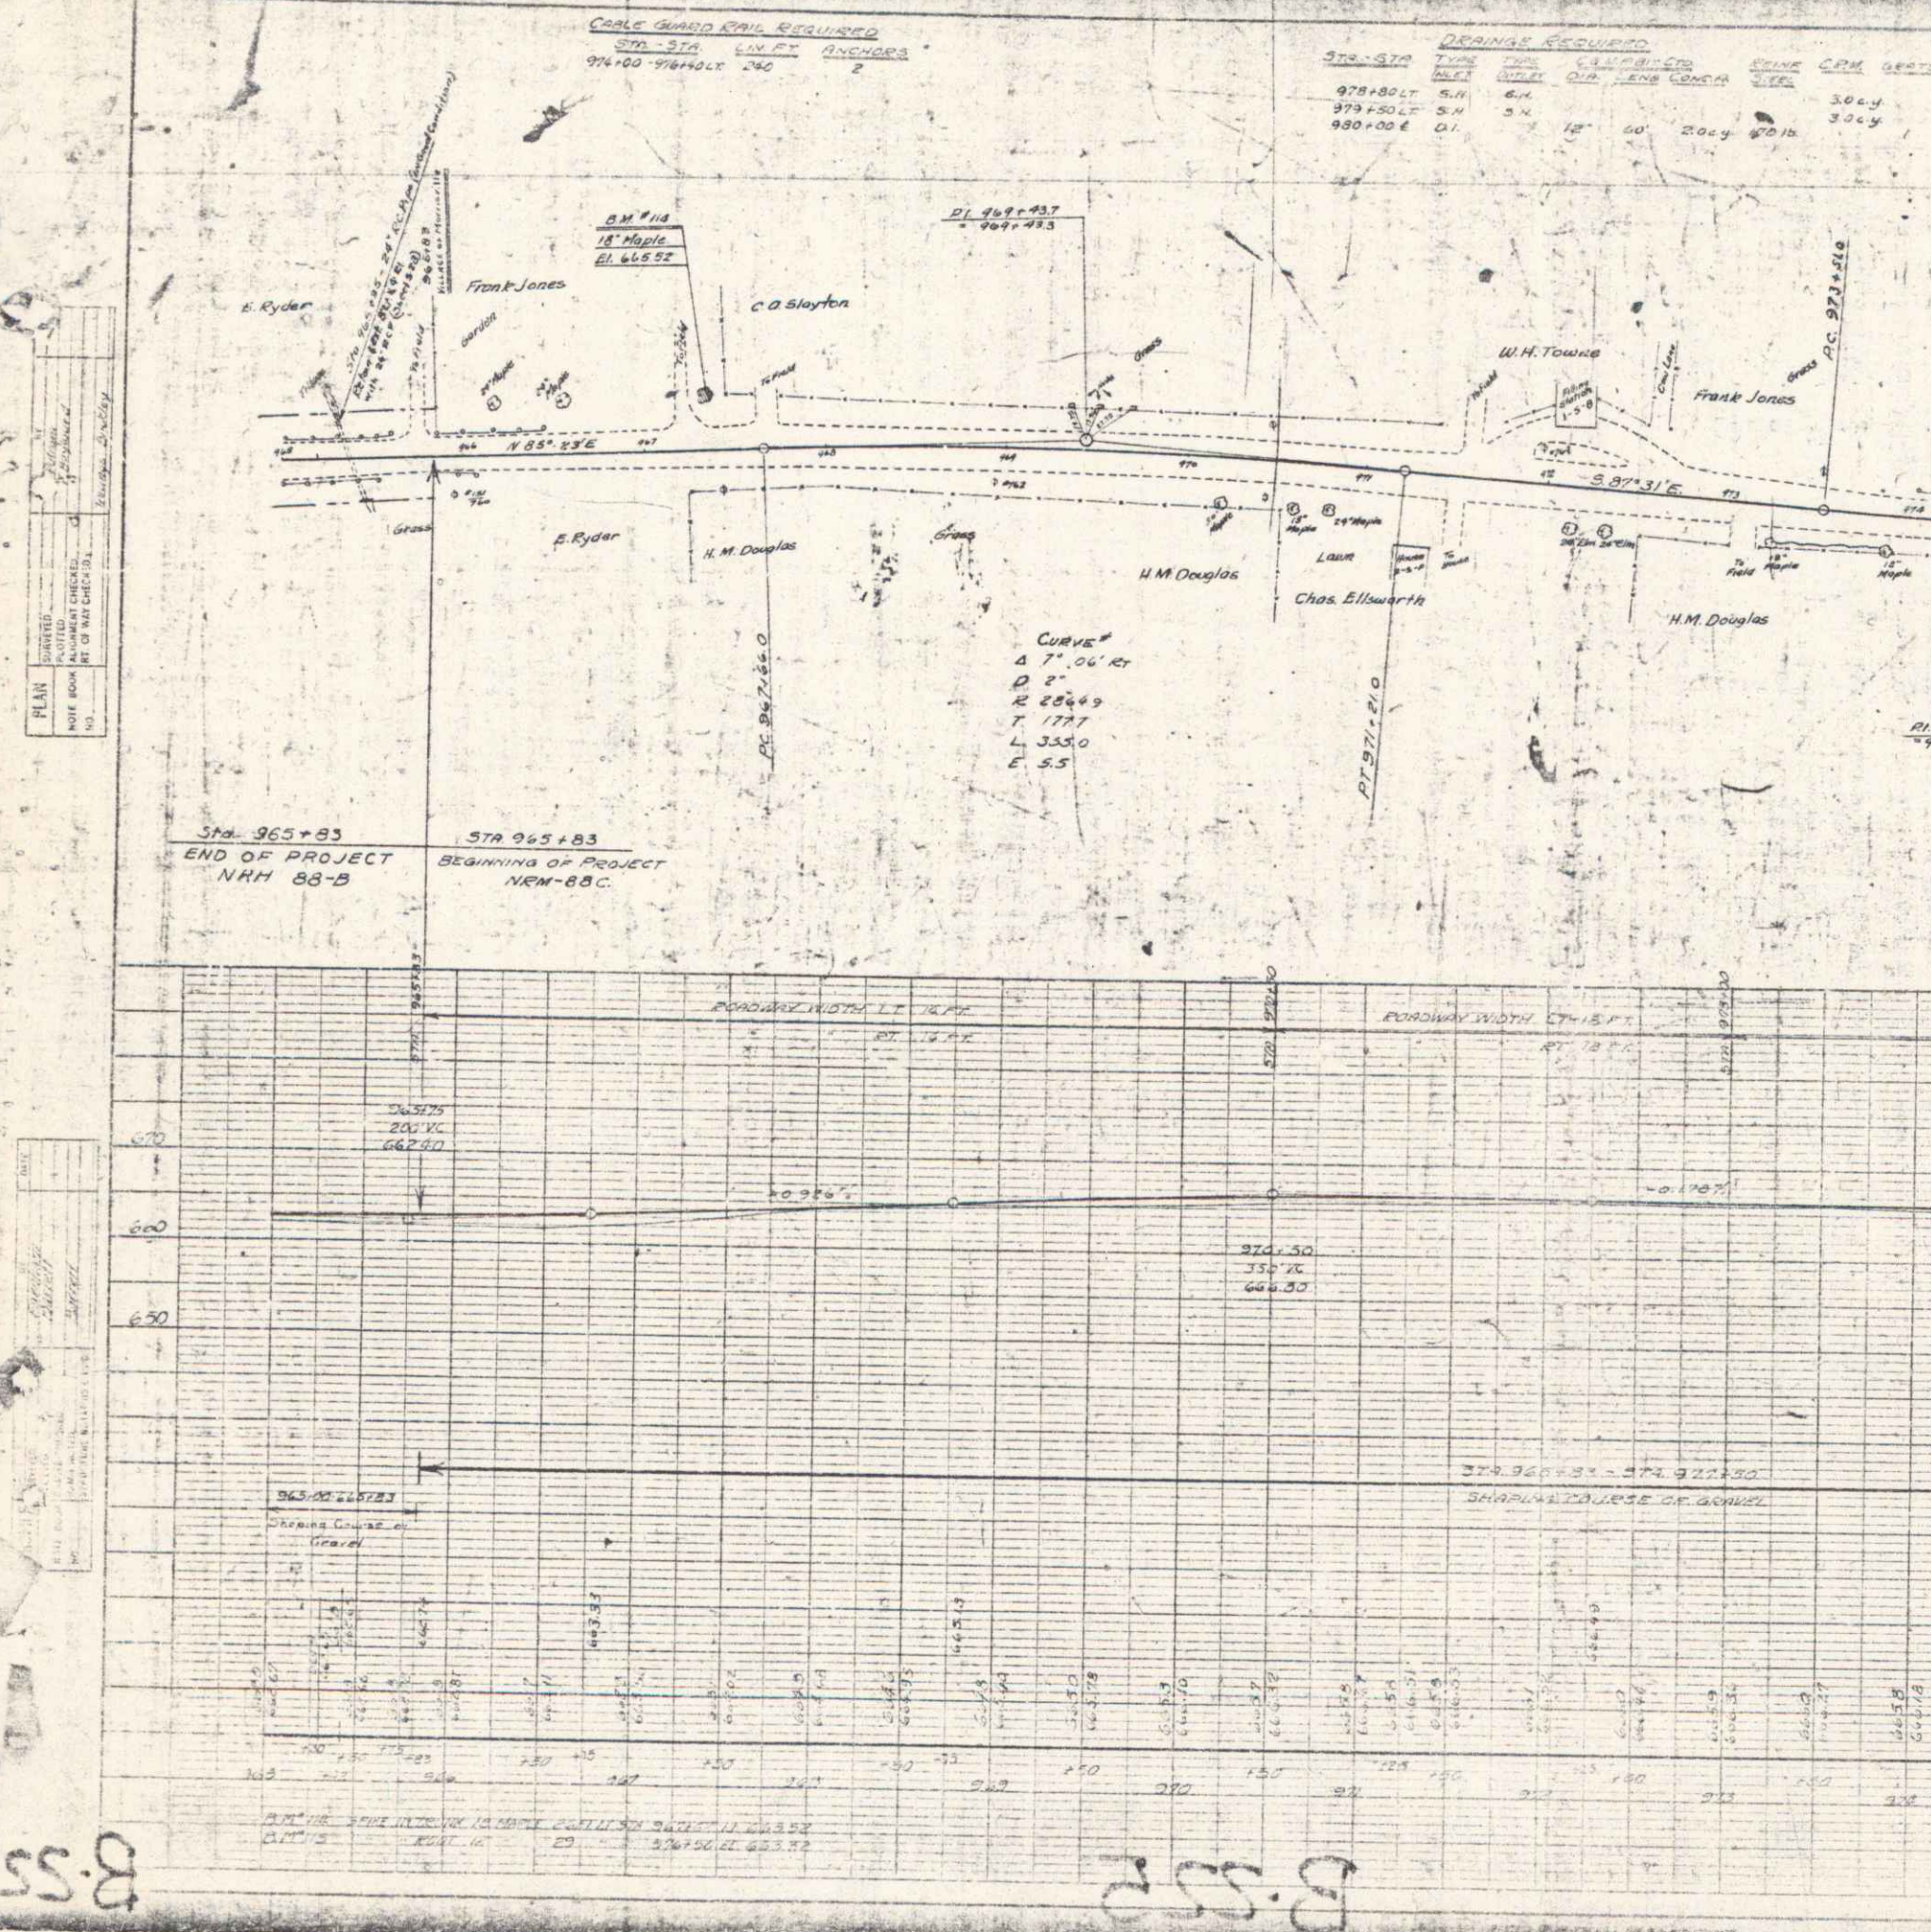

B-552

B-552