BRUSH MAT
Rt
322+~~25~~ 00 - 324+~~25~~ 00

CONSTRUCT SPECIAL DITCH TO BE
PAID FOR UNDER THE ITEM OF 101-A
324+50 - 325+00 Lt.

CONSTRUCT DRIVES
Lt 327+12
332+~~50~~ 33
Rt 332+88

PARCEL: 10A & B STA: 323+89 - 343+05±
GRANTOR: PETER HANDY ESTATE

TAKING: 0.55A±
RIGHTS: DRIVE 327+12 Lt., 332+50 Lt.
SLOPE 332+50 - 333+30 Lt., 335+40 - 336+20 Lt.
TITLE TAKEN:
RECORDED Bk Pg Dt

PARCEL: 9A
STATIONS: 317+66 - 323+93± Lt
TAKING: 0.1A±

PARCEL: 10A
STATIONS: 323+89 - 342+50 Rt
TAKING: 0.35 A±

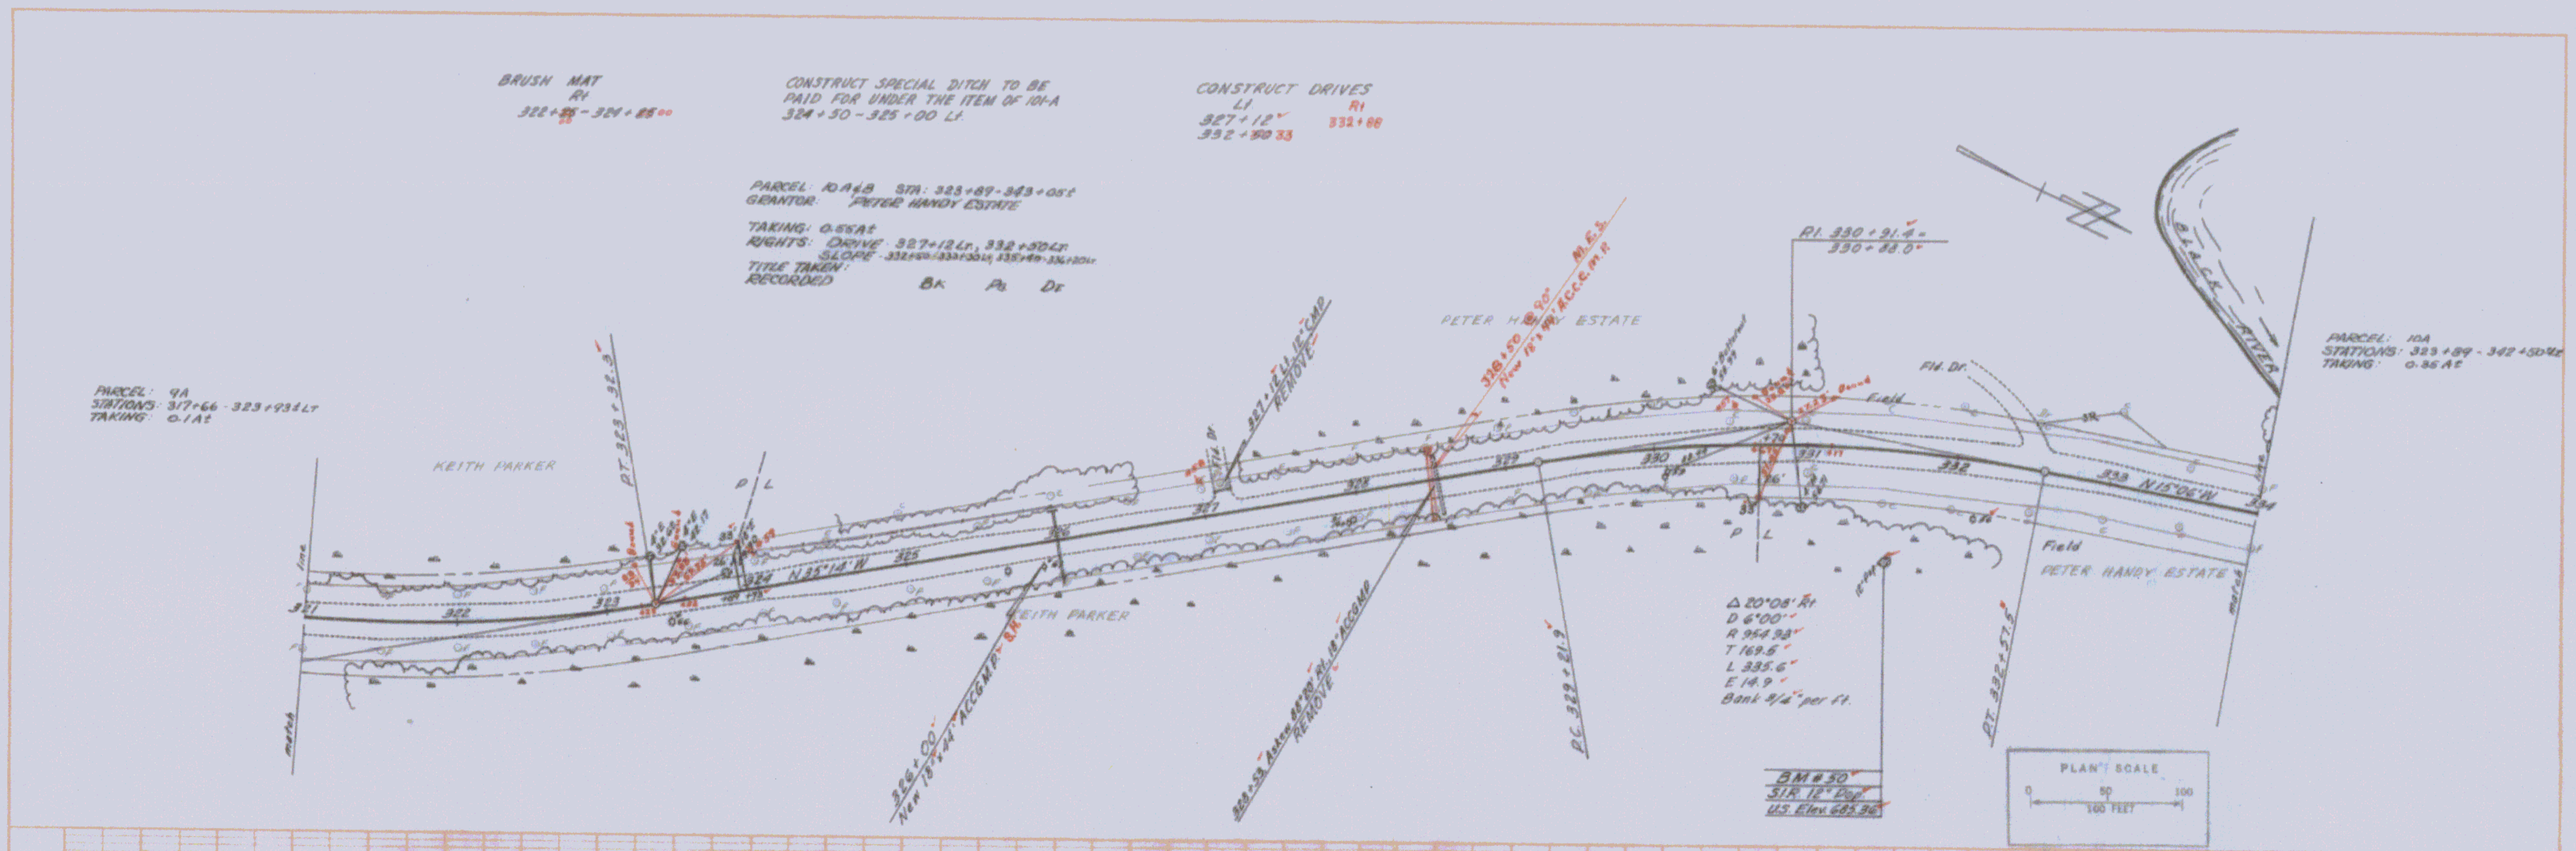

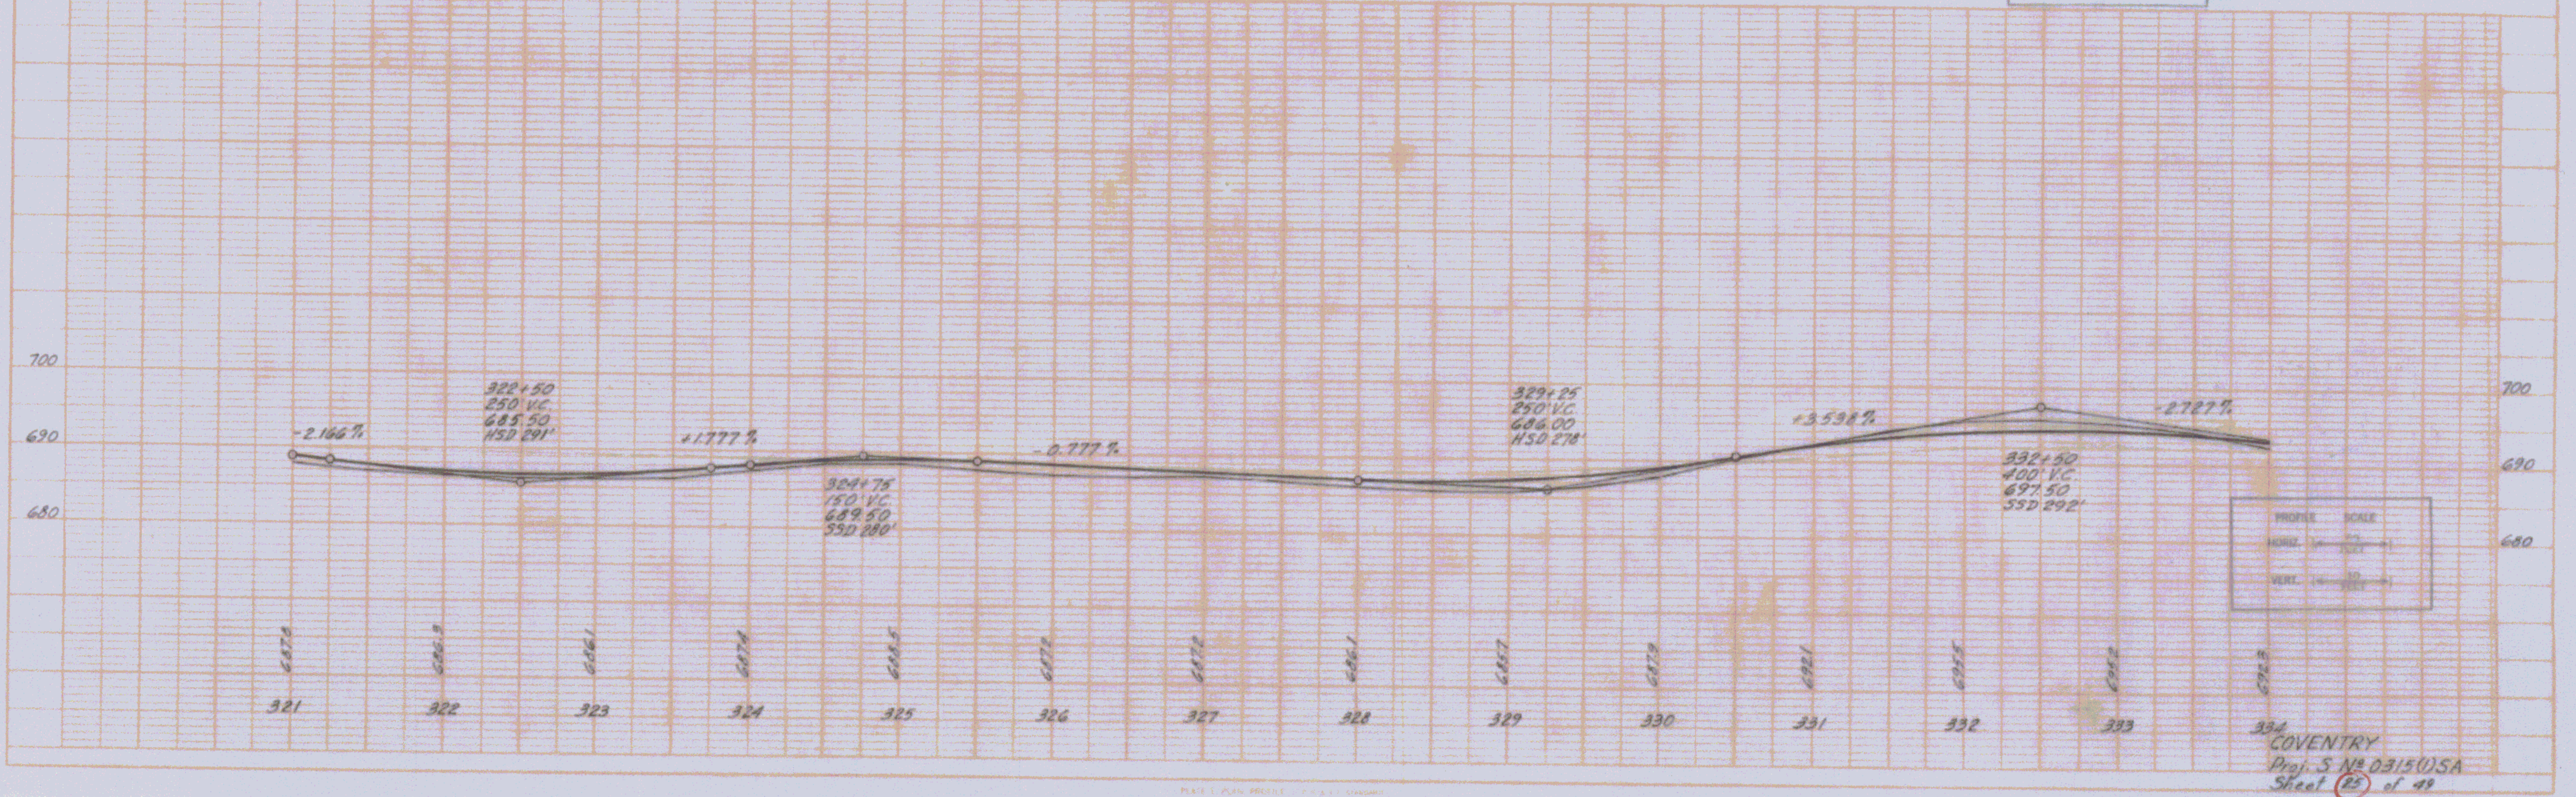

COVENTRY
Proj. S No 0315(1) SA
Sheet 25 of 49

9