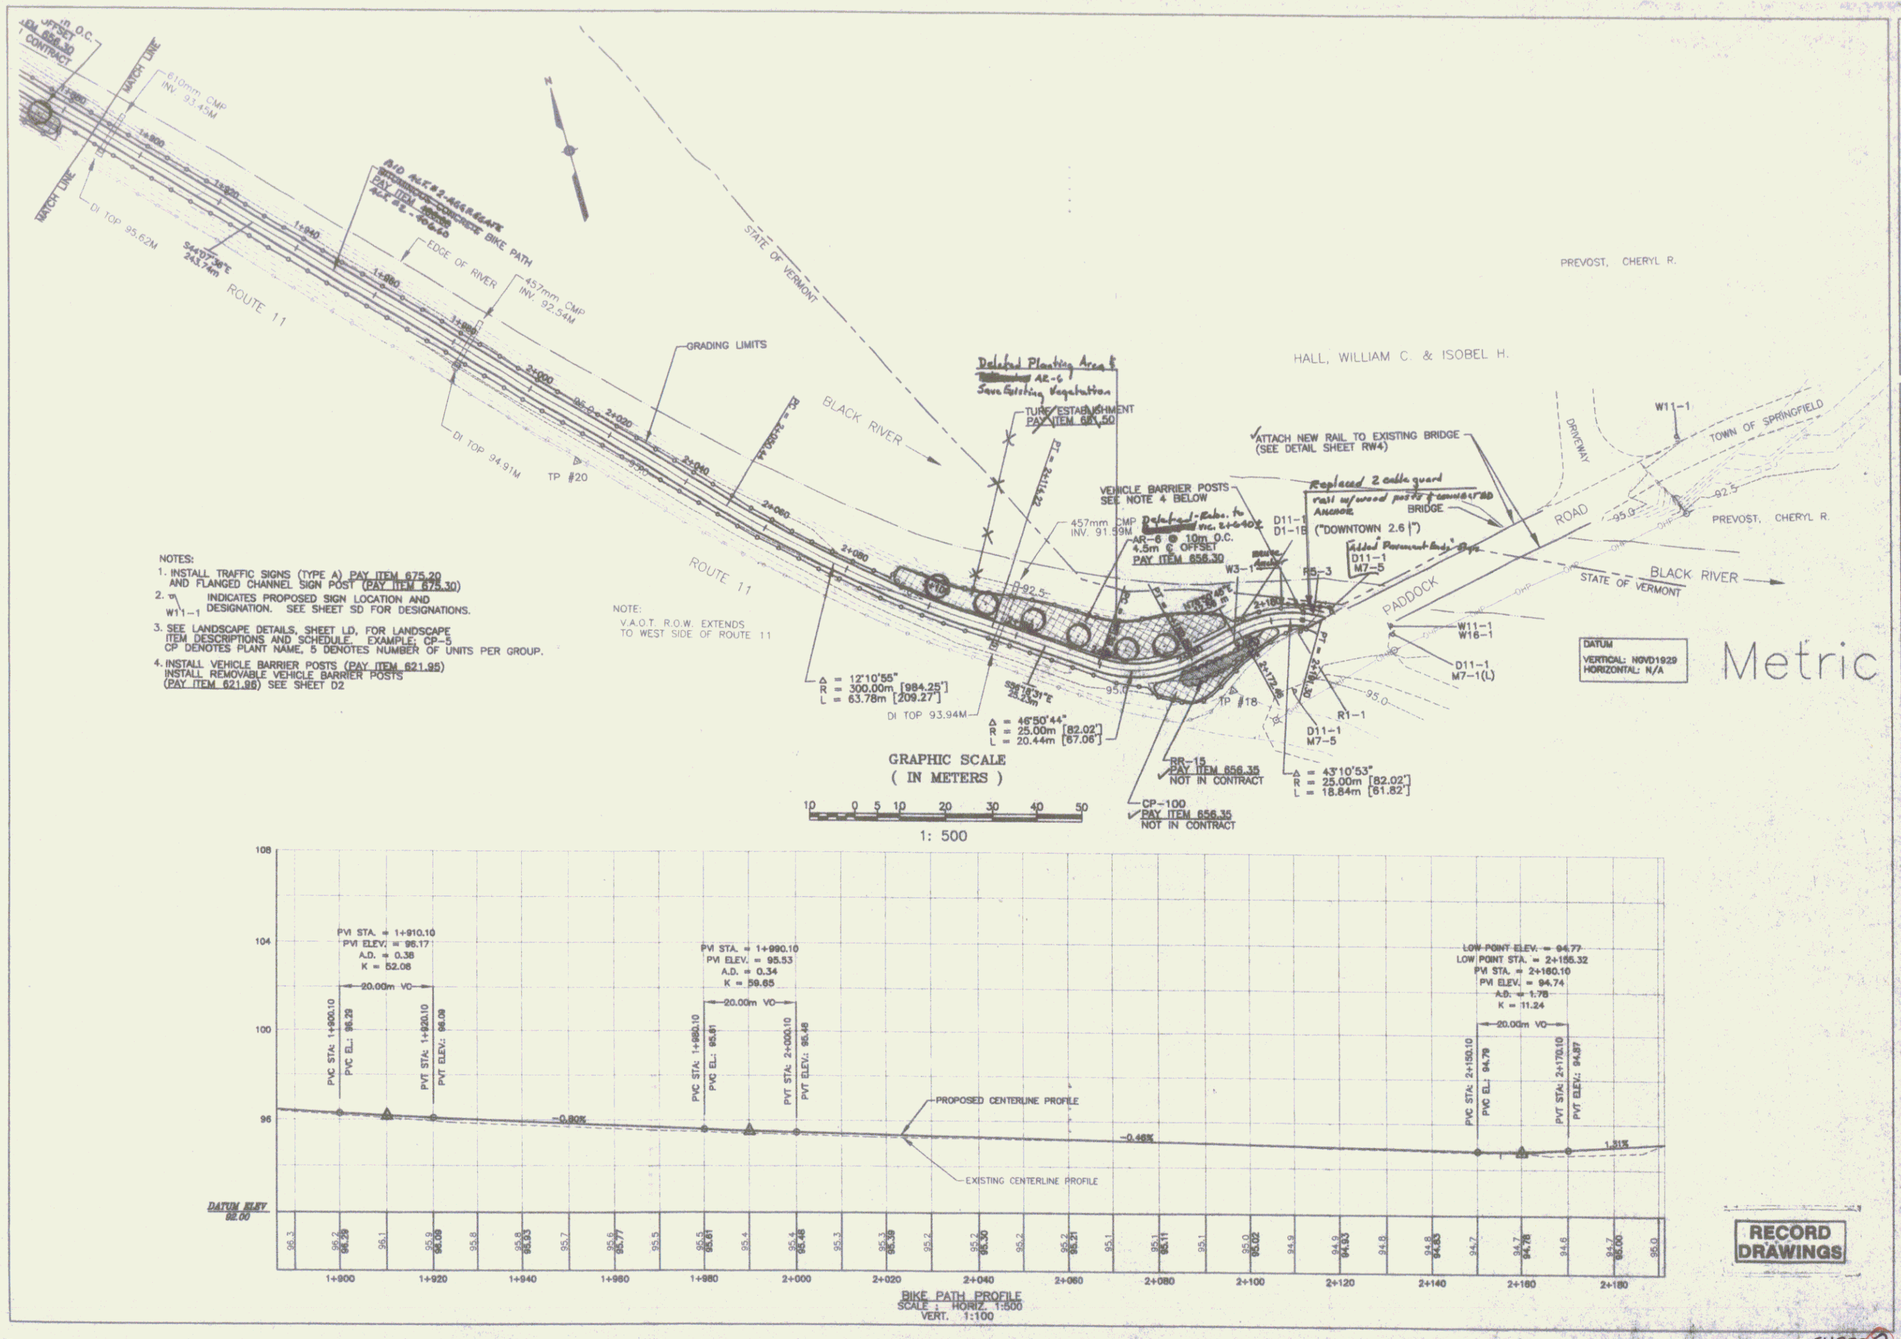
NOTES:
1. INSTALL TRAFFIC SIGNS (TYPE A) PAY ITEM 675.20 AND FLANGED CHANNEL SIGN POST (PAY ITEM 675.30)
2. W11-1 INDICATES PROPOSED SIGN LOCATION AND DESIGNATION. SEE SHEET SD FOR DESIGNATIONS.
3. SEE LANDSCAPE DETAILS, SHEET LD, FOR LANDSCAPE ITEM DESCRIPTIONS AND SCHEDULE. EXAMPLE: CP-5 CP DENOTES PLANT NAME, 5 DENOTES NUMBER OF UNITS PER GROUP.
4. INSTALL VEHICLE BARRIER POSTS (PAY ITEM 621.95) INSTALL REMOVABLE VEHICLE BARRIER POSTS (PAY ITEM 621.96) SEE SHEET D2
NOTE:
V.A.O.T. R.O.W. EXTENDS TO WEST SIDE OF ROUTE 11
GRAPHIC SCALE
(IN METERS)
1: 500
ROUTE 11
BLACK RIVER
STATE OF VERMONT
HALL, WILLIAM C. & ISOBEL H.
PREVOST, CHERYL R.
TOWN OF SPRINGFIELD
PADDOCK
DRIVEWAY
GRADING LIMITS
EDGE OF RIVER
MATCH LINE
BIKE PATH
VEHICLE BARRIER POSTS SEE NOTE 4 BELOW
ATTACH NEW RAIL TO EXISTING BRIDGE (SEE DETAIL SHEET RW4)
BRIDGE
("DOWNTOWN 2.6")
DATUM
VERTICAL: NGVD1929
HORIZONTAL: N/A
Metric
PVI STA. = 1+910.10
PVI ELEV. = 96.17
A.D. = 0.38
K = 52.08
PVI STA. = 1+990.10
PVI ELEV. = 95.53
A.D. = 0.34
K = 58.65
LOW POINT ELEV. = 94.77
LOW POINT STA. = 2+155.32
PVI STA. = 2+160.10
PVI ELEV. = 94.74
A.D. = 1.78
K = 11.24
20.00m VC
PROPOSED CENTERLINE PROFILE
EXISTING CENTERLINE PROFILE
DATUM ELEV 92.00
BIKE PATH PROFILE
SCALE : HORIZ. 1:500
VERT. 1:100
RECORD DRAWINGS
SPRINGFIELD TRANSPORTATION PATH
PHASE 1
TOWN OF SPRINGFIELD
SPRINGFIELD, VERMONT
PLAN AND PROFILE
PP6
SHEET 8