


POOR ORIGINAL COPY

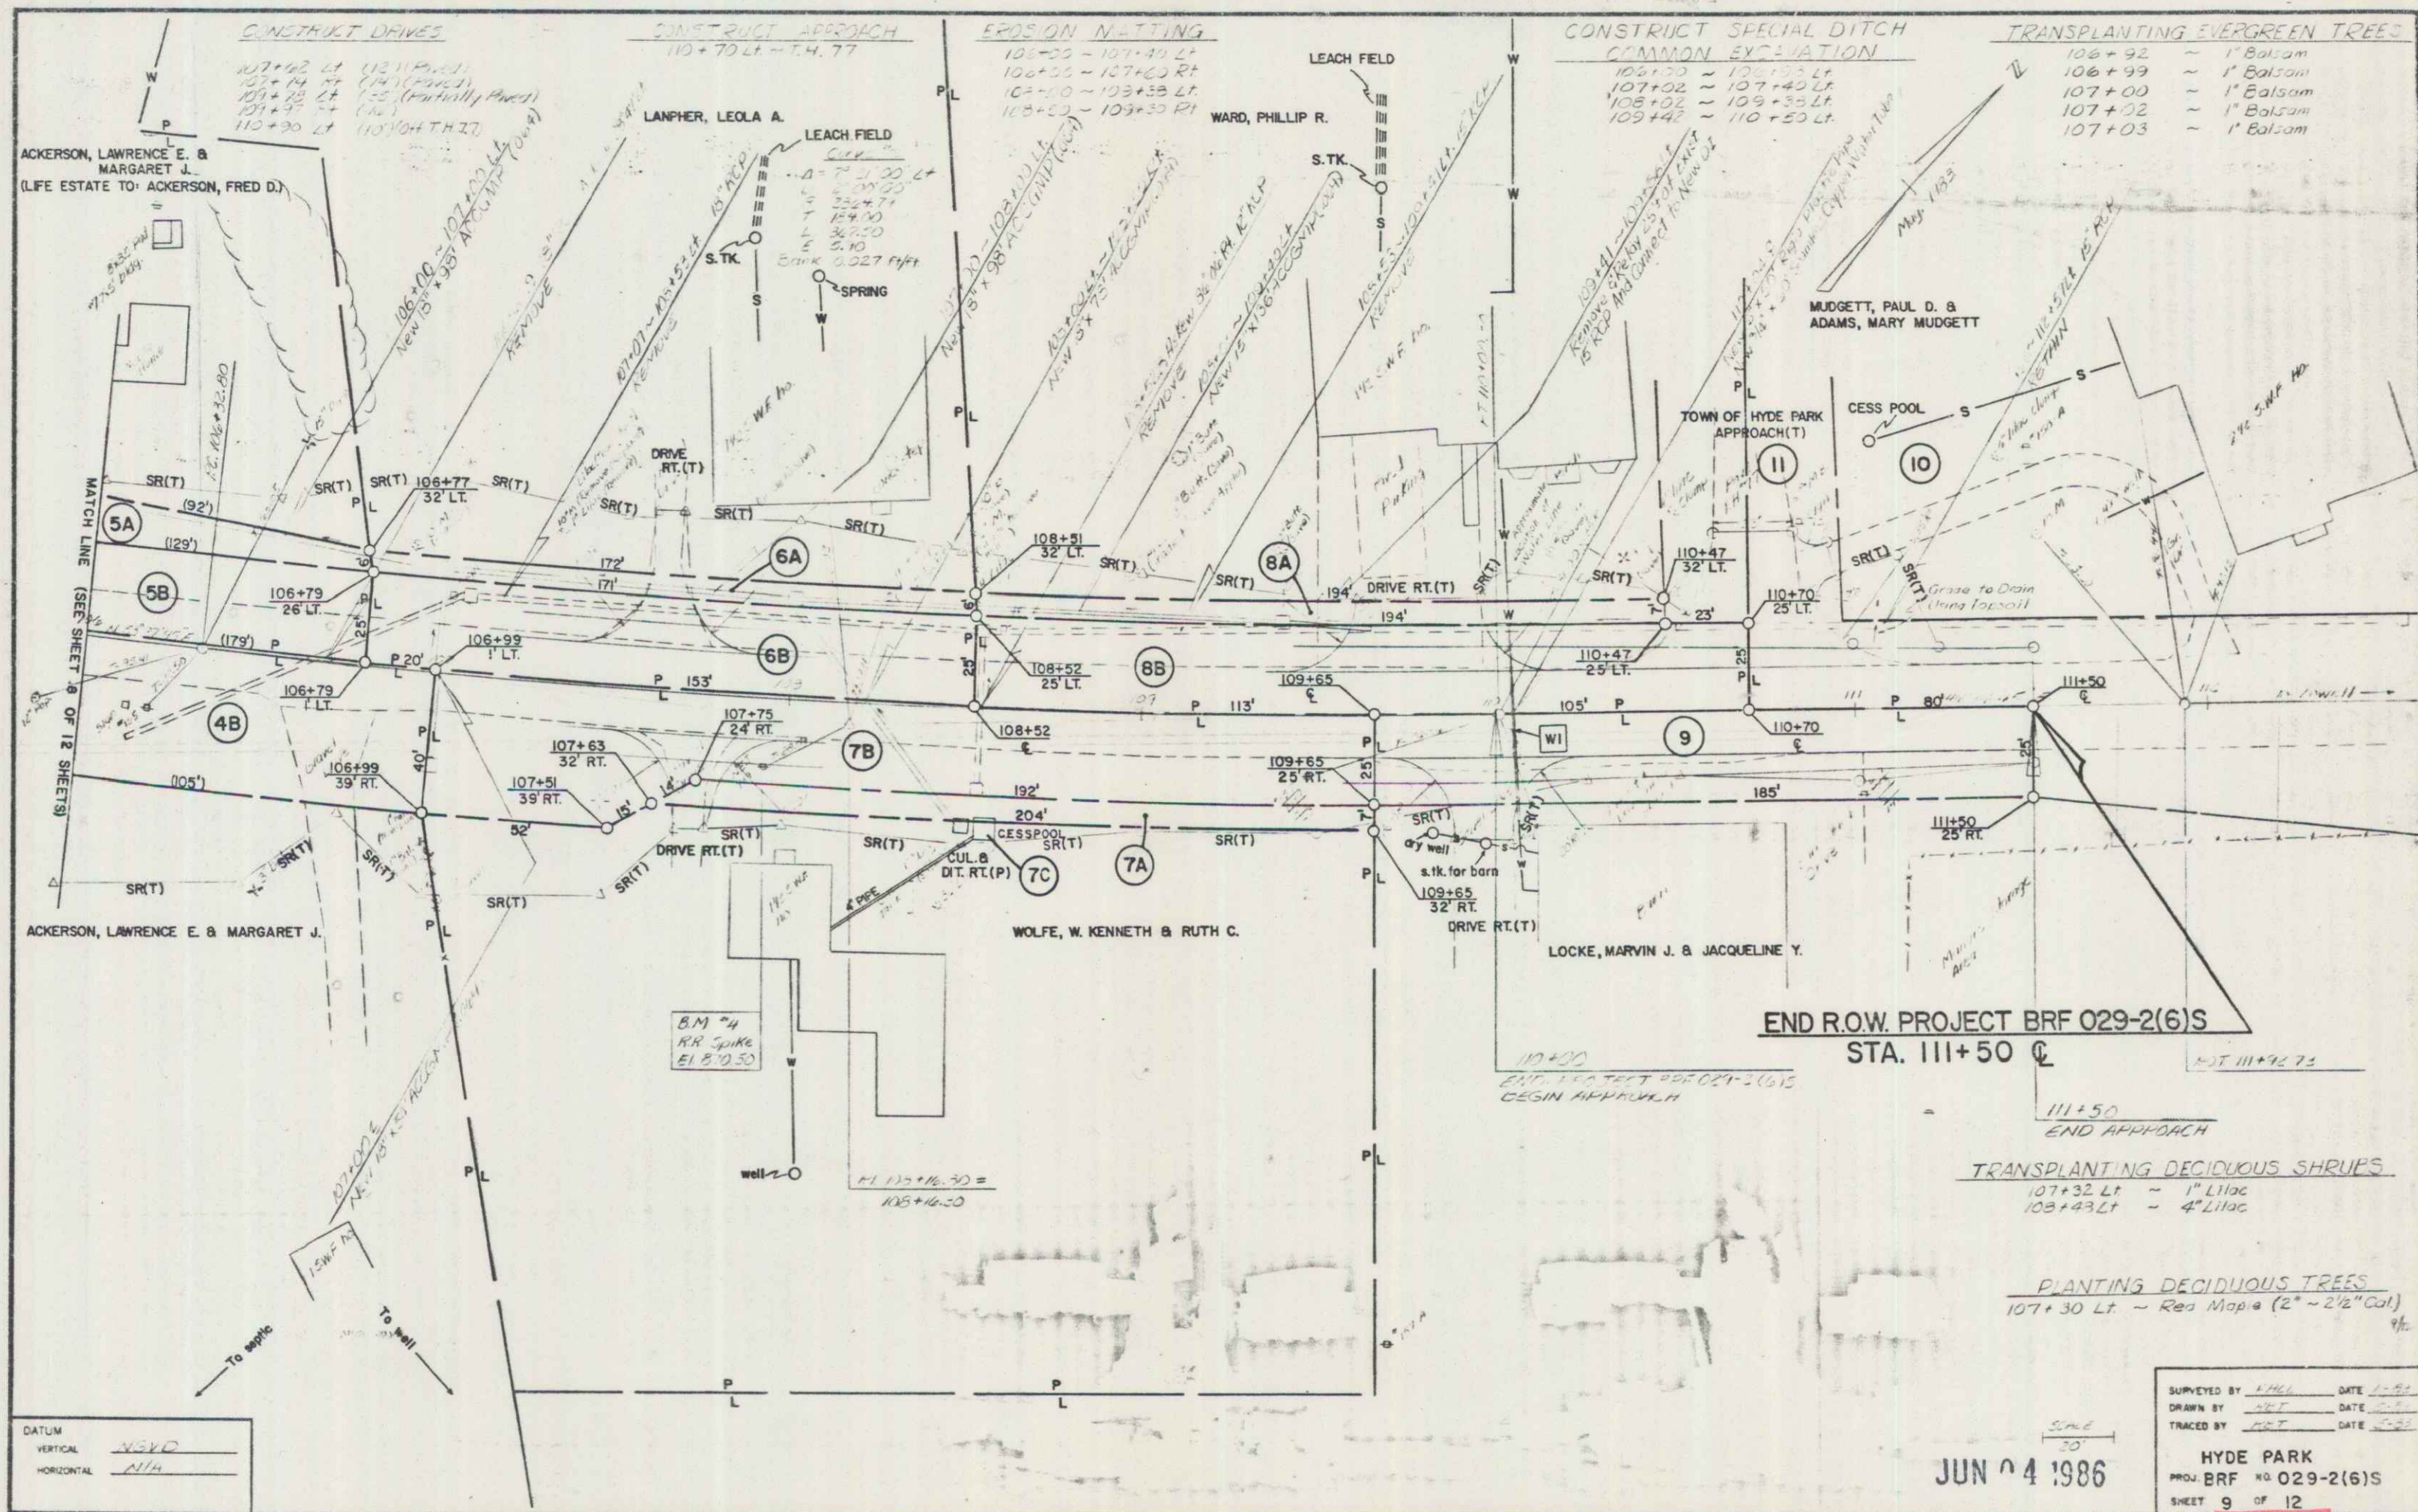

JUN 4 1986

SURVEYED BY K.H.G. DATE 1-1-83
DRAWN BY M.T. DATE 2-5-83
TRACED BY M.T. DATE 2-5-83

HYDE PARK

PROJ. **BRF** NO. **029-2(6)S**

SHEET **9** OF **12**