

POOR ORIGINAL COPY

CHECKED BY: M.J.R. DATE 6-11-87
CHECKED BY: K.D.P. DATE 6-11-87

LEGEND

- SLOPE RIGHTS
- PROPERTY LINE
- TOP OF CUT
- TOE OF SLOPE

APPROVED: Samuel W. Allen DATE: 7-2-67
AGENT D, PLANS & TITLES

2

TABLE OF PROJECT PROPERTY ACQUISITION

STATE OF VERMONT
AGENCY OF TRANSPORTATION
RIGHT OF WAY PLANS
DETAIL SHEET

PARCEL NO.	GRANTOR	SHEET NO.	BEGINNING STATION	ENDING STATION	TAKING	REM.	RIGHTS	TITLE TAKEN	DATE	TOWN OR CITY RECORDED	BK.	PG.	REMARKS	REVISION NO.	SHEET NO.	DESCRIPTION OF REVISION	DATE	MADE BY	APPROVED BY
2C	PERRY, DONALD M. & PERRY, RONALD B. (CONTINUED)	14	REV. 88+54 RT. REV. 88+62 RT. 92+12 RT. 93+30 RT.	93+40 RT. REV. 89+20 RT. 93+40 RT.	0.09 A±		SLOPE (P) (195 SF±) CONST. EASE. (T) (0.06A±) DRIVE (T)						4139 SF± 2795 SF± 12' GRAVEL MP 0172	18	11,21	PARCEL 19 TRI-ENTERPRISE INC. REVISE DRIVE AT STA. 192+20 RT. WE ARE NO LONGER AFFECTING GARAGE PER CO. 7217	3/16/88	A.S.J.	<i>Lub</i>
2D		13, 14, 15	69+50 RT. REV. 84+72 RT. REV. 84+90 RT. REV. 85+20 RT.	98+91 LT. 91+50 RT. REV. 85+85 RT. 94+10 LT.	3.09 A±		ALL R.T. & I. CONST. EASE. (T) (0.06A±) SLOPE (P) (0.03A±)						HWY. EASE. VT. RTE. 128 2318 SF± 1100 SF± STONEWALL	19	10	PARCEL 16 MINOR CHANGE REMAINDER FROM 0.58 A± TO 1.77 A± PER CO. 7225	3/30/88	M.J.R.	<i>Lub</i>
3A	FOSS, DONALD C. & SUZANNE D.	14, 15	93+38 RT. 93+40 RT. 94+55 RT. 94+75 RT. 98+30 RT. 98+88 RT. 99+38 RT. REV. 101+80 RT. REV. 101+90 RT. REV. 104+20 RT. 93+40 RT. REV. 103+50 RT.	REV. 104+20 RT. 94+20 RT. REV. 101+70 RT. 95+35 RT. 98+77 RT. 100+04 RT. REV. 103+44 RT. REV. 107+57 RT.	0.22 A±		CONST. EASE. (TX 308 SF±) CONST. EASE. (T) (0.10A±) SLOPE (T) (250 SF±) SLOPE (P) (144 SF±) DITCH (P) DRAINAGE (P) DRIVE (T) CONST. EASE. (T) (392 SF±) REMOVE & RESET (T)	COND	11-22-88	WESTFORD	56	546	16' GRAVEL MP 0188 WOOD RAIL FENCE 12' GRAVEL MP 0191	22	7	PARCEL NO. 10 POULIOT AREA FOR CONST. EASE. (T) FROM REV. 150+70 LT. ~ REV. 158+05 LT. IS 0.14A± AN NOT 0.014A± PER CO. 7287	5/27/88	A.S.J.	<i>ggm</i>
3B		14, 15	93+39 RT.	REV. 104+20 RT.	0.62 A±		ALL R.T. & I.						HWY. EASE. VT. RTE. 128	23	9, 19, 20	PARCEL NO. 12 LAVALLÉE DELETED DIT. & DR. AT STA. 183+00 LT. CHANGED DRIVE FROM 164+00 RT. TO 163+00 RT. PER CO. 7286, 7292	6-03-88	A.S.J.	<i>EHF</i>
3C		15	REV. 105+18 RT. REV. 105+75 RT. REV. 106+12 RT. REV. 106+28 RT. REV. 106+33 RT. REV. 106+16 RT. REV. 105+18 RT.	REV. 107+57 RT. REV. 106+03 RT. REV. 107+18 RT.	0.13 A±		ALL R.T. & I. CONST. EASE. (T) (48 SF±) DRIVE (T) REMOVE & RESET (T) CUL. & DR. (P) CONST. EASE. (T) (310 SF±) REMOVE & RESET (T)						HWY. EASE. VT. RTE. 128 14' GRAVEL MP 0196 SIGN * VERMONT TURKEY FARM * (PERS.) WOOD RAIL FENCE	24	10, 20, 21	PARCEL 15 JARVIS DELETED SLOPE AT STA. 181+38 RT. ~ 182+27 PER. CO. 7293	6-03-88	A.S.J.	<i>EHF</i>
														25	10, 20, 21	PARCEL 16 MINOR DELETED SLOPE AT STA. 182+27 RT. 182+55 RT. DELETE SLOPE AT 182+70 RT. 185+20 RT. DELETE ALL R.T. & I. ON SEPTIC. CHANGE BEGIN. OF CONST. EASE. FROM 184+00 RT. 184+25 RT. AND AREA TO 0.04A± 1796 S.F.±. PER CO. 7294 AND CO. 7285	6-03-88	A.S.J.	<i>EHF</i>
														26	4, 7, 1	PARCEL NO. 6 WRIGHT. DELETE TWO REMOVE & RESET (T) RIGHTS AT REV. 105+14 RT. ~ REV. 105+18 RT. AND REV. 104+20 RT. ~ REV. 104+30 RT. TRANSFER THESE RIGHTS TO PARCEL 3C & 3A, RESPECTIVELY. PER C.O. 7304	6-17-88	M.J.R.	<i>ggm</i>
														27	16	PARCEL NO. 5 STARK. CHANGE NOTE FROM 1" COPPER W/L APPROX. LOCATION TO 3/4" HEAVY BLACK PLASTIC W/L APPROX. LOCATION. PER C.O. 7295	6-17-88	M.J.R.	<i>ggm</i>
														28	7, 15	PARCEL NO. 6 WRIGHT. DELETE PARCEL 6A CHANGE 6B TO 6. PER C.O. 7347	7-26-88	M.J.R.	<i>ggm</i>
														29	6, 17	PARCEL 5 STARK. REVISED STA. FOR SEWER-LINE FROM REV. 126+44 LT. ~ REV. 126+50 RT. TO REV. 126+54 LT. ~ REV. 126+60 RT. LEACH-FIELD FROM REV. 126+50 RT. TO REV. 126+60 RT. PER CO. 7310	8-3-88	A.S.J.	<i>ggm</i>
														30		PARCEL 19 CHITTENDEN TRUST CO. TITLE CHANGE FROM TRI-ENTERPRISE INC. TO CHITTENDEN TRUST CO. PER CO. 7376	9-06-88	A.S.J.	<i>ggm</i>
														31	11, 21	PARCEL 18 BOUFFARD CHANGE SLOPES FROM (T) TO (P) PER C.O. 7363	9-28-88	M.J.R.	<i>ggm</i>

BY: A. JONES DATE 6/10/87

CHECKED BY: K. PERKINS DATE 6/10/87
170,113 RDGET LY 11/3, 20, 83
PROP. ADM. 5-87 VO 140, 89DR. RT.- DRAINAGE RIGHT
DIT. RT.- DITCHING RIGHT
CH. RT.- CHANNEL RT.
DRIVE RT.- DRIVE RIGHT
CUL. RT.- CULVERT RIGHT
(D) - DEMOLITION OR REMOVAL
(W) - WATER SOURCESPRESENT R.O.W.
TAKING WITHOUT ACCESS
TAKING WITHOUT ACCESS ALONG PROPERTY LINE
TAKING WITH ACCESS
PERMANENT EASEMENT
TEMPORARY EASEMENT

LEGEND

CONST. EASE.
SR SR
P SR
L
TOE OF SLOPECONSTRUCTION EASEMENT
SLOPE RIGHTS
PROPERTY LINE
TOP OF CUT

R. O. W. PLANS

APPROVED: *James R. Jones* DATE: 7-2-87
AGENT D. PLANS & TITLESWESTFORD
RS 0229(5)
SHEET 4 OF 21

STATE OF VERMONT
AGENCY OF TRANSPORTATION
RIGHT OF WAY PLANS
DETAIL SHEET

TABLE OF PROJECT PROPERTY ACQUISITION

PARCEL NO.	GRANTOR	SHEET NO.	BEGINNING STATION	ENDING STATION	TAKING	REM.	RIGHTS	TITLE TAKEN	DATE	TOWN OR CITY RECORDED	BK.	PG.	REMARKS	REVISION NO.	SHEET NO.	DESCRIPTION OF REVISION	DATE	MADE BY	APPROVED BY
4A	PERRY, RONALD B. & PAULINE V.	15	98+91 LT. 98+91 LT. 99+85 LT. 98+91 LT. 98+91 LT.	REV. 101+54 LT. 99+73 LT. REV. 101+54 LT. 99+45 LT.	0.06A±		CONST. EASE. (T) (0.01 A ±)	WD	7/19/88	WESTFORD	56	19	2751 SF± 400 SF± 12' GRAVEL DRIVE MP 0184 230 SF±	32	4,15	PARCEL NO.3 FOSS. ADD DRIVE (T) AT STA. 103+50 RT. PER C.O. 7432	11-2-88	M.J.R.	<i>[Signature]</i>
4B		15	98+91 LT.	REV. 101+54 LT.	0.15A±		SLOPE (P) (0.01 A ±)						HWY. EASE. VT. RTE. 128	33	8,17 18	PARCEL NO. 10 POULIOT. DELETE DRIVE AT 145+70 RT. & DRIVE AT 153+54 RT. ADD CUL. (P) FROM 144+90 RT. 145+10 RT. ADD DRAIN (P) AT 144+90 RT. ADD DRIVE (T) AT 145+27 RT. AND ONE AT 145+27 RT. PER C.O. 7453	11-21-88	M.J.R.	<i>[Signature]</i>
5A	STARK, JOHN N. & MARIAN A. TRUSTEES	15,16	REV. 101+54 LT. REV. 101+54 LT. REV. 103+13 LT. REV. 103+58 LT. REV. 104+83 LT. REV. 106+07 LT. REV. 112+77 LT. REV. 112+88 LT. REV. 113+00 LT. REV. 115+23 LT. REV. 116+35 LT. REV. 117+00 LT. REV. 117+25 LT. REV. 101+54 LT.	REV. 117+64 LT. REV. 102+87 LT. REV. 105+35 LT. REV. 104+30 LT. REV. 105+15 LT. REV. 108+95 LT. REV. 117+50 LT. REV. 113+16 LT. REV. 117+00 LT. REV. 118+20 LT. REV. 111+00 RT.	0.70A±		ALL R.T. & I. CONST. EASE. (T) (0.02A±) CONST. EASE. (T) (0.04A±) SLOPE (P) (305 SF±) SLOPE (P) (72 SF±) CONST. EASE. (T) (0.02A±) CONST. EASE. (T) (0.07A±) DITCH (P) (0.01A±) DRAINAGE (P) SLOPE (P) (0.02A±) CUL. & DIT. (P) CUL. & DR. (P) DITCH (P) (269 SF±)	COND	11/22/88	WESTFORD	56	546	STONEWALL AND FENCE 951 SF± 878 SF± 3486 SF± 402 SF± 1104 SF± STONEWALL	34	10,21	PARCEL NO. 14 TOWN OF WESTFORD. ADD NEW PARCEL 14A. CUL. & DR. (P). STA. 143+25 LT. PER C.O. 7939	6-20-90	C.C.P.	<i>[Signature]</i>

BY: A. JONES DATE 6/8/87
CHECKED BY: K. PERKINS DATE 6/8/87
170,113,004,007 LV 1, 21, 63 MO 140, 89
PROP. ADJ. 5-87

DR. RT.- DRAINAGE RIGHT
DIT. RT.- DITCHING RIGHT
CH. RT.- CHANNEL RT.
DRIVE RT.- DRIVE RIGHT
CUL. RT.- CULVERT RIGHT
(D)- DEMOLITION OR REMOVAL
(W)- WATER SOURCES

PRESENT R.O.W.
TAKING WITHOUT ACCESS
TAKING WITHOUT ACCESS ALONG PROPERTY LINE
TAKING WITH ACCESS
PERMANENT EASEMENT
TEMPORARY EASEMENT

LEGEND
--- CONST. EASE. --- CONSTRUCTION EASEMENT
--- SR --- SLOPE RIGHTS
--- P --- PROPERTY LINE
--- L --- TOP OF CUT
--- --- TOE OF SLOPE

R. O. W. PLANS

APPROVED: [Signature] DATE: 7-2-87
AGENT D. PLANS & TITLES

WESTFORD
RS 0229(5)
SHEET 5 OF 21

STATE OF VERMONT
AGENCY OF TRANSPORTATION
RIGHT OF WAY PLANS
DETAIL SHEET

PARCEL NO.	GRANTOR	SHEET NO.	BEGINNING STATION	ENDING STATION	TAKING	REM.	RIGHTS	TITLE TAKEN	DATE	TOWN OR CITY RECORDED	BK.	PG.	REMARKS	REVISION NO.	SHEET NO.	DESCRIPTION OF REVISION	DATE	MADE BY	APPROVED BY
5B	STARK, JOHN N. & MARIAN A., TRUSTEES (CONTINUED)	15,16,17	REV. 112 + 49 RT. REV. 111 + 92 RT. REV. 112 + 00 RT. REV. 112 + 12 RT. REV. 113 + 35 RT. REV. 113 + 43 RT. REV. 114 + 00 RT. REV. 115 + 50 RT. REV. 116 + 35 RT. REV. 118 + 10 RT. REV. 118 + 16 RT. REV. 118 + 40 RT. REV. 120 + 50 RT. REV. 123 + 18 RT. REV. 123 + 07 RT. REV. 124 + 70 RT. REV. 124 + 74 RT. REV. 125 + 06 RT. REV. 125 + 25 RT. REV. 126 + 60 RT. REV. 130 + 50 RT. REV. 131 + 00 RT. REV. 131 + 54 RT. REV. 131 + 54 RT.	REV. 132 + 50 RT. REV. 117 + 42 RT. REV. 113 + 25 RT. REV. 113 + 33 RT. REV. 115 + 50 RT. REV. 116 + 35 RT. REV. 117 + 00 RT. REV. 124 + 63 RT. REV. 119 + 50 RT. REV. 123 + 00 RT. REV. 123 + 40 RT. REV. 130 + 00 RT. REV. 125 + 10 RT. REV. 127 + 50 RT. REV. 132 + 50 RT. REV. 131 + 54 RT. REV. 131 + 90 RT.	1.09 A±		CONST. EASE. (T)(0.12 A±) DITCH (P) (0.02 A±) DRIVE (T) DITCH (P) (259 S.F.±) SLOPE (P) (0.02 A±) CUL. DIT. & DR. (P) DRIVE (T) CONST. EASE. (T)(0.12 A±) SLOPE (P) (0.04 A±) SLOPE (P) (165 S.F.±) DRIVE (T) DRIVE (T) CONST. EASE. (T)(0.09 A±) SLOPE (T) (0.03 A±) CONST. EASE. (T)(0.04 A±) SLOPE (T) (0.01 A±) DIT. & DR. (P) CULVERT (P)						STONEWALL (769 S.F.±) 14' GRAVEL M.P. 0210 STONEWALL (865 S.F.±) 14' GRAVEL M.P. 0219 STONEWALL (1698 S.F.±) 20' GRAVEL M.P. 0228 12' GRAVEL M.P. 0231 (3963 S.F.±) WATERLINE (1525 S.F.±) LEACHFIELD (1742 S.F.±) (408 S.F.±)						
5C		17	REV. 133 + 14 LT. REV. 136 + 95 LT.	REV. 138 + 00 LT. REV. 138 + 00 LT.	0.10A±		CONST. EASE. (T)(0.01 A±)						(436 S.F.±)						
5D		15,16,17	REV. 101 + 54 LT. REV. 118 + 22 LT. REV. 125 + 10 RT. REV. 125 + 15 LT. REV. 126 + 54 RT. REV. 127 + 00 LT. REV. 127 + 87 LT. REV. 131 + 54 LT. REV. 131 + 80 LT. REV. 132 + 50 LT.	REV. 138 + 00 LT. REV. 125 + 17 RT. REV. 126 + 60 RT. REV. 133 + 21 LT. REV. 128 + 87 LT. REV. 132 + 35 LT.	3.60A±		ALL R.T. & L. DRIVE (T) DRIVE (T) CONST. EASE. (T)(0.10 A±) SLOPE (P) (0.01 A±) CULVERT (P) SLOPE (T) (120 S.F.±) DRAINAGE (P)						HWY.EASE. VT.RTE. 128 14' GRAVEL M.P. 0219 WATERLINE 16' GRAVEL M.P. 0232 SEWERLINE (772 S.F.±)						

CHECKED BY: <u>M.J.R.</u> DATE <u>6-10-87</u>		DR. RT.- DRAINAGE RIGHT DIT. RT.- DITCHING RIGHT CH. RT.- CHANNEL RT. DRIVE RT.- DRIVE RIGHT CUL. RT.- CULVERT RIGHT (D)- DEMOLITION OR REMOVAL (W)- WATER SOURCES		<u>///</u> <u>///</u> <u>///</u> <u>///</u> P L (P) (T)		PRESENT R.O.W. TAKING WITHOUT ACCESS TAKING WITH ACCESS PERMANENT EASEMENT TEMPORARY EASEMENT		LEGEND ---- CONST. EASE. ---- SR SR P L O O O		SLOPE RIGHTS PROPERTY LINE TOP OF CUT TOE OF SLOPE		APPROVED: <u>Lawrence W. Bell</u> DATE: <u>7-2-87</u> AGENT D. PLANS & TITLES		WESTFORD RS 0229 (5) SHEET <u>6</u> OF 21	
---	--	--	--	---	--	---	--	--	--	---	--	--	--	---	--

5

STATE OF VERMONT
AGENCY OF TRANSPORTATION
RIGHT OF WAY PLANS
DETAIL SHEET

6

STATE OF VERMONT
AGENCY OF TRANSPORTATION
RIGHT OF WAY PLANS
DETAIL SHEET

[illegible]

TABLE OF PROJECT PROPERTY ACQUISITION

STATE OF VERMONT
AGENCY OF TRANSPORTATION
RIGHT OF WAY PLANS
DETAIL SHEET

DETAIL SHEET

PARCEL NO.	GRANTOR	SHEET NO.	BEGINNING STATION	ENDING STATION	TAKING	REM.	RIGHTS	TITLE TAKEN	DATE	TOWN OR CITY RECORDED	BK.	PG.	REMARKS	REVISION	SHEET	DESCRIPTION OF REVISION	DATE	MADE BY	APPROVED BY
12A	LAVALLEE, ROGER L. & ELAINE S.	19, 20	REV. 162+63 RT. REV. 162+63 RT. REV. 162+95 RT. REV. 163+00 RT. REV. 164+06 RT. 170+87 RT. 170+18 RT. 174+50 RT. 175+06 RT. 175+50 RT.	177+26 RT. REV. 169+70 RT. REV. 163+13 RT. REV. 165+45 RT. 173+45 RT. 176+25 RT.	0.37A±		CONST. EASE. (T) (0.12A±) SLOPE (T) (19 SF±) DRIVE (T) SLOPE (T) (0.02A±) CUL. DIT. & DR. (P) CONST. EASE. (T) (0.03A±) DRIVE (T) CONST. EASE. (T) (0.01A±) CUL. & DR. (P)	COND	11-22-88	WESTFORD	56	546	12' GRAVEL MP 0305 1020 SF± 1385 SF± 12' GRAVEL MP 0325 561 SF±						
12B		19, 20 21	REV. 164+20 LT. REV. 164+20 LT. 167+50 LT. 169+50 LT. 169+55 LT. 176+45 LT. 177+00 LT. 178+52± LT 178+60± LT 179+23 LT. 183+33 LT. 185+70 LT. 187+39 LT. 187+48 LT. 187+00 LT.	187+82 LT. 169+45 LT. 171+65 LT 178+00 LT. 187+00 LT. 184+20 LT. 187+45 LT	0.57A±		CONST. EASE. (T) (0.05A±) DRAINAGE (P) DRIVE (T) CONST. EASE. (T) (0.01A±) CONST. EASE. (T) (0.02A±) CONST. EASE. (T) (0.15A±) SLOPE (T) (334 SF±) DRAINAGE (P) CULVERT (P) CUL. DIT. & DR. (P) DRIVE (T)						2396 SF± 12' GRAVEL MP 0316 480 SF± 779 SF± 12' GRAVEL DRIVE MP 0330 CONC. FOUNDATION CONC. FOUNDATION 12' GRAVEL MP 0349						
12C		21	189+63 RT. 189+63 RT. 189+63 RT. 190+65 RT. 191+88 RT.	192+08 RT. 191+57 RT. 191+40 RT.	0.03A±		CONST. EASE. (T) (0.04A±) SLOPE (T) (0.03A±) CUL. & DR (P) DRIVE (T)						1470 SF± 1786 SF± 1350 SF± 12' GRAVEL MP 0358						
12D		19, 20 21	REV. 162+62 C	187+82 LT.	2.25 A±		ALL R. T. & I.						HWY. EASE. VT. RTE. 128						
12E		21	189+63 C	192+08 RT.	0.14A±		ALL R. T. & I.						HWY. EASE. VT. RTE. 128						
12F		20	177+25 RT.	177+74 RT.	0.01A±		ALL R. T. & I.						6000 SF± HWY. EASE. T. H. #19						

DR. RT.- DRAINAGE RIGHT

(70.11) RUMFET LY-1, 13-15, 20, 22, 63 NO 140, 120

MADE BY: JONES DATE 6/8/87

ED BY: K. PERKINS DATE 6/8/87

PROP. ADJEN. 5-87 (70.11) RUMFET LY-1, 13-15, 20, 22, 63

DR. RT.- DRAINAGE RIGHT
DIT. RT.- DITCHING RIGHT
CH. RT.- CHANNEL RT.
DRIVE RT.- DRIVE RIGHT
CUL. RT.- CULVERT RIGHT
(D)- DEMOLITION OR REMOVAL
(W)- WATER SOURCES--- --
--- P ---
--- L ---
(P)
(T)PRESENT R.O.W.
TAKING WITHOUT ACCESS
TAKING WITHOUT ACCESS ALONG PROPERTY LINE
TAKING WITH ACCESS
PERMANENT EASEMENT
TEMPORARY EASEMENT

LEGEND

--- CONST. EASE. ---
SR SR
P
LCONSTRUCTION EASEMENT
SLOPE RIGHTS
PROPERTY LINE
TOP OF CUT
TOE OF SLOPEAPPROVED: *Samuel A. B.* DATE: 7-2-87
AGENT O. PLANS & TITLESWESTFORD
RS 0229(5)
SHEET 9 OF 21

STATE OF VERMONT
AGENCY OF TRANSPORTATION
RIGHT OF WAY PLANS
DETAIL SHEET

PARCEL NO.	GRANTOR	SHEET NO.	BEGINNING STATION	ENDING STATION	TAKING	REM.	RIGHTS	TITLE TAKEN	DATE	TOWN OR CITY RECORDED	BK.	PG.	REMARKS	REVISION NO.	SHEET NO.	DESCRIPTION OF REVISION	DATE	MADE BY	APPROVED BY
13A	WATKINS, WARREN R. & CAROL H.	20	177 + 88 RT. 178 + 34 RT.	178 + 98 RT.	0.03 A±		DRIVE (T)	WD	8-9-88	WESTFORD	56	91	(1130 S.F.±) 12' GRAVEL M.P. 0332						
			177 + 62 RT.	178 + 98 RT.		3.99 A±													
13B		20	177 + 74 RT.	179 + 00 RT.	0.07 A±		ALL R.T. & L.						(2833 S.F.±) HWY. EASE. VT. RTE. 128						
13C		20	177 + 62 RT.	177 + 88 RT.	0.01 A±		ALL R.T. & L.						(200 S.F.±) HWY. EASE. T.H. 19						
14	WESTFORD, TOWN OF	20	177 + 25 RT. 177 + 50 RT.	177 + 88 RT.	0.02 A±		ALL R.T. & L. CONSTRUCT APPROACH (T)	QCD	7-21-88	WESTFORD	56	27	(673 S.F.±) HWY. EASE. T.H. 19 T.H. 19						
14A			193 + 25 LT.				CUL & DR (P)	QCD	6-12-90	WESTFORD									
15A	JARVIS, GORDON W. & JARVIS, HELEN C., LIFE ESTATE	20	178 + 98 RT. 178 + 98 RT. 178 + 98 RT. 181 + 04 RT.	182 + 23 RT. 180 + 00 RT. 180 + 95 RT.	0.08 A±		SLOPE (T) (0.01 A±) CONST. EASE. (T)(0.03 A±) DRIVE (T)	WD	10-21-88	WESTFORD	56	381	(3608 S.F.±) (515 S.F.±) (1524 S.F.±) 20' GRAVEL M.P. 0338						
			178 + 98 RT.	182 + 27 RT.		2.23 A±													
15B		20	178 + 98 RT.	182 + 27 RT.	0.19 A±		ALL R.T. & L.						HWY. EASE. VT. RTE. 128						
16A	MINOR, SHIRLEY J. & MADELINE L.	20,21	182 + 27 RT. 182 + 69 RT.	187 + 63 RT.	0.11 A±		DRIVE (T)	WD	10-17-88	WESTFORD	56	358	14' GRAVEL M.P. 0341						
			182 + 93 RT. 184 + 25 RT. 186 + 02 RT. 186 + 12 RT.	183 + 34 RT. 185 + 99 RT.			CONST. EASE. (T)(0.04 A±) DRIVE (T) CONST. EASE. (T)(0.03 A±)						CEDAR HEDGE (1796 S.F.±) 10' GRAVEL M.P. 0347 (1437 S.F.±)						
			182 + 27 RT.	187 + 63 RT.		1.77 A±													
16B		20,21	182 + 27 RT.	187 + 63 RT.	0.31 A±		ALL R.T. & L.						HWY. EASE. VT. RTE. 128						

DR. RT.- DRAINAGE RIGHT
DIT. RT.- DITCHING RIGHT
CH. RT.- CHANNEL RT.
DRIVE RT.- DRIVE RIGHT
CUL. RT.- CULVERT RIGHT
(D) - DEMOLITION OR REMOVAL
(W) - WATER SOURCES

PRESENT R.O.W.
TAKING WITHOUT ACCESS
TAKING WITH ACCESS
PERMANENT EASEMENT
TEMPORARY EASEMENT

LEGEND

-----CONST. EASE-----

SR SR

P

L

△ △ △

○ ○ ○

SLOPE RIGHTS
PROPERTY LINE
TOP OF CUT
TOE OF SLOPE

R.O.W. PLANS

APPROVED: Laurence W. Blum DATE: 7-2-87
AGENT D. PLANS & TITLES

WESTFORD
RS 0229 (5)
SHEET 10 OF 21

STATE OF VERMONT
AGENCY OF TRANSPORTATION
RIGHT OF WAY PLANS
DETAIL SHEET

PARCEL NO.	GRANTOR	SHEET NO.	BEGINNING STATION	ENDING STATION	TAKING	REM.	RIGHTS	TITLE TAKEN	DATE	TOWN OR CITY RECORDED	BK.	PG.	REMARKS	REVISION NO.	SHEET NO.	DESCRIPTION OF REVISION	DATE	MADE BY	APPROVED BY
17A	MOORE, TERRANCE G. & CAROL J.	21	187 + 63 RT. 187 + 63 RT.	189 + 63 RT. 188 + 00 RT.	0.03 A±		CONST. EASE. (T) (395 S.F.±)	WD	9/9/88	WESTFORD	56	263	(1114 S.F.±)						
			187 + 63 RT. 188 + 41 RT. 188 + 87+ RT. 189 + 53 RT. 189 + 59 RT.	188 + 30 RT. 189 + 63 RT.		0.43 A±	SLOPE (T) (0.03 A±) DRIVE (T) REMOVE & RESET (T) DRIVE (T) SLOPE (T) (18 S.F.±)						(1437 S.F.±) 20' GRAVEL M.P. 0352 WISHING WELL 14' GRAVEL M.P. 0354						
17B		21	187 + 63 RT.	189 + 63 RT.	0.12 A±		ALL R.T. & L.						HWY. EASE. VT. RTE. 128						
18A	BOUFFARD, RONALD & JOAN	21	187 + 82 LT. 187 + 82 LT. 188 + 66 LT. 188 + 70 LT. 189 + 00 LT. 189 + 95 LT.	193 + 20 LT. 188 + 56 LT. 189 + 85 LT. 189 + 85 LT.	0.08 A±		CONST. EASE. (T) (380 S.F.±) DRIVE (T) CONST. EASE. (T) (0.01 A±) SLOPE (P) (152 S.F.±)	COND	11/22/88	WESTFORD	56	546	(3510 S.F.±) 14' GRAVEL M.P. 0352 (600 S.F.±) 14' GRAVEL DRIVE M.P. 0355 (1200 S.F.±)						
18B		21	187 + 82 LT.	193 + 21 L	0.31 A±		ALL R.T. & L.						HWY. EASE. VT. RTE. 128						
19A	CHITTENDEN TRUST CO.	21	192 + 08 RT. 192 + 22 RT.	192 + 50 RT.	0.01 A±			COND	11/22/88	WESTFORD	56	546	(252 S.F.±) 12' GRAVEL DRIVE M.P. 0359						
19B		21	192 + 08 L	193 + 21 L	0.06 A±		ALL R.T. & L.						(2500 S.F.±) HWY. EASE. VT. RTE. 128						

Mr. M.J.R. DATE 6-10-87
CHECKED BY: K.D.P. DATE 6-10-87

DR. RT.- DRAINAGE RIGHT
DIT. RT.- DITCHING RIGHT
CH. RT.- CHANNEL RT.
DRIVE RT.- DRIVE RIGHT
CUL. RT.- CULVERT RIGHT
(D) - DEMOLITION OR REMOVAL
(W) - WATER SOURCES

PRESENT R.O.W.
TAKING WITHOUT ACCESS
TAKING WITH ACCESS
PERMANENT EASEMENT
TEMPORARY EASEMENT

LEGEND

--- CONST. EASE. ---
SR SR
P
L
SLOPE RIGHTS
PROPERTY LINE
TOP OF CUT
TOE OF SLOPE

ROW PLANS

APPROVED: *Lawrence B. Bl...* DATE: 7-2-87
AGENT D. PLANS & TITLES

WESTFORD
RS 0229 (5)
SHEET 11 OF 21

TABLE OF PROJECT PROPERTY ACQUISITION

STATE OF VERMONT
AGENCY OF TRANSPORTATION
RIGHT OF WAY PLANS
DETAIL SHEET

PARCEL NO.	GRANTOR	SHEET NO.	BEGINNING STATION	ENDING STATION	TAKING	REM.	RIGHTS	TITLE TAKEN	DATE	TOWN OR CITY RECORDED	BK.	PG.	REMARKS	REVISION NO.	SHEET NO.	DESCRIPTION OF REVISION	DATE	MADE BY	APPROVED BY
20	VERMONT ELECTRIC CO-OP, INC.							COND	11-22-88	WESTFORD	56	546	UTILITY						
21	CENTRAL VERMONT PUBLIC SERVICE CORP.							COND	11-22-88	WESTFORD	56	546	UTILITY						
22	NEW ENGLAND TELEPHONE CO.							COND	11-22-88	WESTFORD	56	546	UTILITY						
	MAINTENANCE AGREE AREA NO. 1	20	177+50 RT.	177+50 RT.									TOWN HIGHWAY #19 LENGTH (20')						
23A	ROMAN CATHOLIC DIOCESE OF BURLINGTON, VT. INC.	19	REV. 162+70 LT. REV. 162+70 LT. REV. 162+70 LT.	REV. 164+20 LT. REV. 164+20 LT. REV. 164+20 LT.	(0.03A±)	(1.26A±)	CONST. EASE. (T) (0.01A±)	WD	6-30-88		55	425	1500 S.F. ± 753 S.F. ±						
23B		19	REV. 162+70 LT.	REV. 164+20 LT.	(0.08A±)		ALL R.T. & L.						3750 S.F. ± HWY. EASE. VT. RTE. 128						

170... LY-23 VO 140.89
MADE BY: A. JONES DATE 6/10/87
CHECKED BY: K. PERKINS DATE 6/10/87
PROP. ADMIN. 5-87

DR. RT.- DRAINAGE RIGHT
DIT. RT.- DITCHING RIGHT
CH. RT.- CHANNEL RT.
DRIVE RT.- DRIVE RIGHT
CUL. RT.- CULVERT RIGHT
(D)- DEMOLITION OR REMOVAL
(W)- WATER SOURCES

PRESENT R.O.W.
TAKING WITHOUT ACCESS
TAKING WITHOUT ACCESS ALONG PROPERTY LINE
TAKING WITH ACCESS
PERMANENT EASEMENT
TEMPORARY EASEMENT


LEGEND


--- CONST. EASE. ---
SR SR CONSTRUCTION EASEMENT
P SLOPE RIGHTS
L PROPERTY LINE
-TOP OF CUT
--- TOE OF SLOPE



R. O. W. PLANS


APPROVED: *[Signature]* DATE: 7-1-87
AGENT D. PLANS & TITLES

WESTFORD
RS 0229(5)
SHEET 12 OF 21

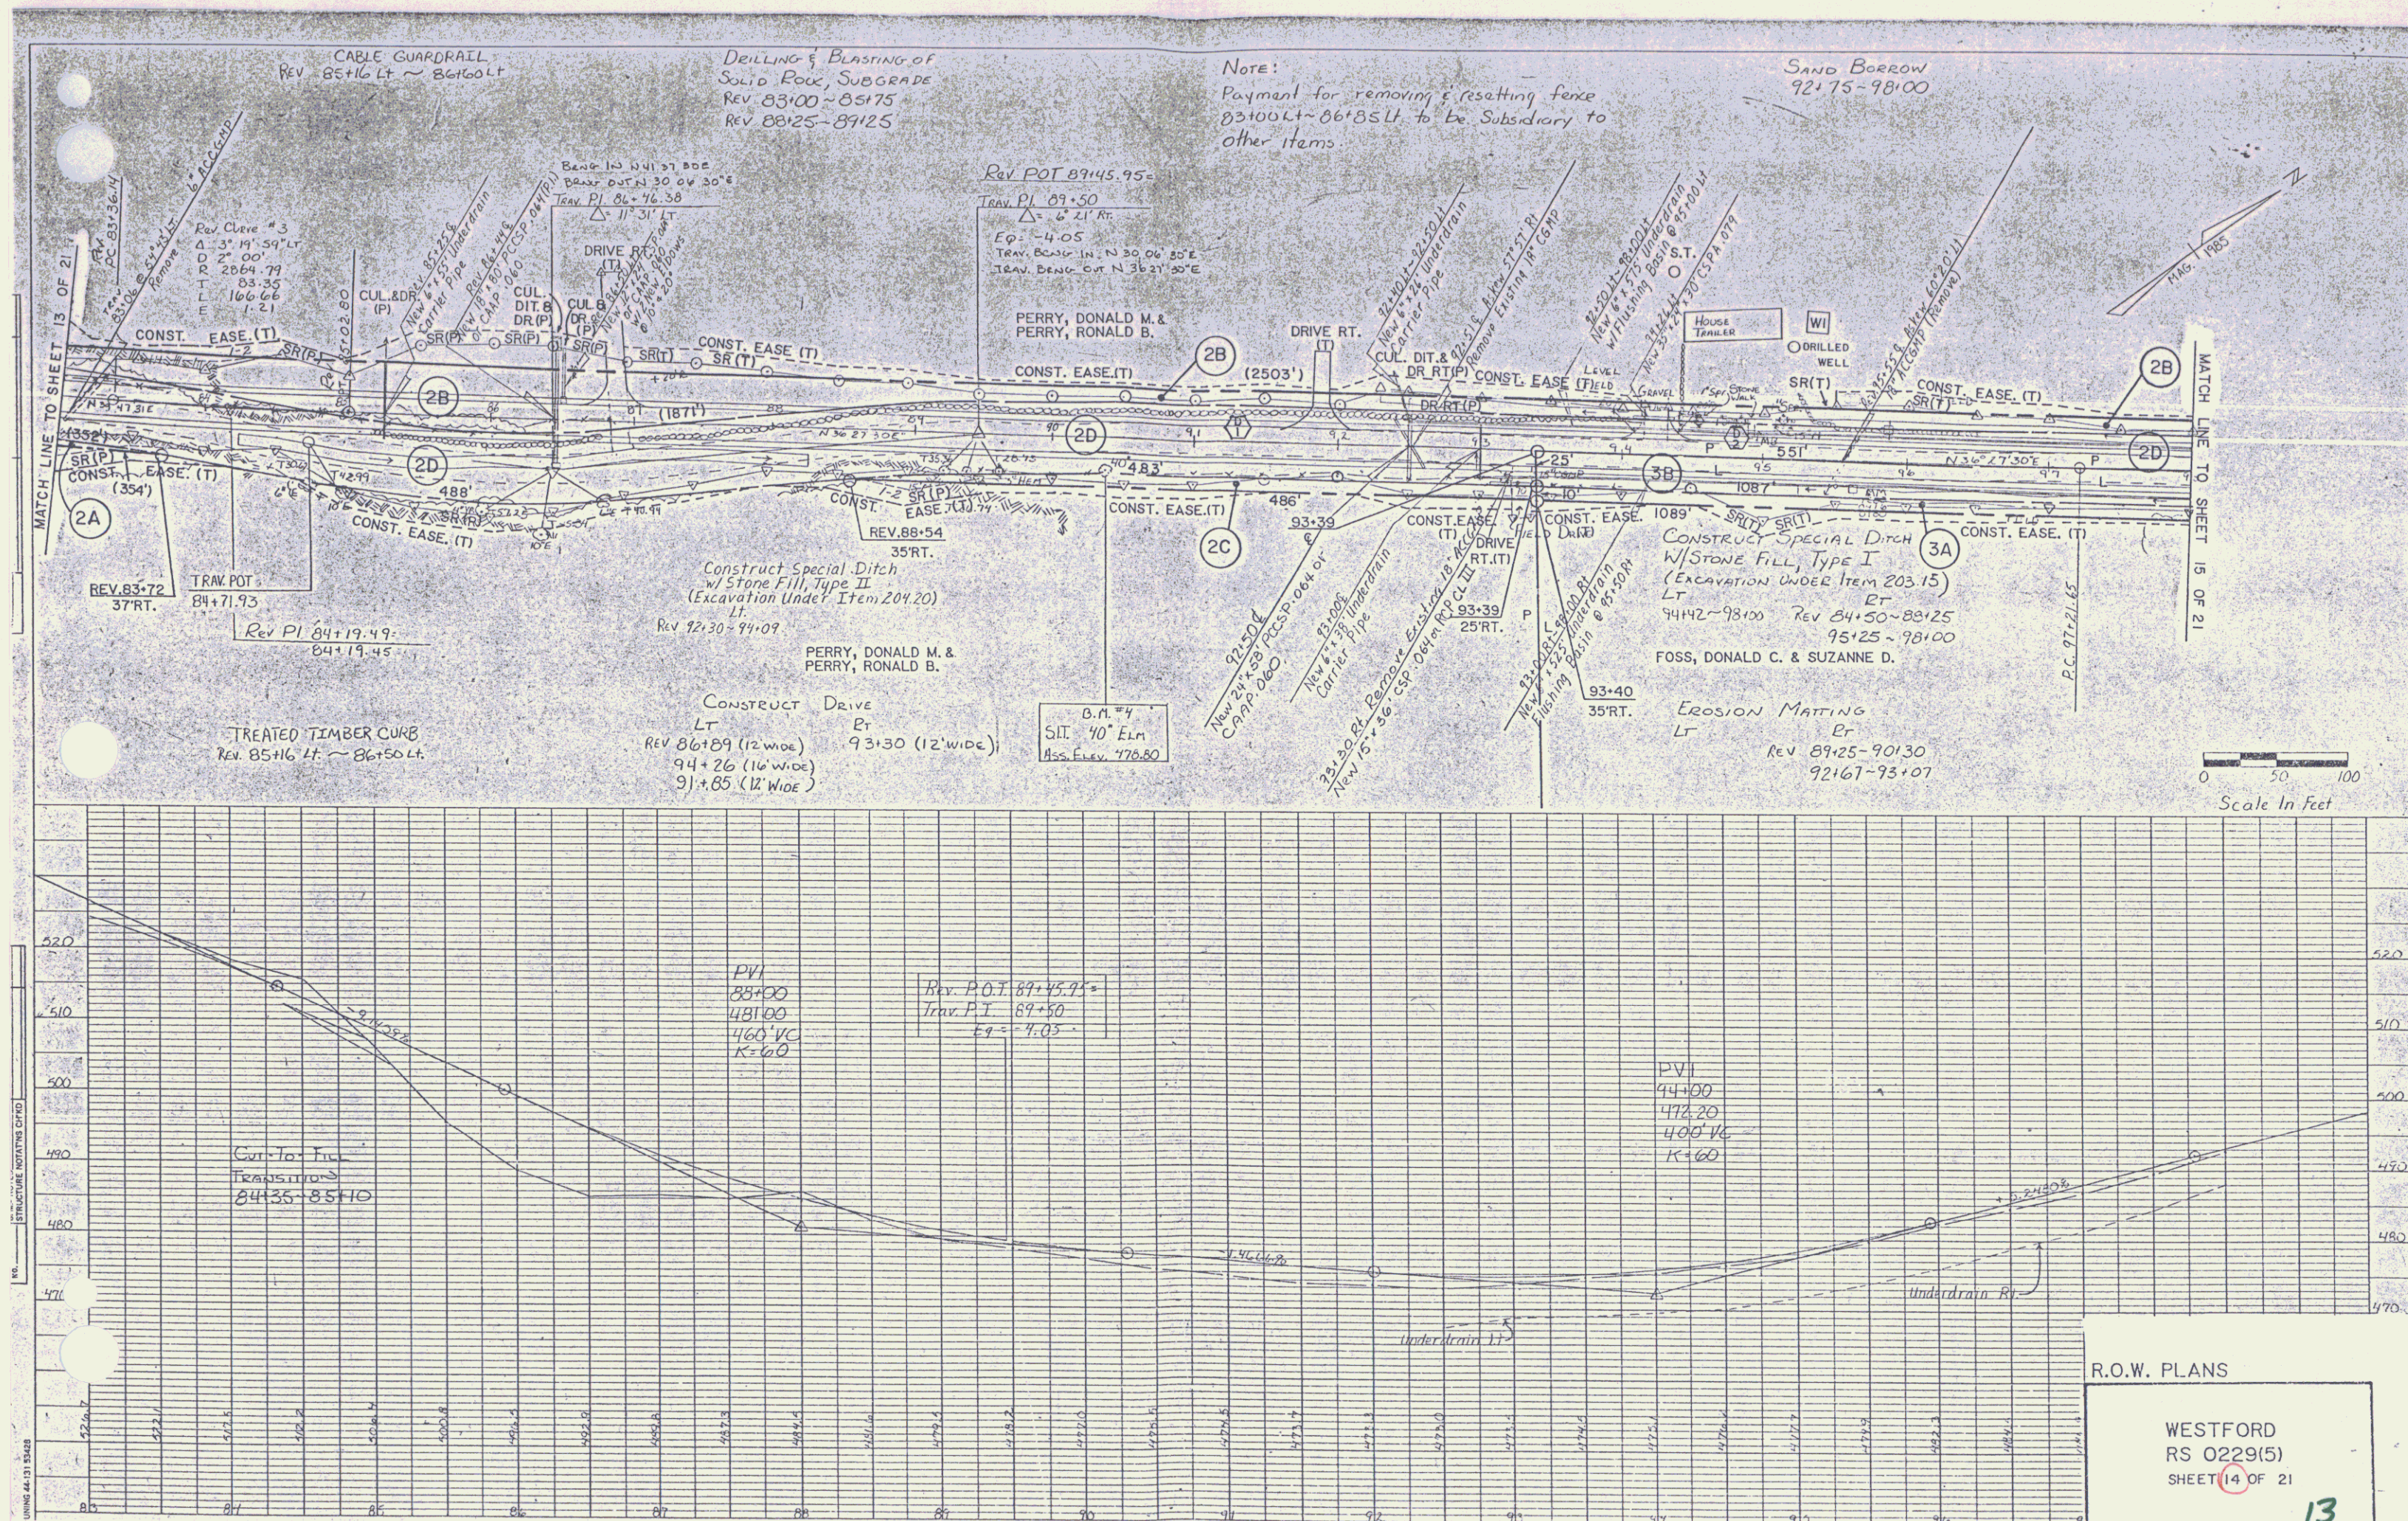

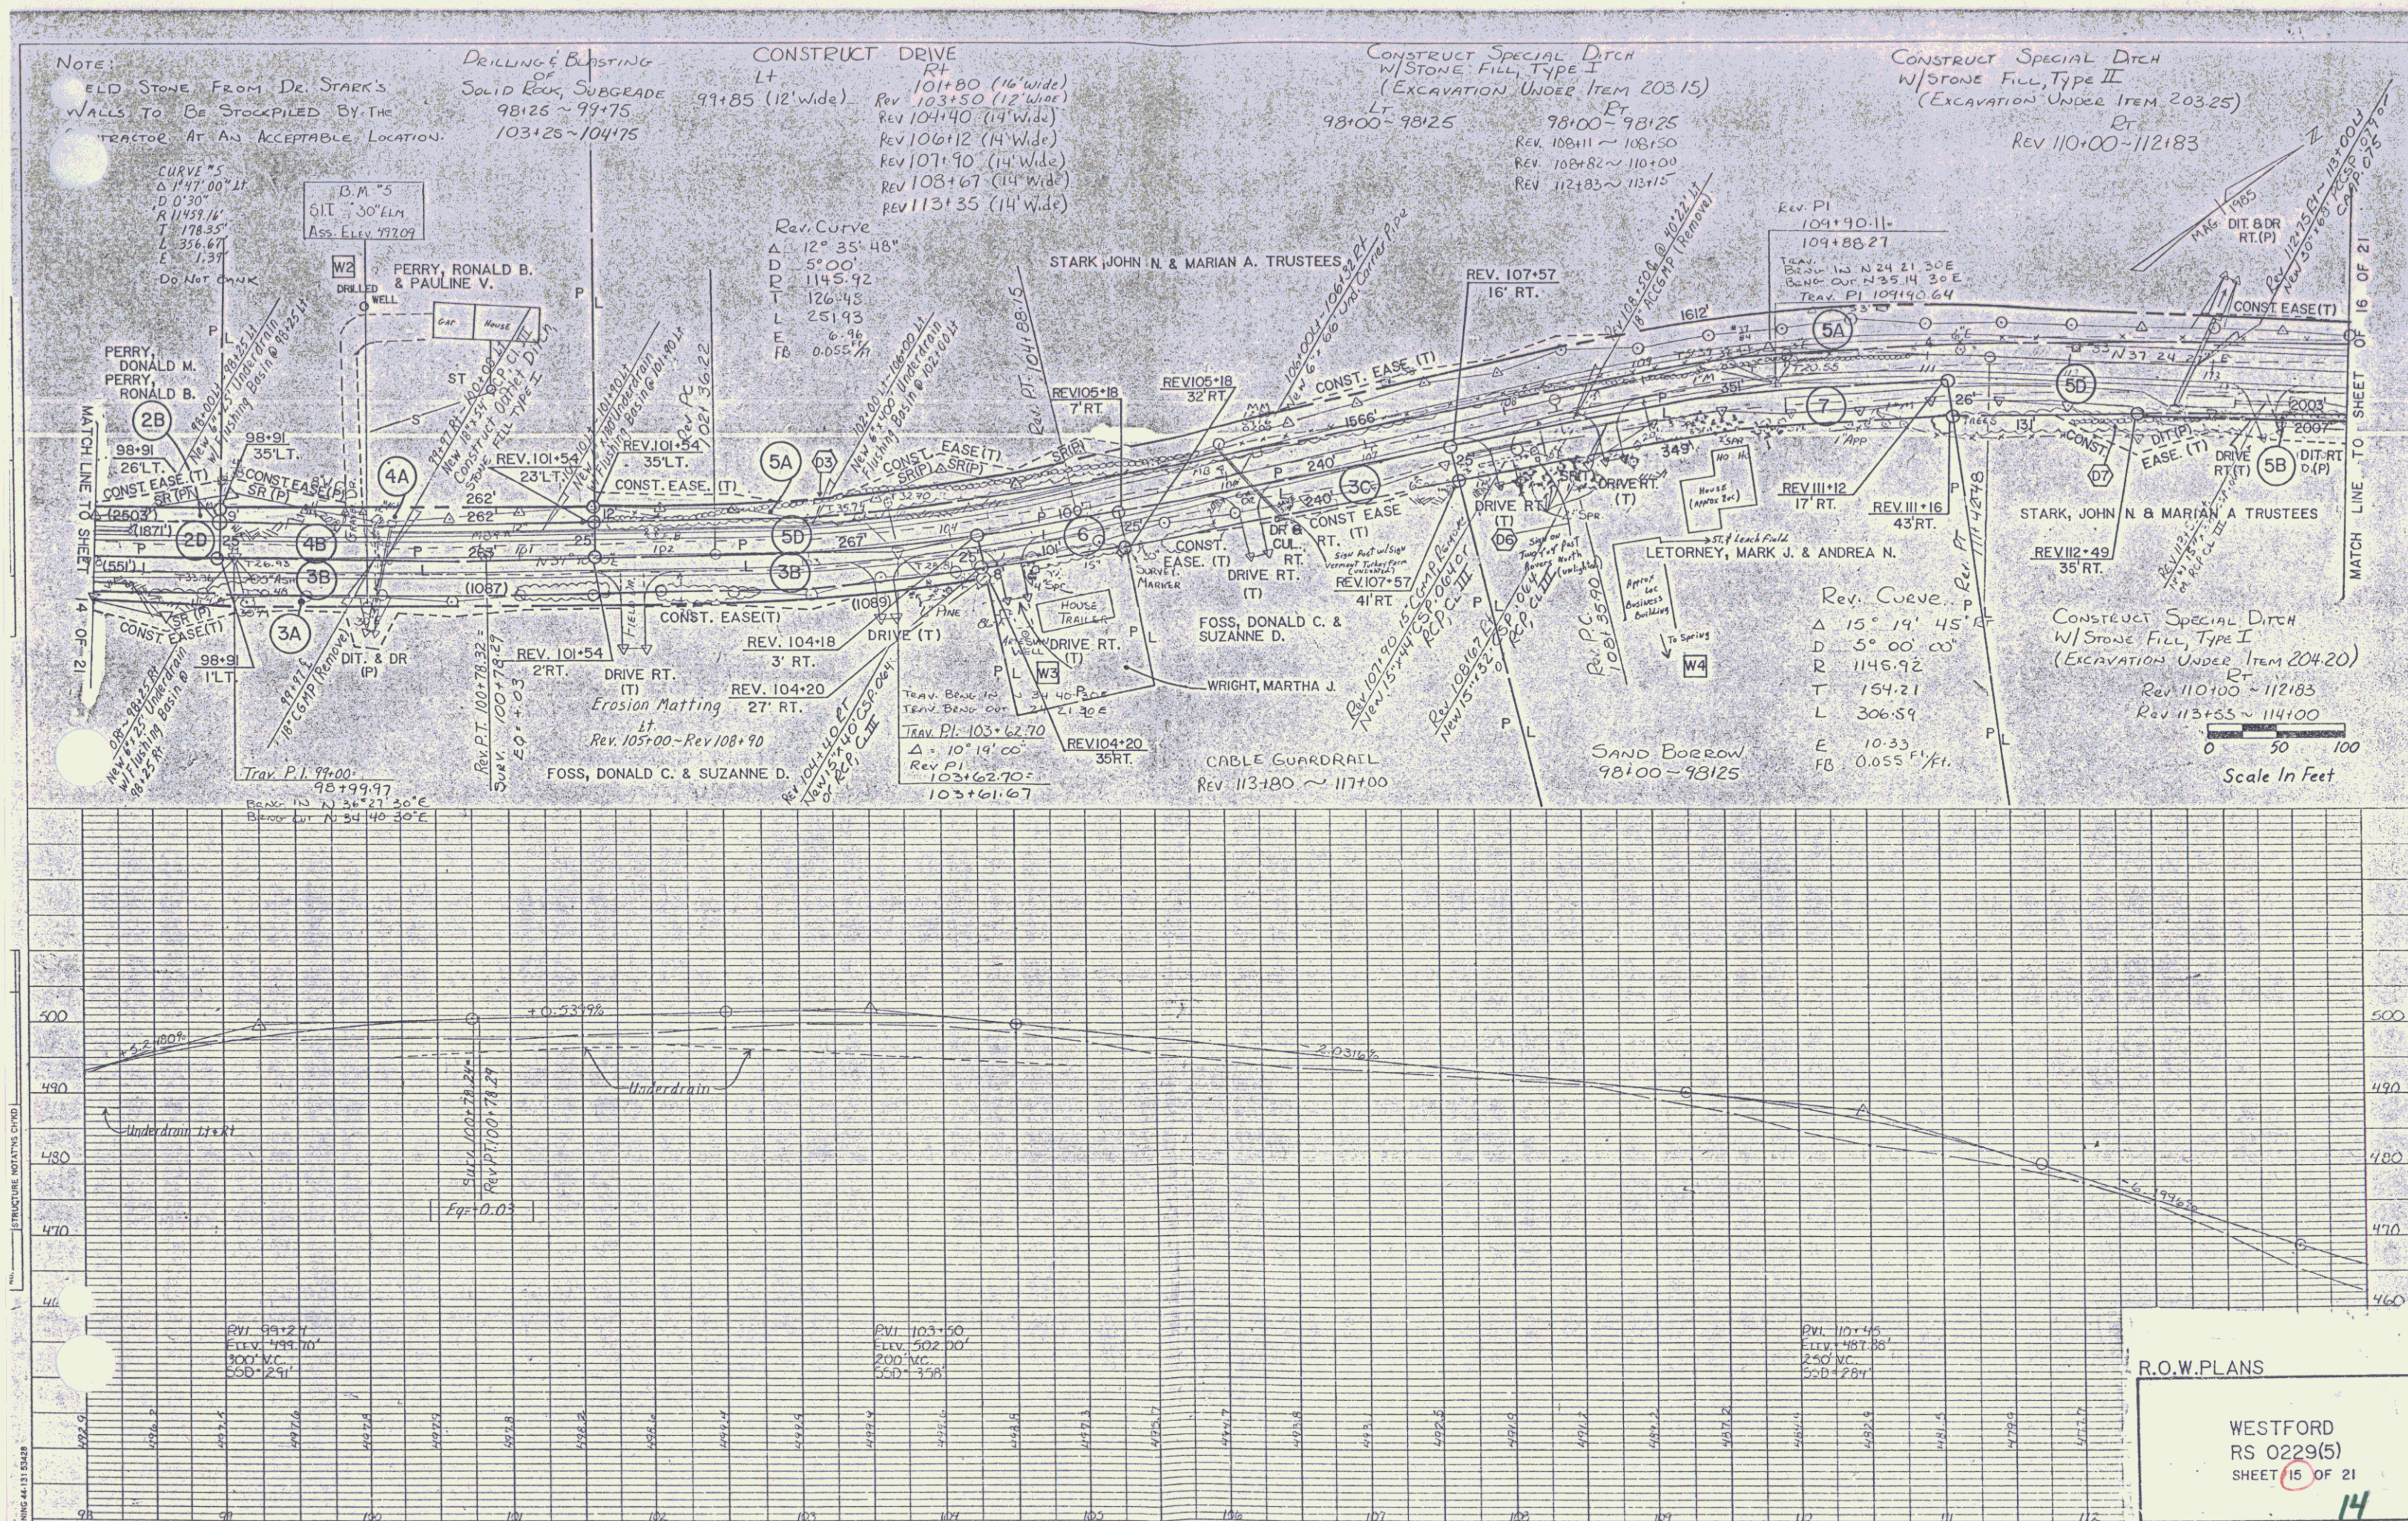

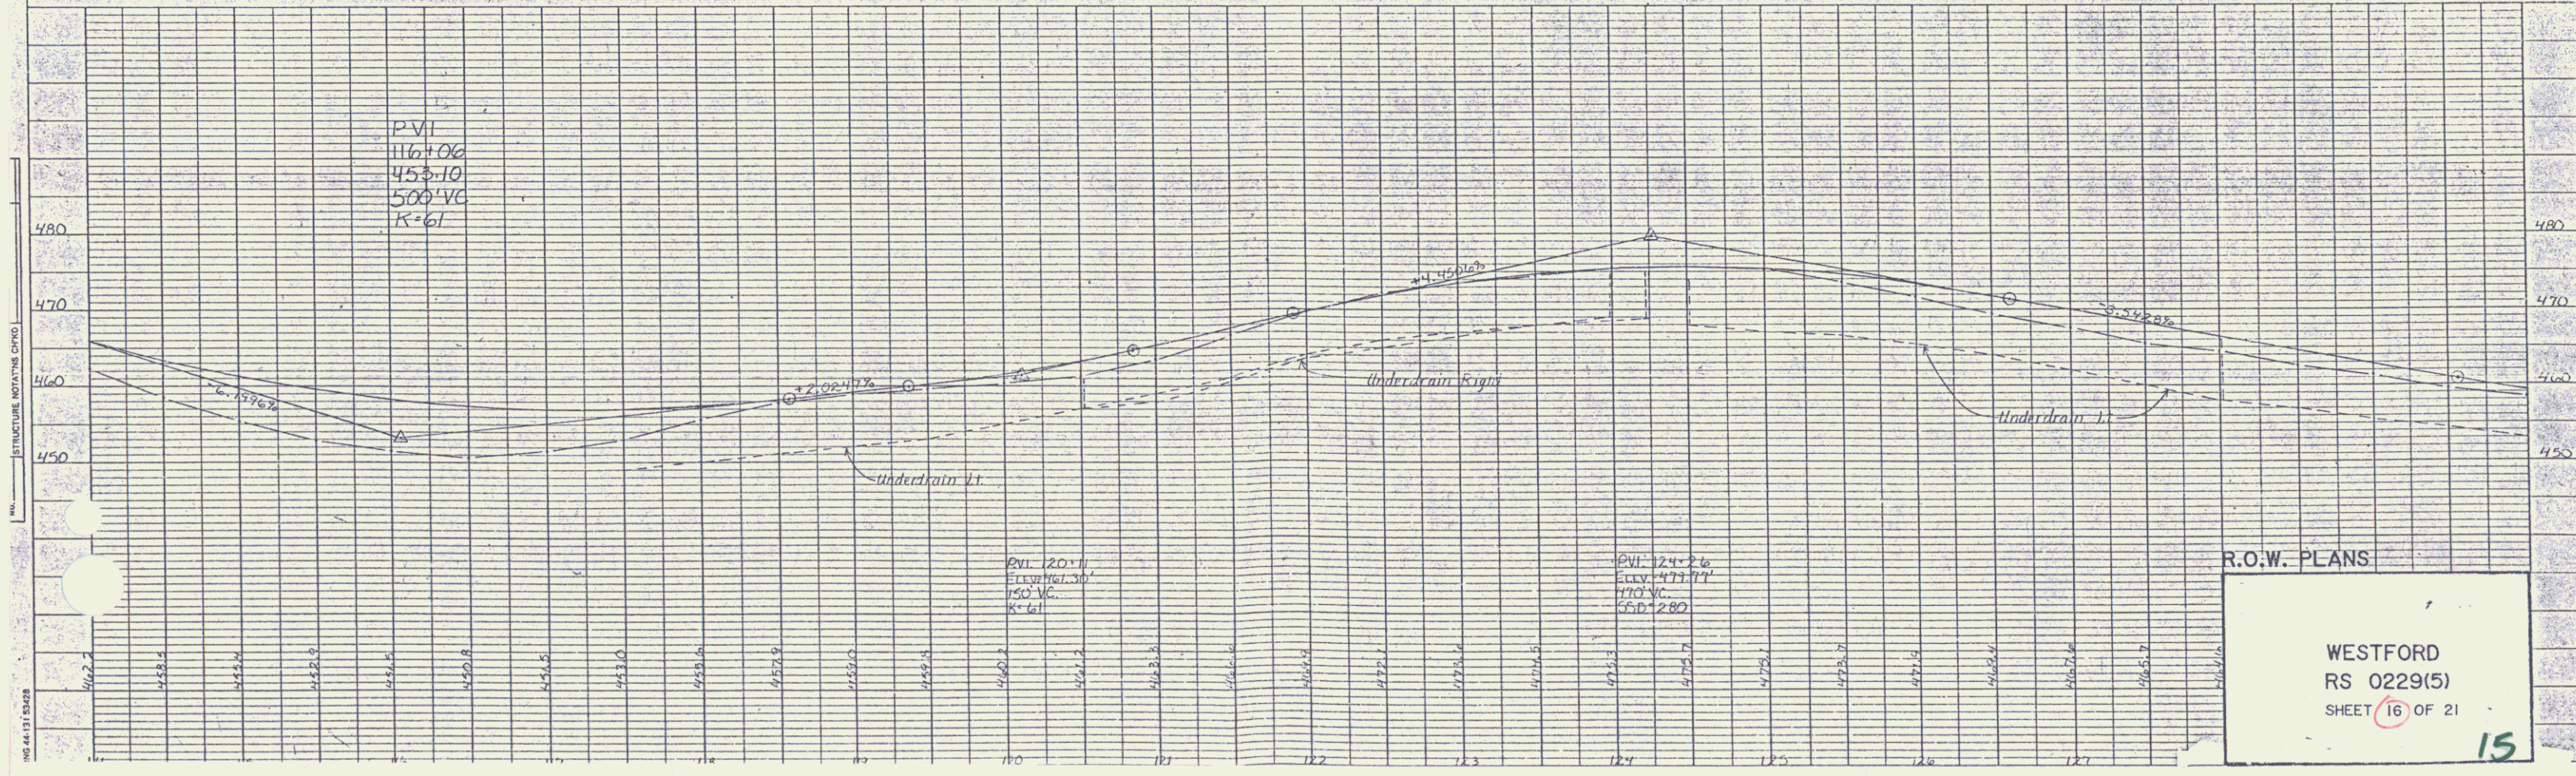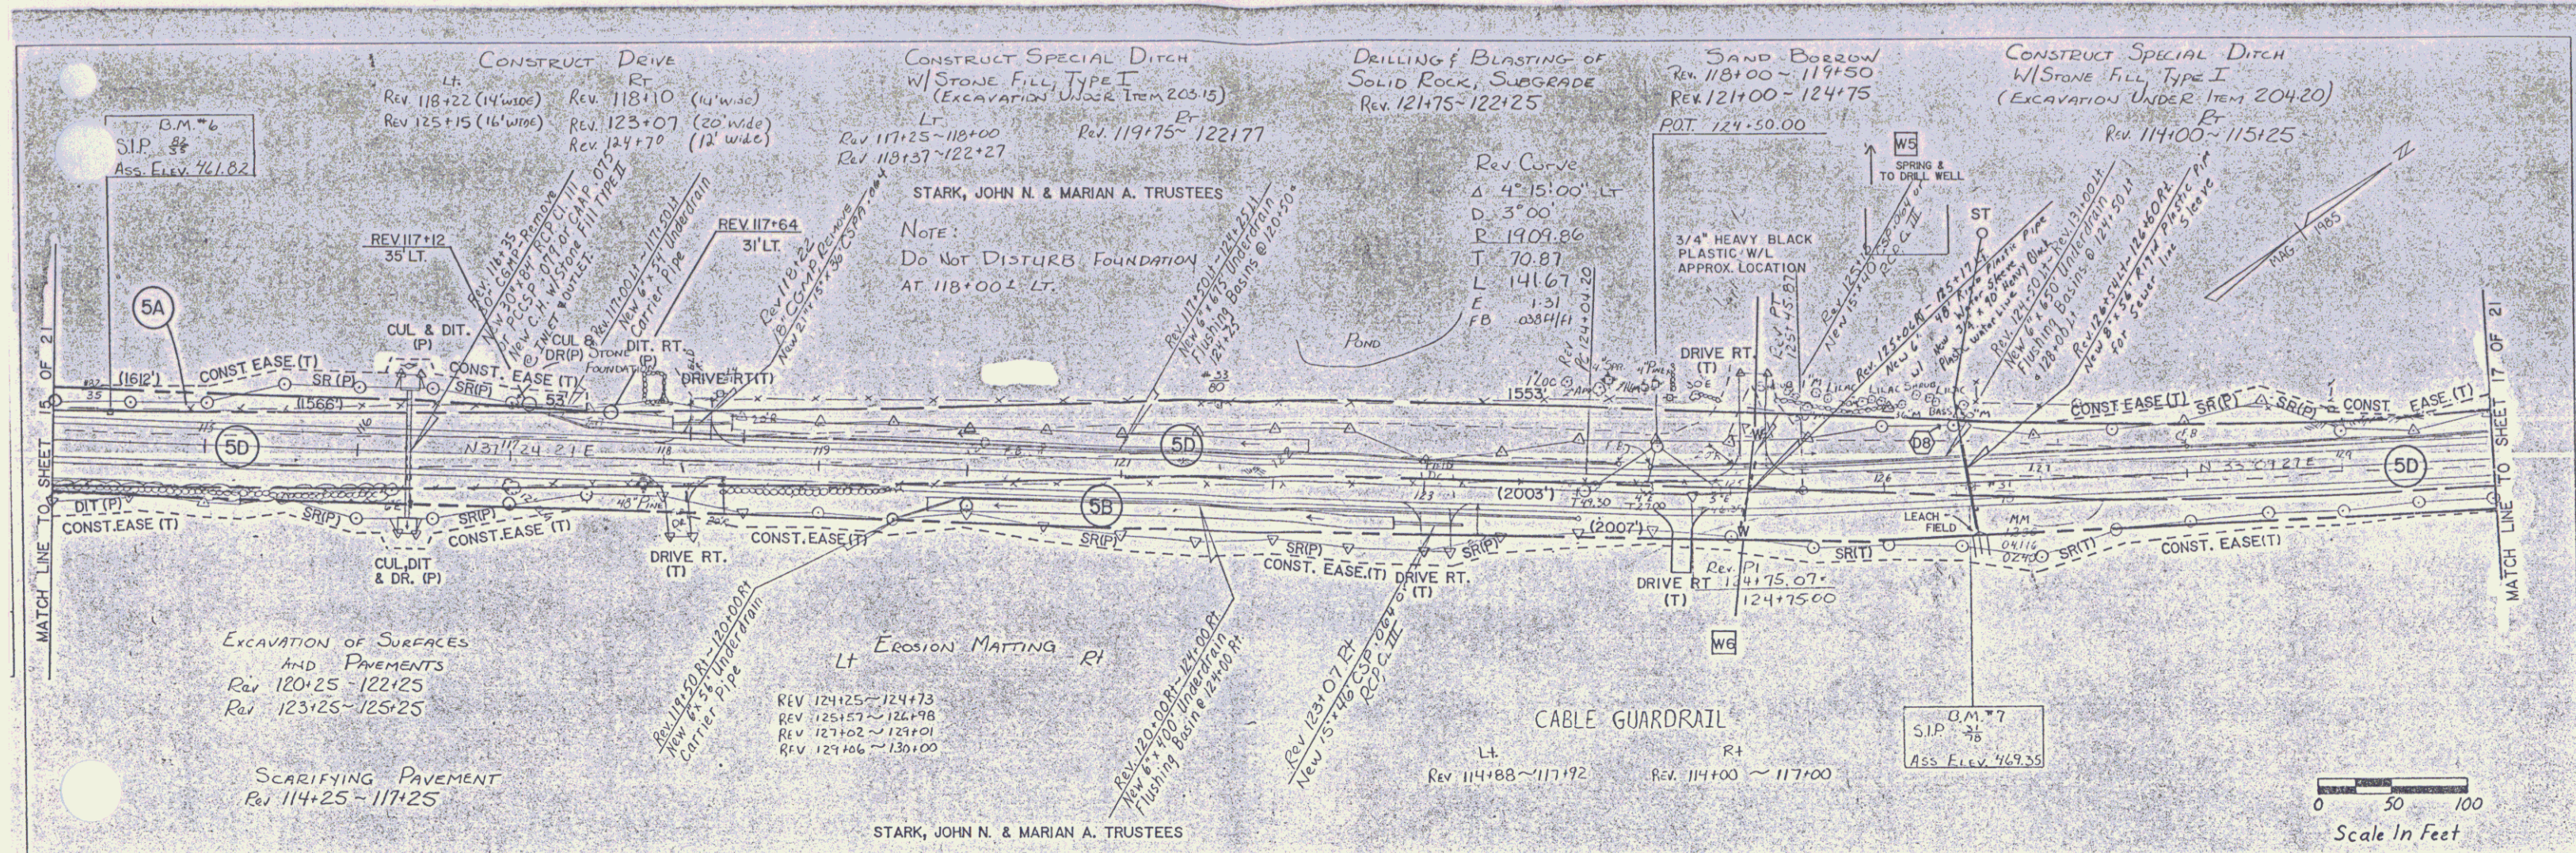

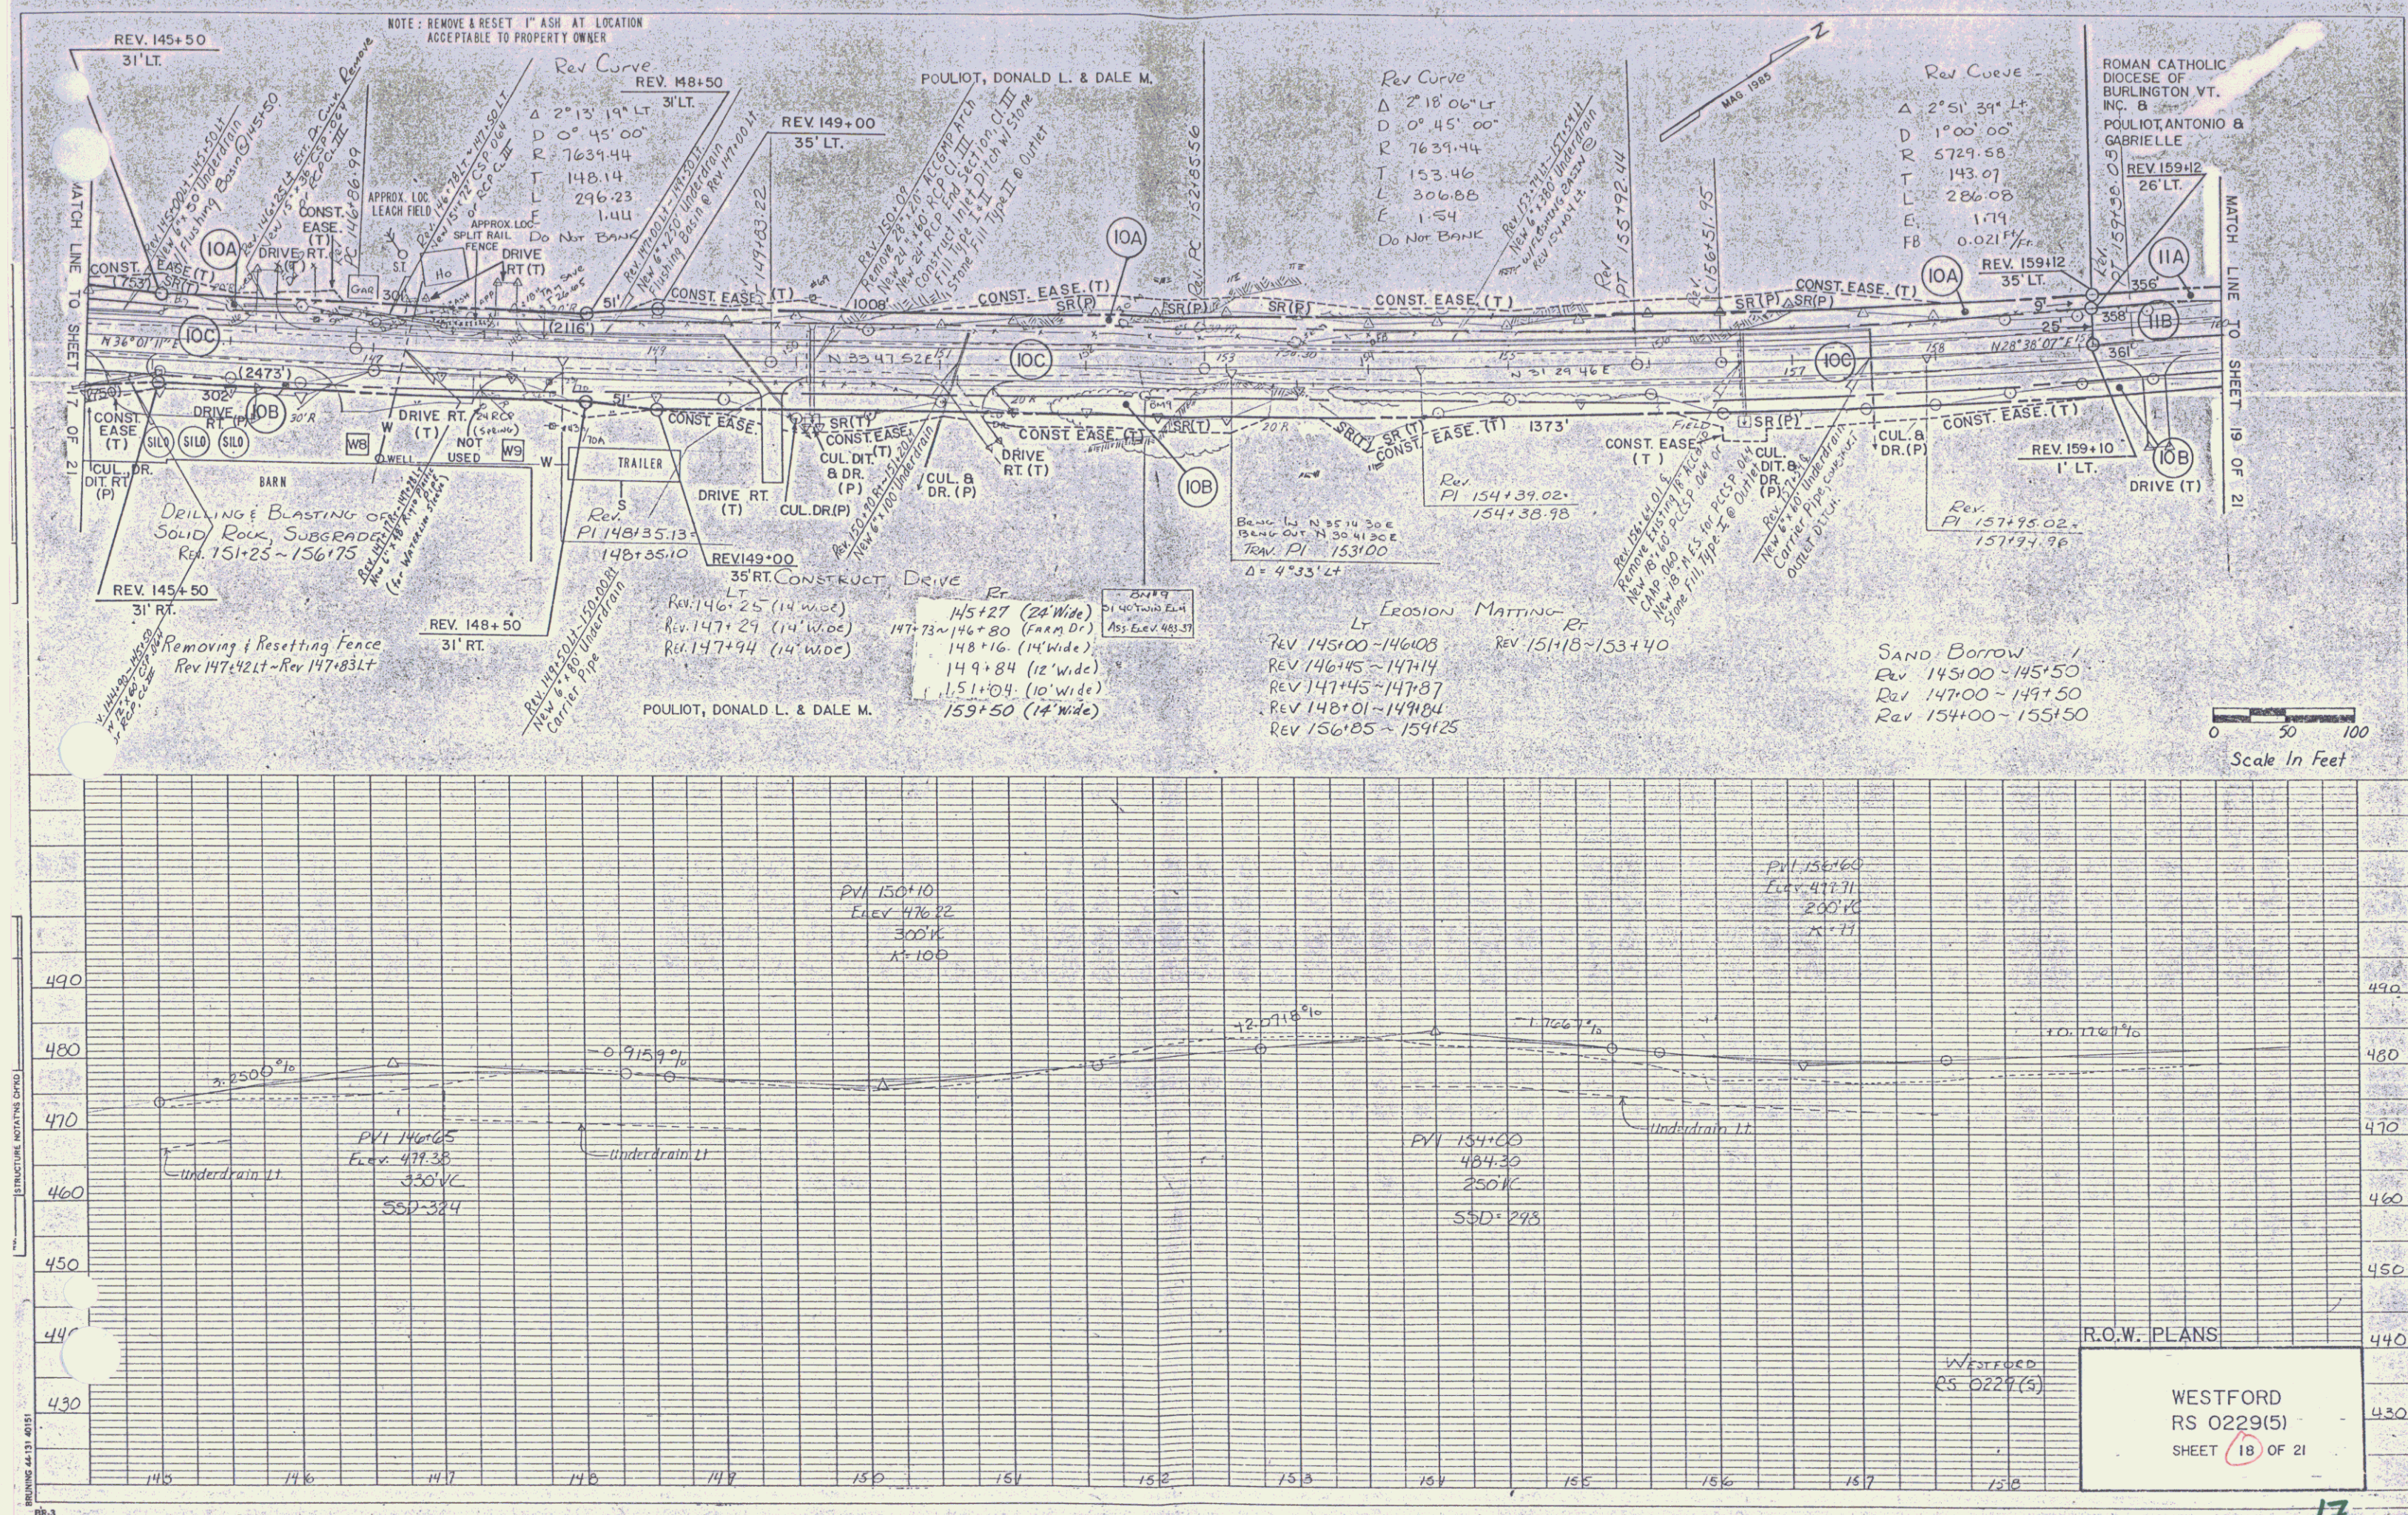

POOR ORIGINAL COPY

