


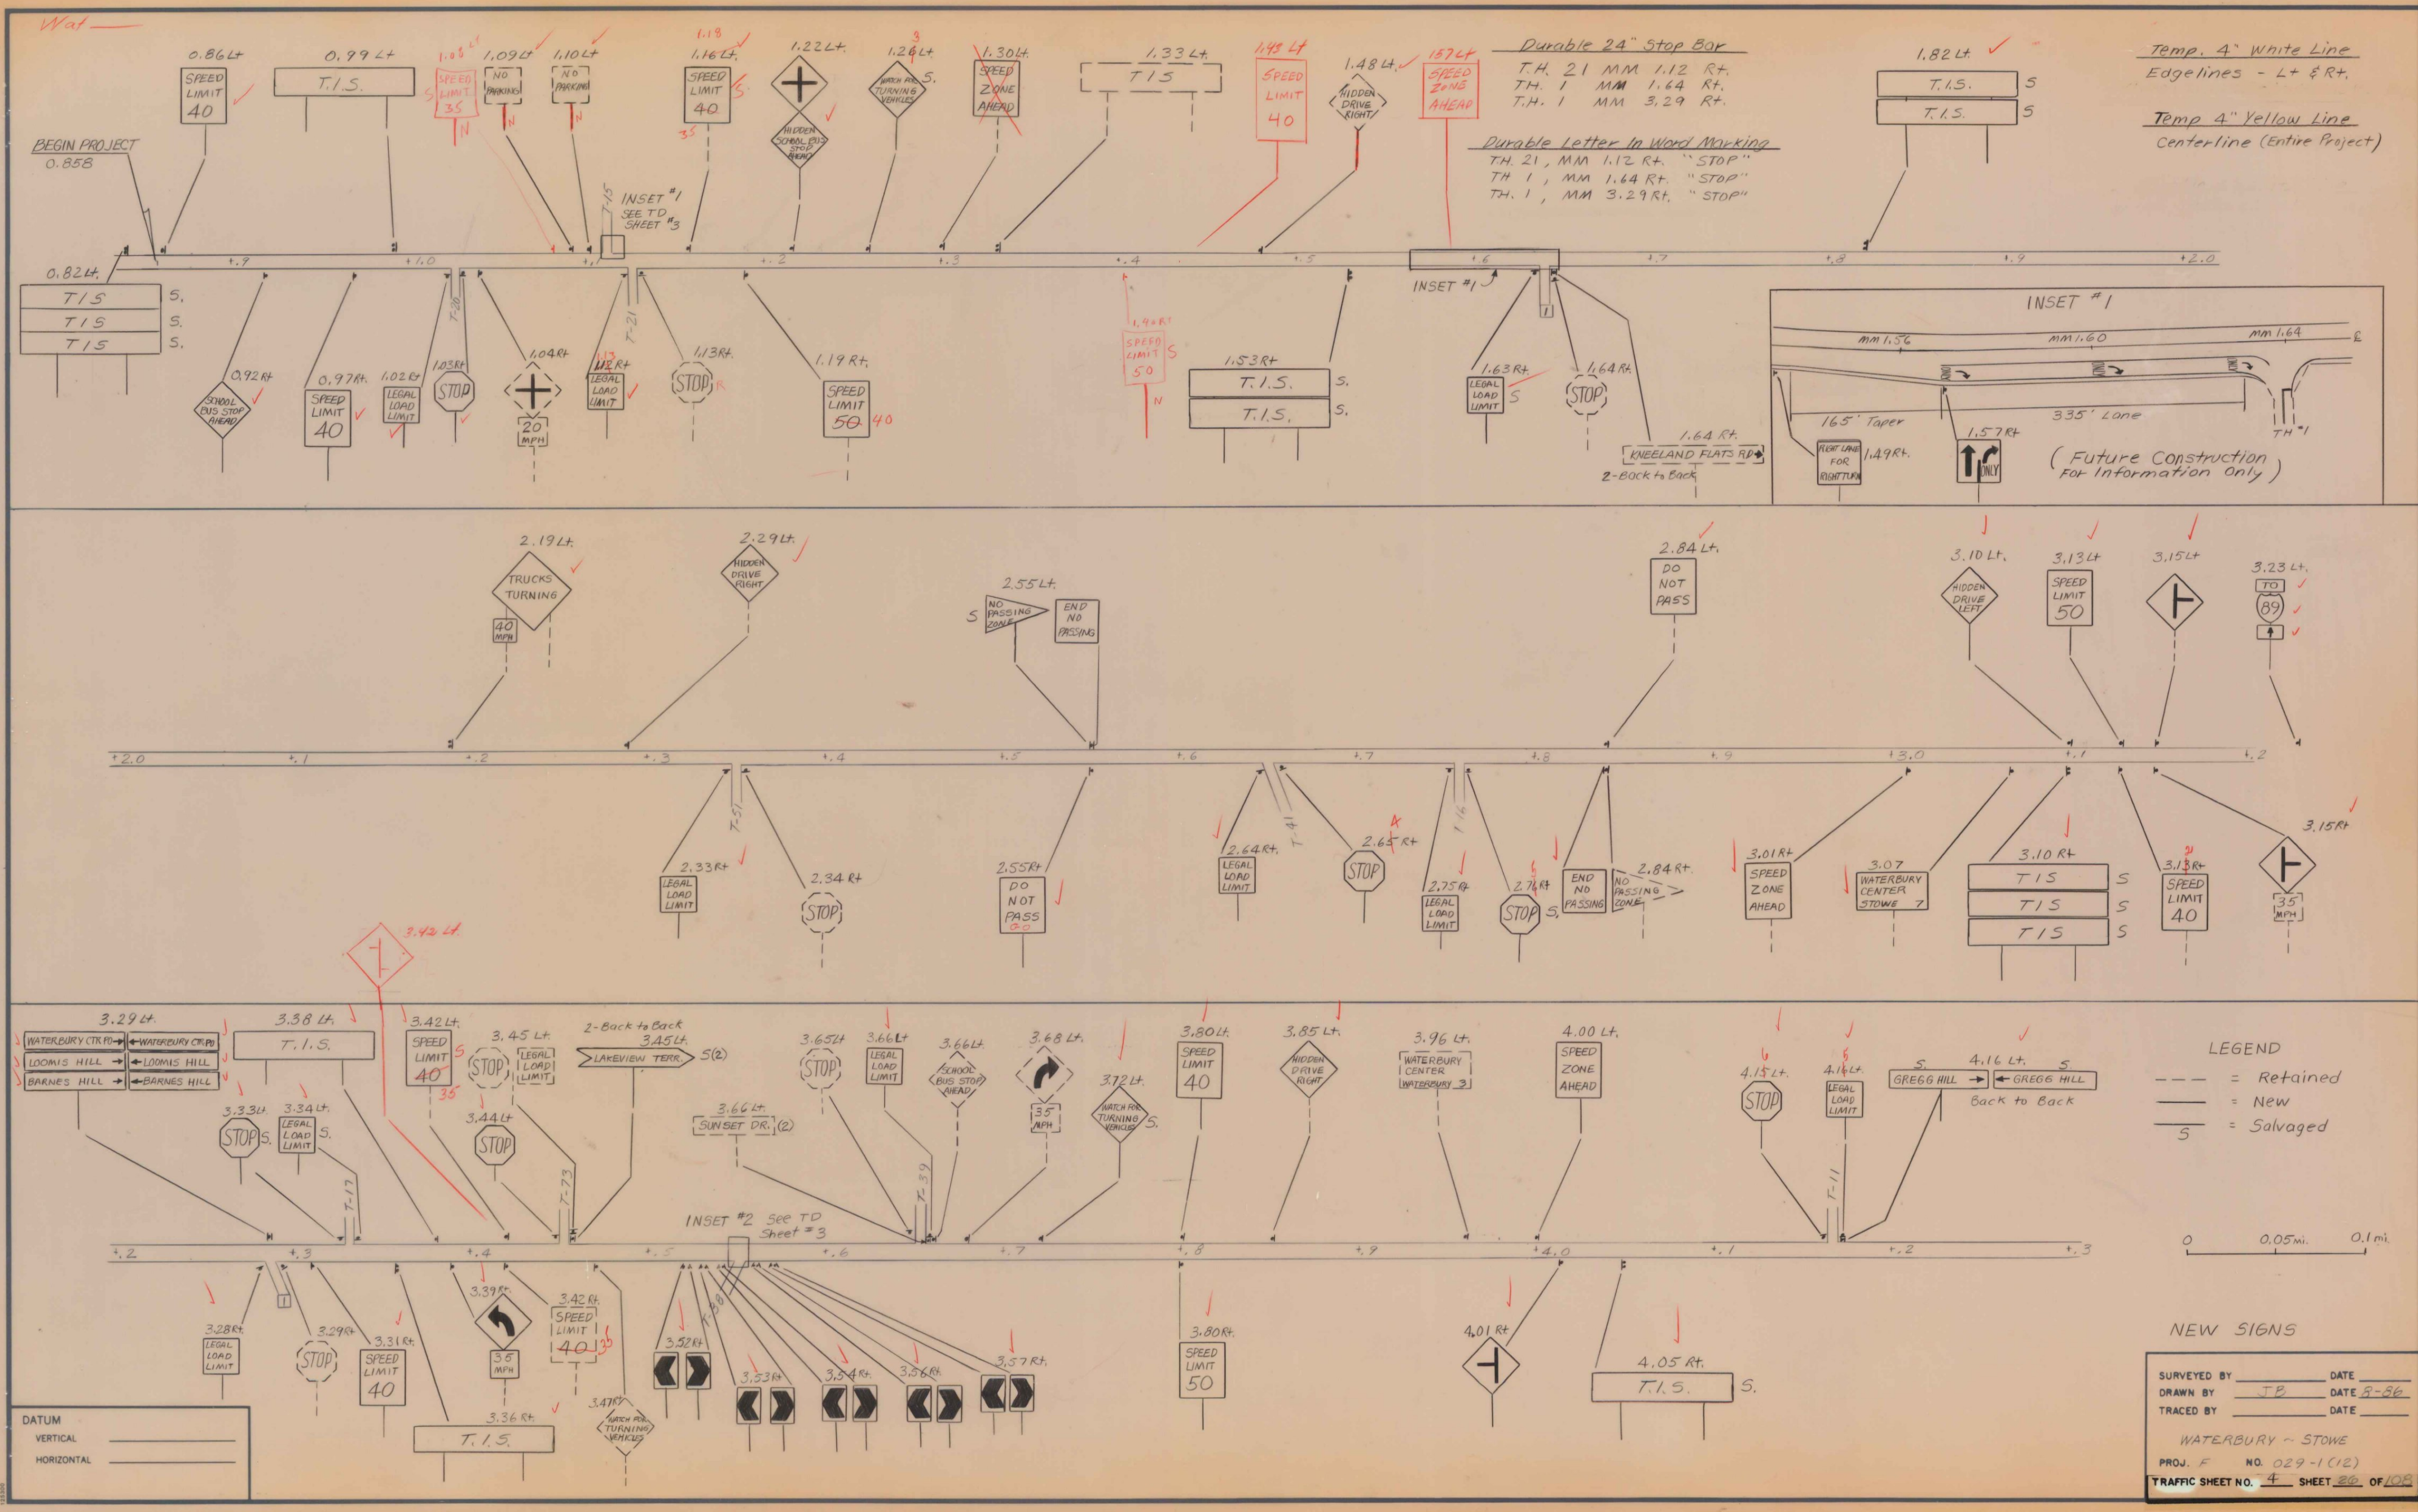

Temp. 4" White Line
Edgelines - L+ & Rt.
Temp 4" Yellow Line
Centerline (Entire Project)

Durable 24" Stop Bar
T.H. 21 MM 1.12 Rt.
T.H. 1 MM 1.64 Rt.
T.H. 1 MM 3.29 Rt.

Durable Letter In Word Marking
T.H. 21, MM 1.12 Rt. "STOP"
T.H. 1, MM 1.64 Rt. "STOP"
T.H. 1, MM 3.29 Rt. "STOP"

LEGEND
--- = Retained
— = New
S = Salvaged

0 0.05mi. 0.1mi.

NEW SIGNS

SURVEYED BY _____ DATE _____
DRAWN BY J.P. DATE 8-86
TRACED BY _____ DATE _____

WATERBURY ~ STOWE
PROJ. F NO. 029-1(12)
TRAFFIC SHEET NO. 4 SHEET 20 OF 108

DATUM
VERTICAL _____
HORIZONTAL _____