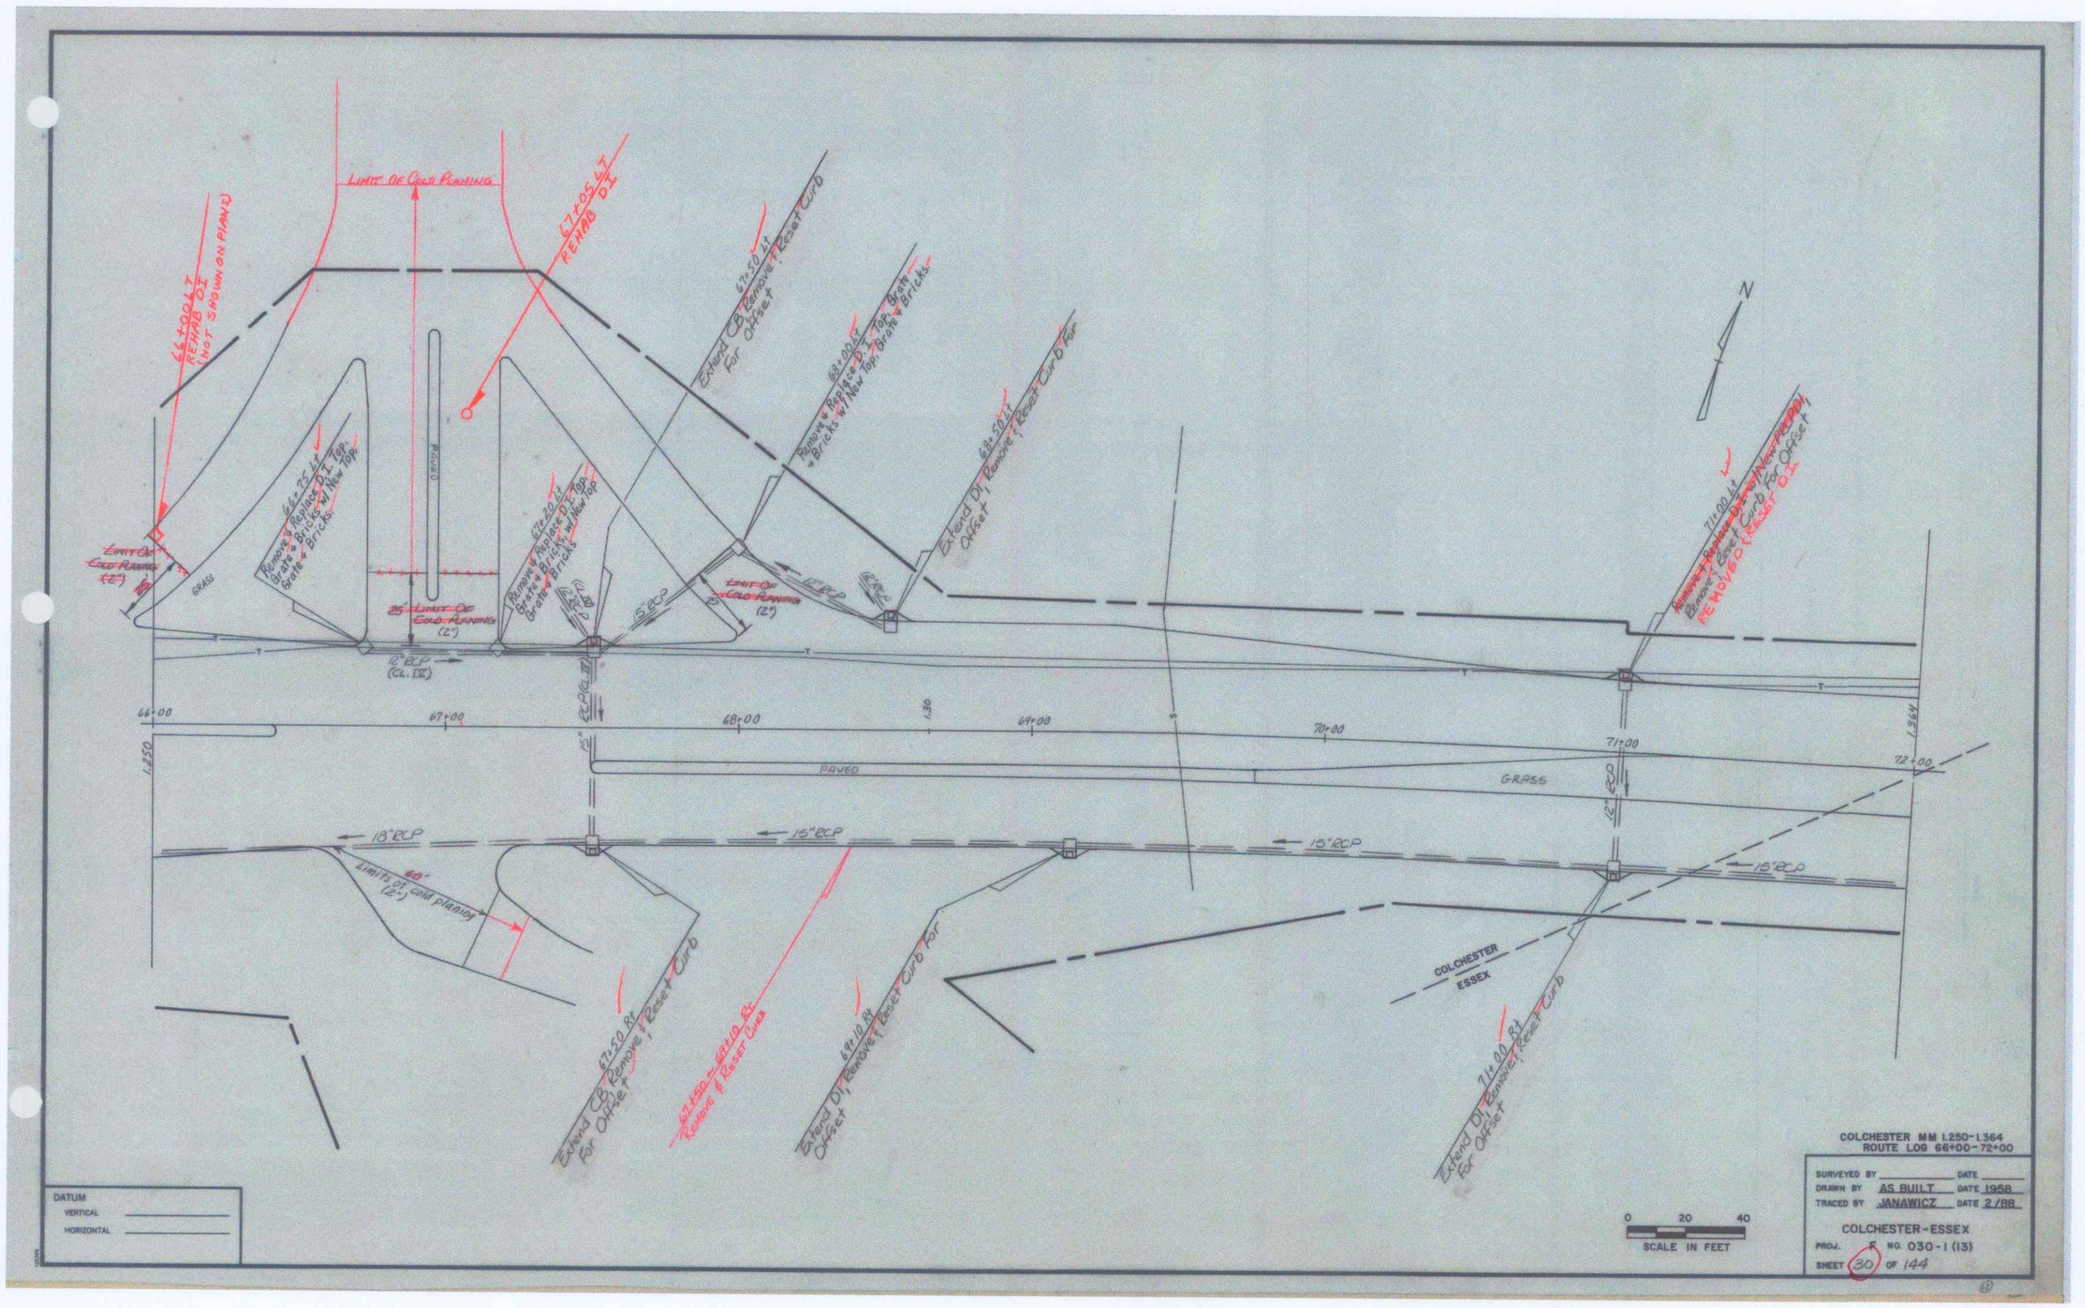
LIMIT OF COLD PLANING
66+00 LT REHAB DI (NOT SHOWN ON PLANS)
67+05 LT REHAB DI
Extend CB 67+50 Rt, Remove & Reset Curb for Offset
Remove & Replace Brick w/ New Top, Grate & Bricks
68+00 Rt
Extend DI 68+50 Rt, Remove & Reset Curb for Offset
Remove & Replace DI Top, Grate & Bricks w/ New Top
66+75 Lt
Remove & Replace DI Top, Grate & Bricks w/ New Top
67+20 Lt
Remove & Replace DI Top, Grate & Bricks w/ New Top
Limit Of Cold Planing (2")
25' Limit Of Cold Planing (2")
GRASS
PAVED
12" RCP (CL. IV)
15" RCP
18" RCP
24" RCP
Limits of cold planing 60' (2")
Extend CB 67+50 Rt, Remove & Reset Curb for Offset
67+50 - 68+10 Rt Remove & Reset Curb
Extend DI 68+10 Rt, Remove & Reset Curb for Offset
Extend DI 71+00 Rt, Remove & Reset Curb for Offset
Remove & Replace DI Top, Grate & Bricks w/ New Top
Remove & Reset Curb
REMOVED (RESET DI)
66+00
67+00
68+00
69+00
70+00
71+00
72+00
L250
L364
N
COLCHESTER
ESSEX
DATUM
VERTICAL
HORIZONTAL
0 20 40
SCALE IN FEET
COLCHESTER MM L250-L364
ROUTE LOG 66+00-72+00
SURVEYED BY _____ DATE _____
DRAWN BY AS BUILT DATE 1958
TRACED BY JANAWICZ DATE 2/88
COLCHESTER-ESSEX
PROJ. NO. 030-1 (13)
SHEET 30 OF 144