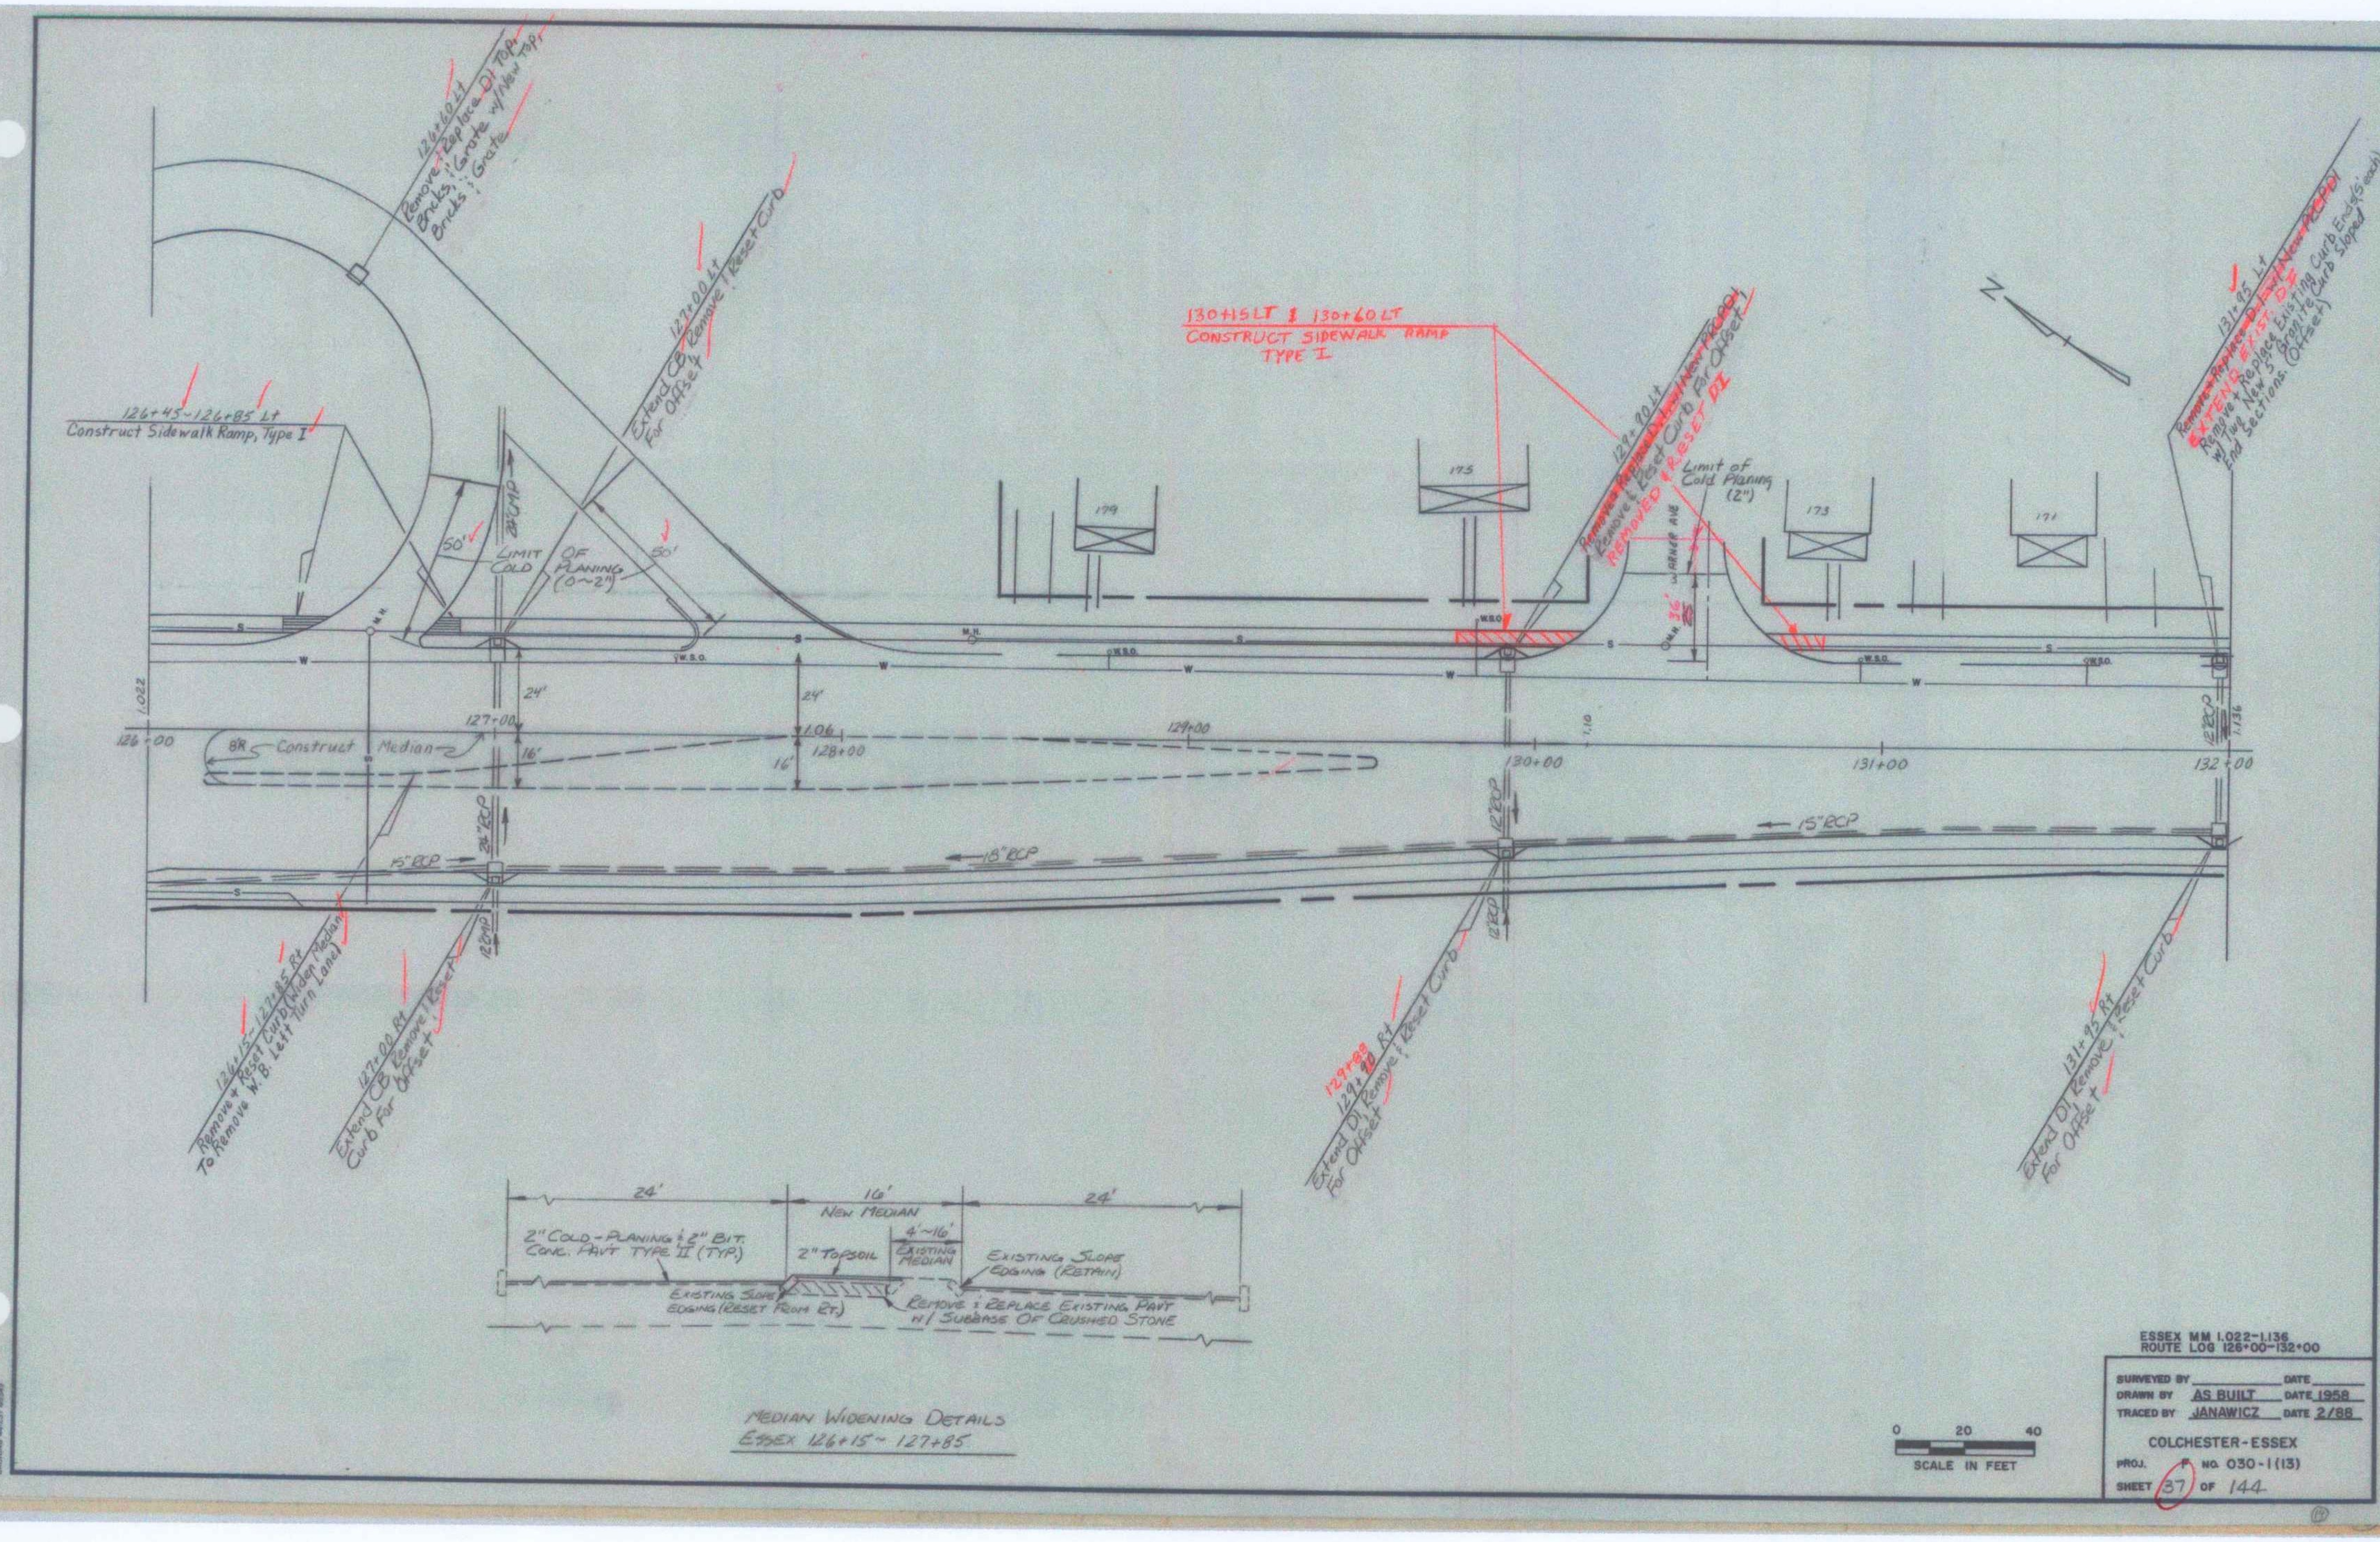
126+45 - 126+85 Lt
Construct Sidewalk Ramp, Type I
130+15 LT & 130+60 LT
CONSTRUCT SIDEWALK RAMP
TYPE I
Limit of Cold Planing (2")
Construct Median
126+00
127+00
128+00
129+00
130+00
131+00
132+00
15" RCP
24'
16'
New Median
4'~16'
Existing Median
2" Cold-Planing & 2" Bit. Conc. Pav't Type II (Typ.)
2" Topsoil
Existing Slope Edging (Retain)
Existing Slope Edging (Reset From Rt.)
Remove & Replace Existing Pav't w/ Subbase Of Crushed Stone
Median Widening Details
Essex 126+15 ~ 127+85
0 20 40
SCALE IN FEET
ESSEX MM 1.022-1.136
ROUTE LOG 126+00-132+00
SURVEYED BY
DATE
DRAWN BY AS BUILT DATE 1958
TRACED BY JANAWICZ DATE 2/88
COLCHESTER-ESSEX
PROJ. F NO. 030-1(13)
SHEET 37 OF 144