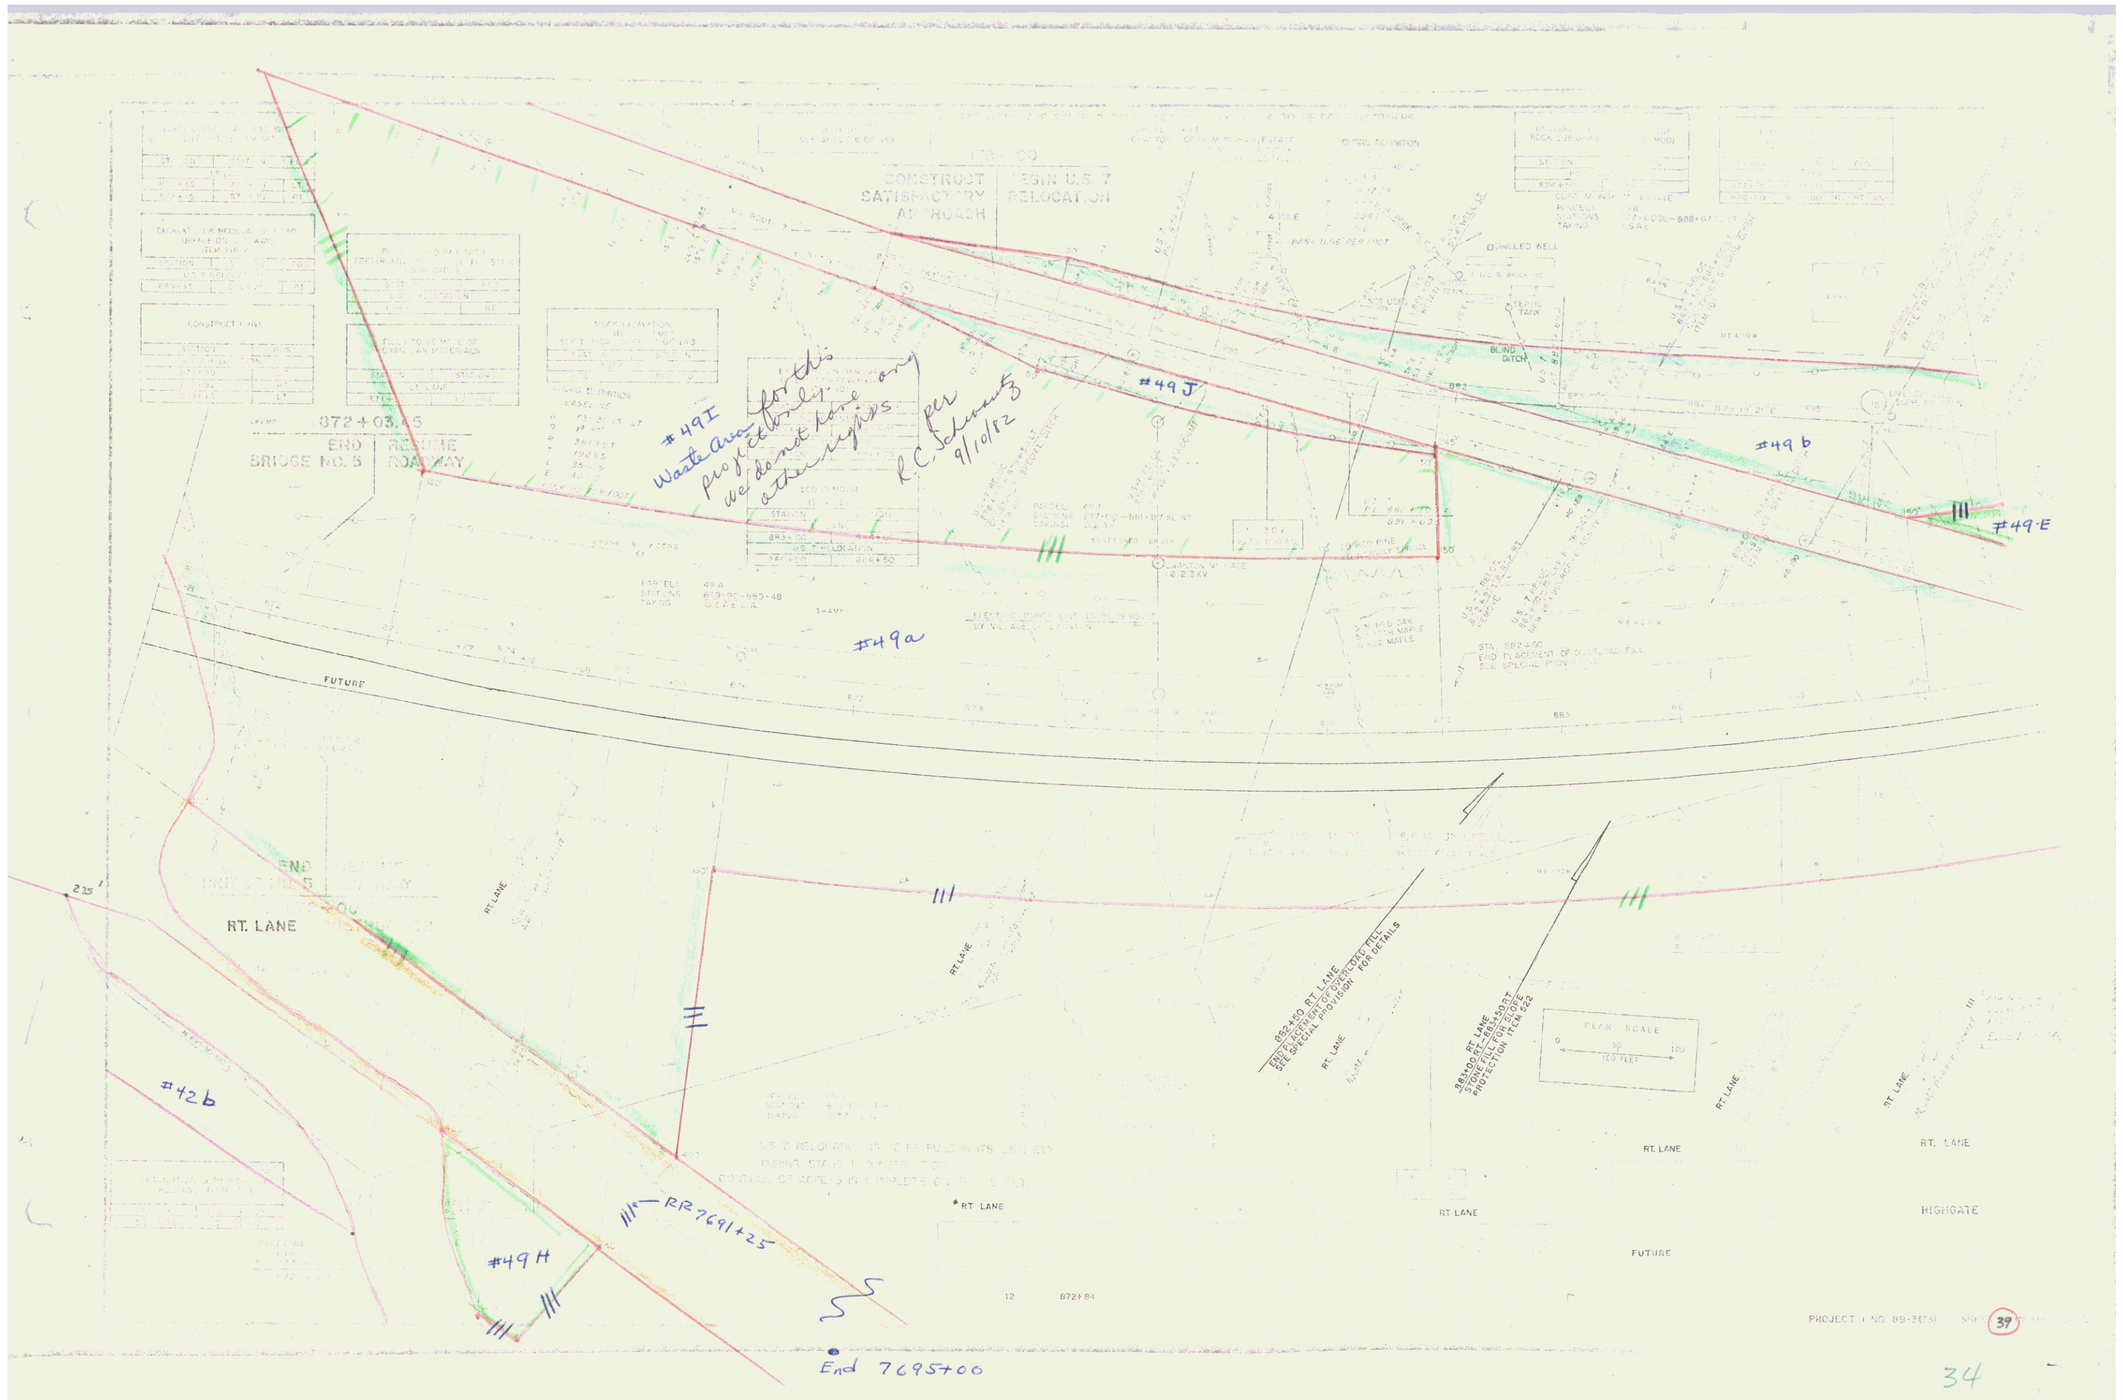
CONSTRUCT SATISFACTORY APPROACH
BEGIN U.S. 7 RELOCATION
STA. 372+03.45
END BRIDGE NO. 5
RESUME ROADWAY
#49I
Waste Area for this project. We do not have any other rights
R.C. Schmutz per 9/10/82
#49J
#49b
#49E
#49a
FUTURE
RT. LANE
#42b
#49H
RR 769+25
End 769+00
BLIND DITCH
DRILLED WELL
STA. 882+50
END PLACEMENT OF OVERBURDEN FILL
SEE SPECIAL PROVISION FOR DETAILS
383+30 RT. LANE
TOE OF FILL OR SLOPE PROTECTION ITEM 622
PLAN SCALE
0 50 100
100 FEET
HIGHGATE
PROJECT I NO. 89-3(13)
39
34