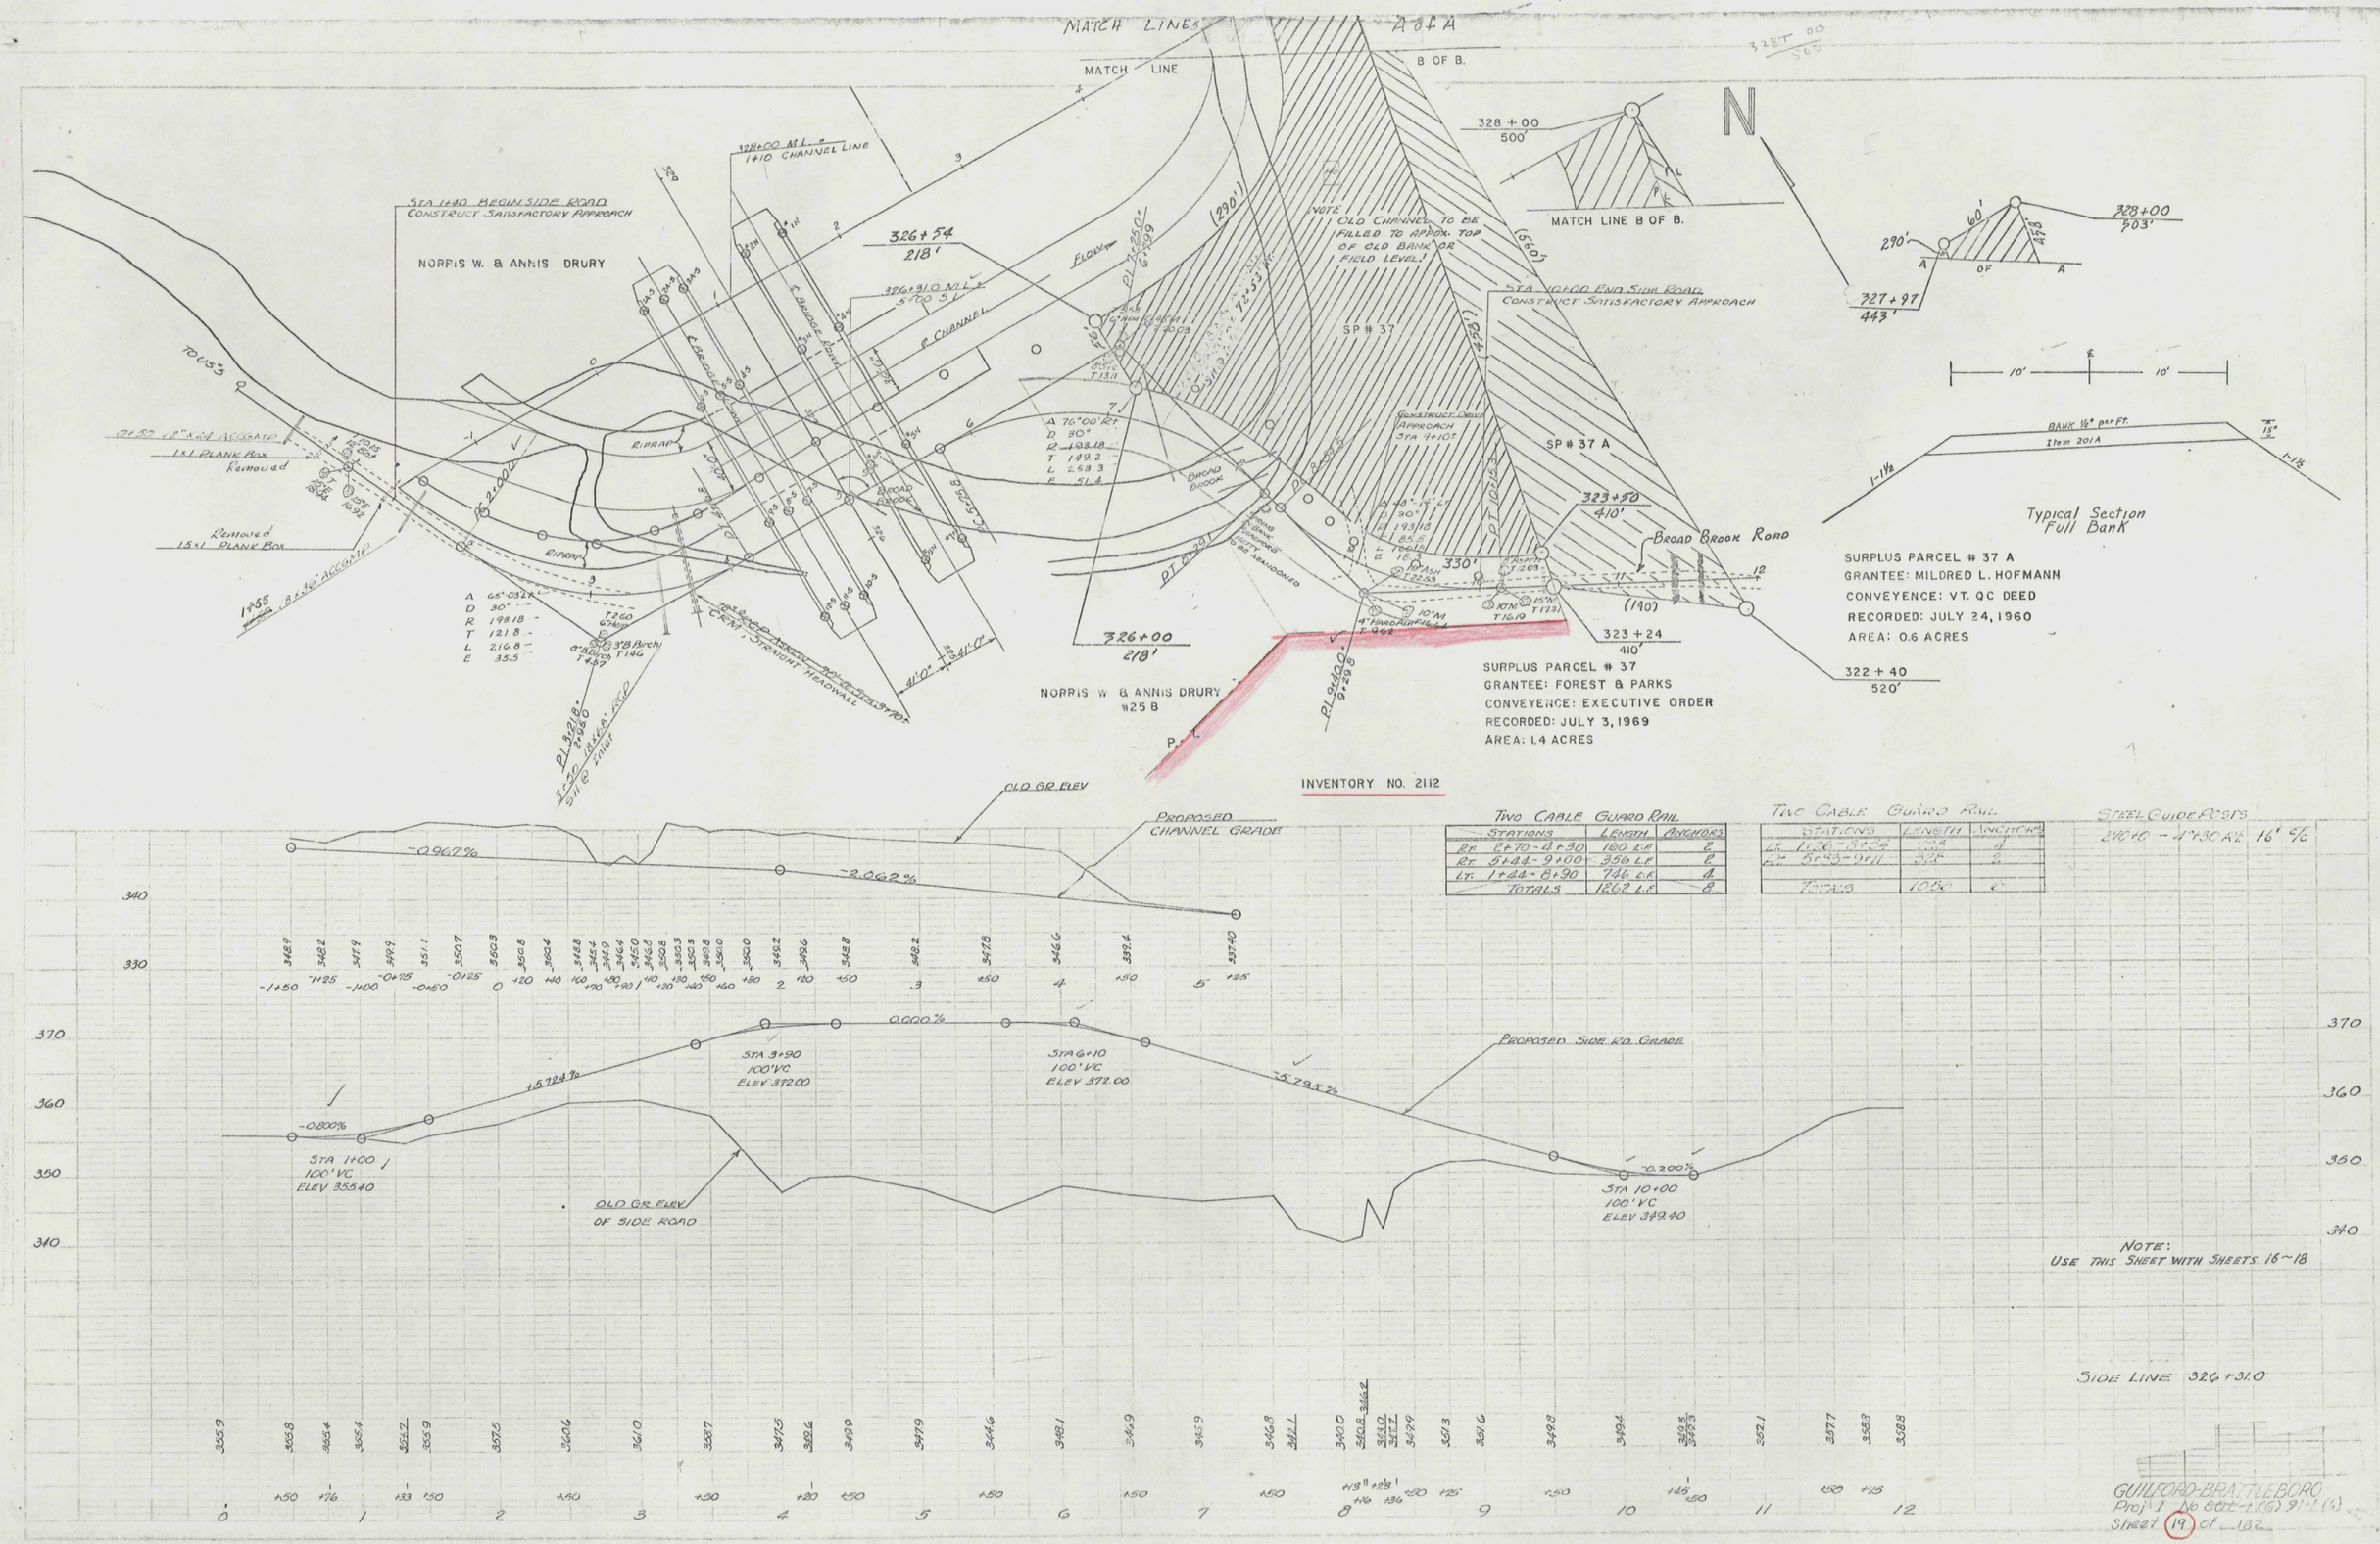

Two Cable Guard Rail

Stations	Length	Anchors
Rt. 2+70 - 4+30	160 L.F.	2
Rt. 5+44 - 9+00	356 L.F.	2
Lt. 1+44 - 8+90	746 L.F.	4
Totals	1262 L.F.	8

Two Cable Guard Rail

Stations	Length	Anchors
Lt. 1+26 - 5+24	398	4
Rt. 5+33 - 9+11	378	4
Totals	1056	8

Steel Guide Posts

216+10 - 4+30 Rt. 16' c/c