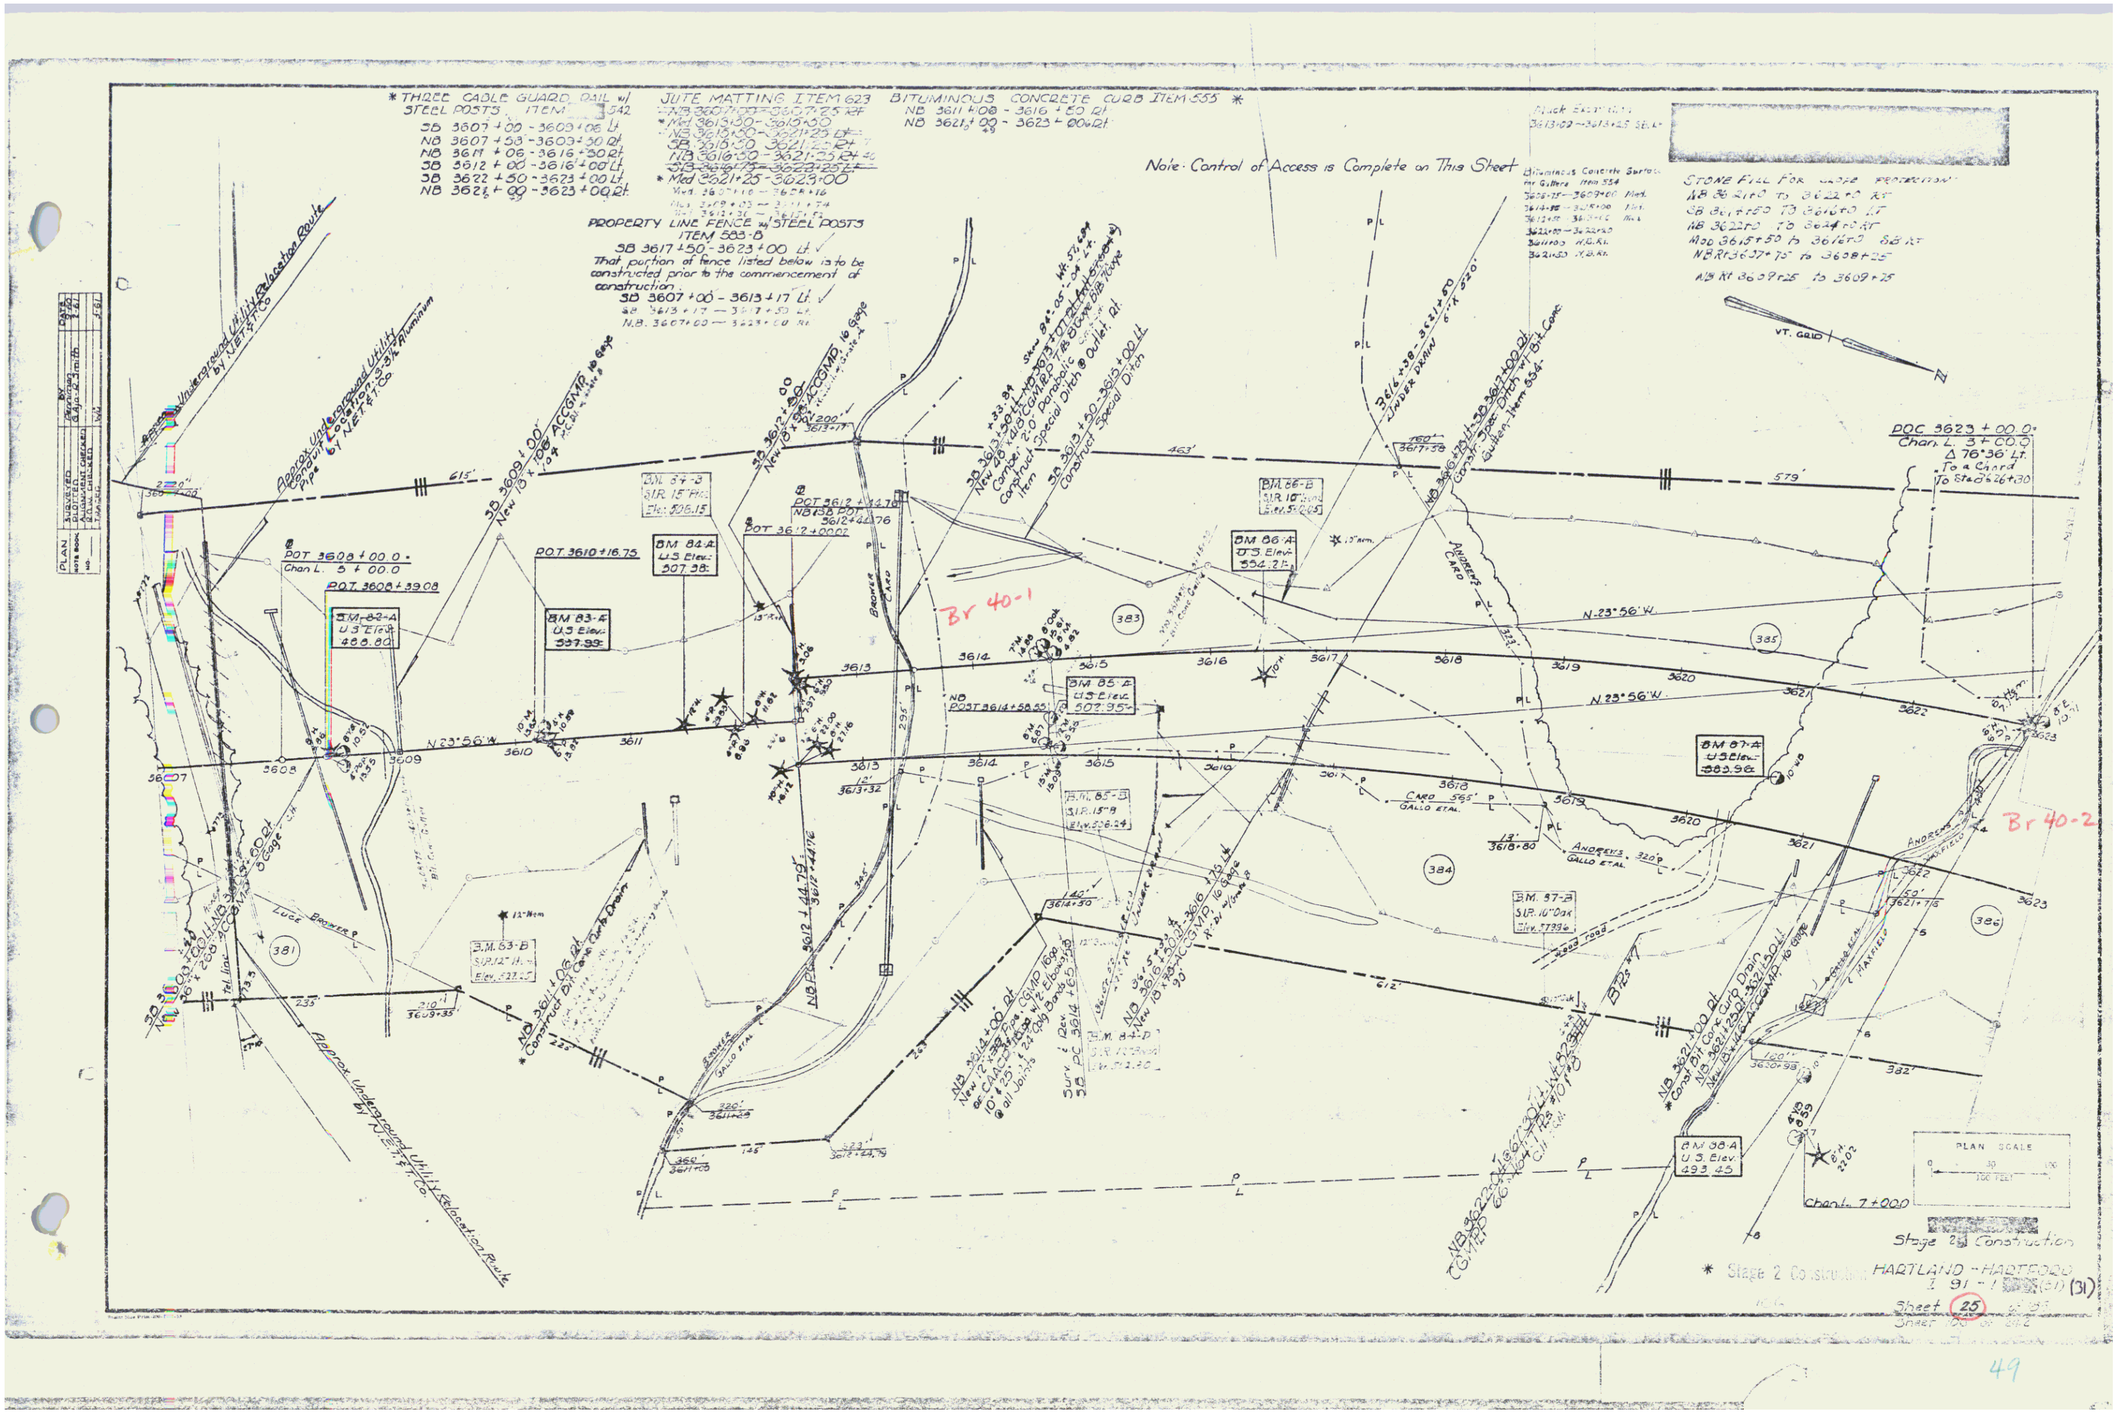
* THREE CABLE GUARD RAIL w/ STEEL POSTS ITEM 542
SB 3607+00 - 3609+06 Lt.
NB 3607+58 - 3609+50 Rt.
NB 3611+06 - 3616+50 Rt.
SB 3612+00 - 3616+00 Lt.
SB 3622+50 - 3623+00 Lt.
NB 3621+00 - 3623+00 Rt.
JUTE MATTING ITEM 623
BITUMINOUS CONCRETE CURB ITEM 555 *
NB 3611+08 - 3616+50 Rt.
NB 3621+00 - 3623+00 Rt.
Note: Control of Access is Complete on This Sheet
PROPERTY LINE FENCE w/ STEEL POSTS ITEM 583-B
SB 3617+50 - 3623+00 Lt.
That portion of fence listed below is to be constructed prior to the commencement of construction.
SB 3607+00 - 3613+17 Lt.
STONE FILL FOR WATER PROTECTION
VT. GRID
POC 3623+00.0
Chan. L 3+00.0
Δ 76°36' Lt.
To a Chord
To Sta. 3626+30
POT 3608+00.0
Chan. L 5+00.0
POT 3608+39.08
POT 3610+16.75
POT 3612+00.00
BM 82-A U.S. Elev. 488.80
BM 83-A U.S. Elev. 537.99
BM 84-A U.S. Elev. 507.38
BM 85-A U.S. Elev. 507.95
BM 86-A U.S. Elev. 554.21
BM 87-A U.S. Elev. 583.96
BM 63-B
BM 97-B
BM 38-A U.S. Elev. 493.45
N 23°56' W
Br 40-1
Br 40-2
Approx. Underground Utility Relocation Route By N.E.T.P.C.O.
Chan. 7+00.0
PLAN SCALE
Stage 2 Construction
* Stage 2 Construction
HARTLAND - HARTFORD
I 91 - 1
Sheet 25
49