


ACQUIRED FROM RICHARD J. & MARGARET H. GRAHAM
BY W.D. 1.4 A± RECORDED: TOWN OF BARNET,
8-27-71, BK 55, PG. 349

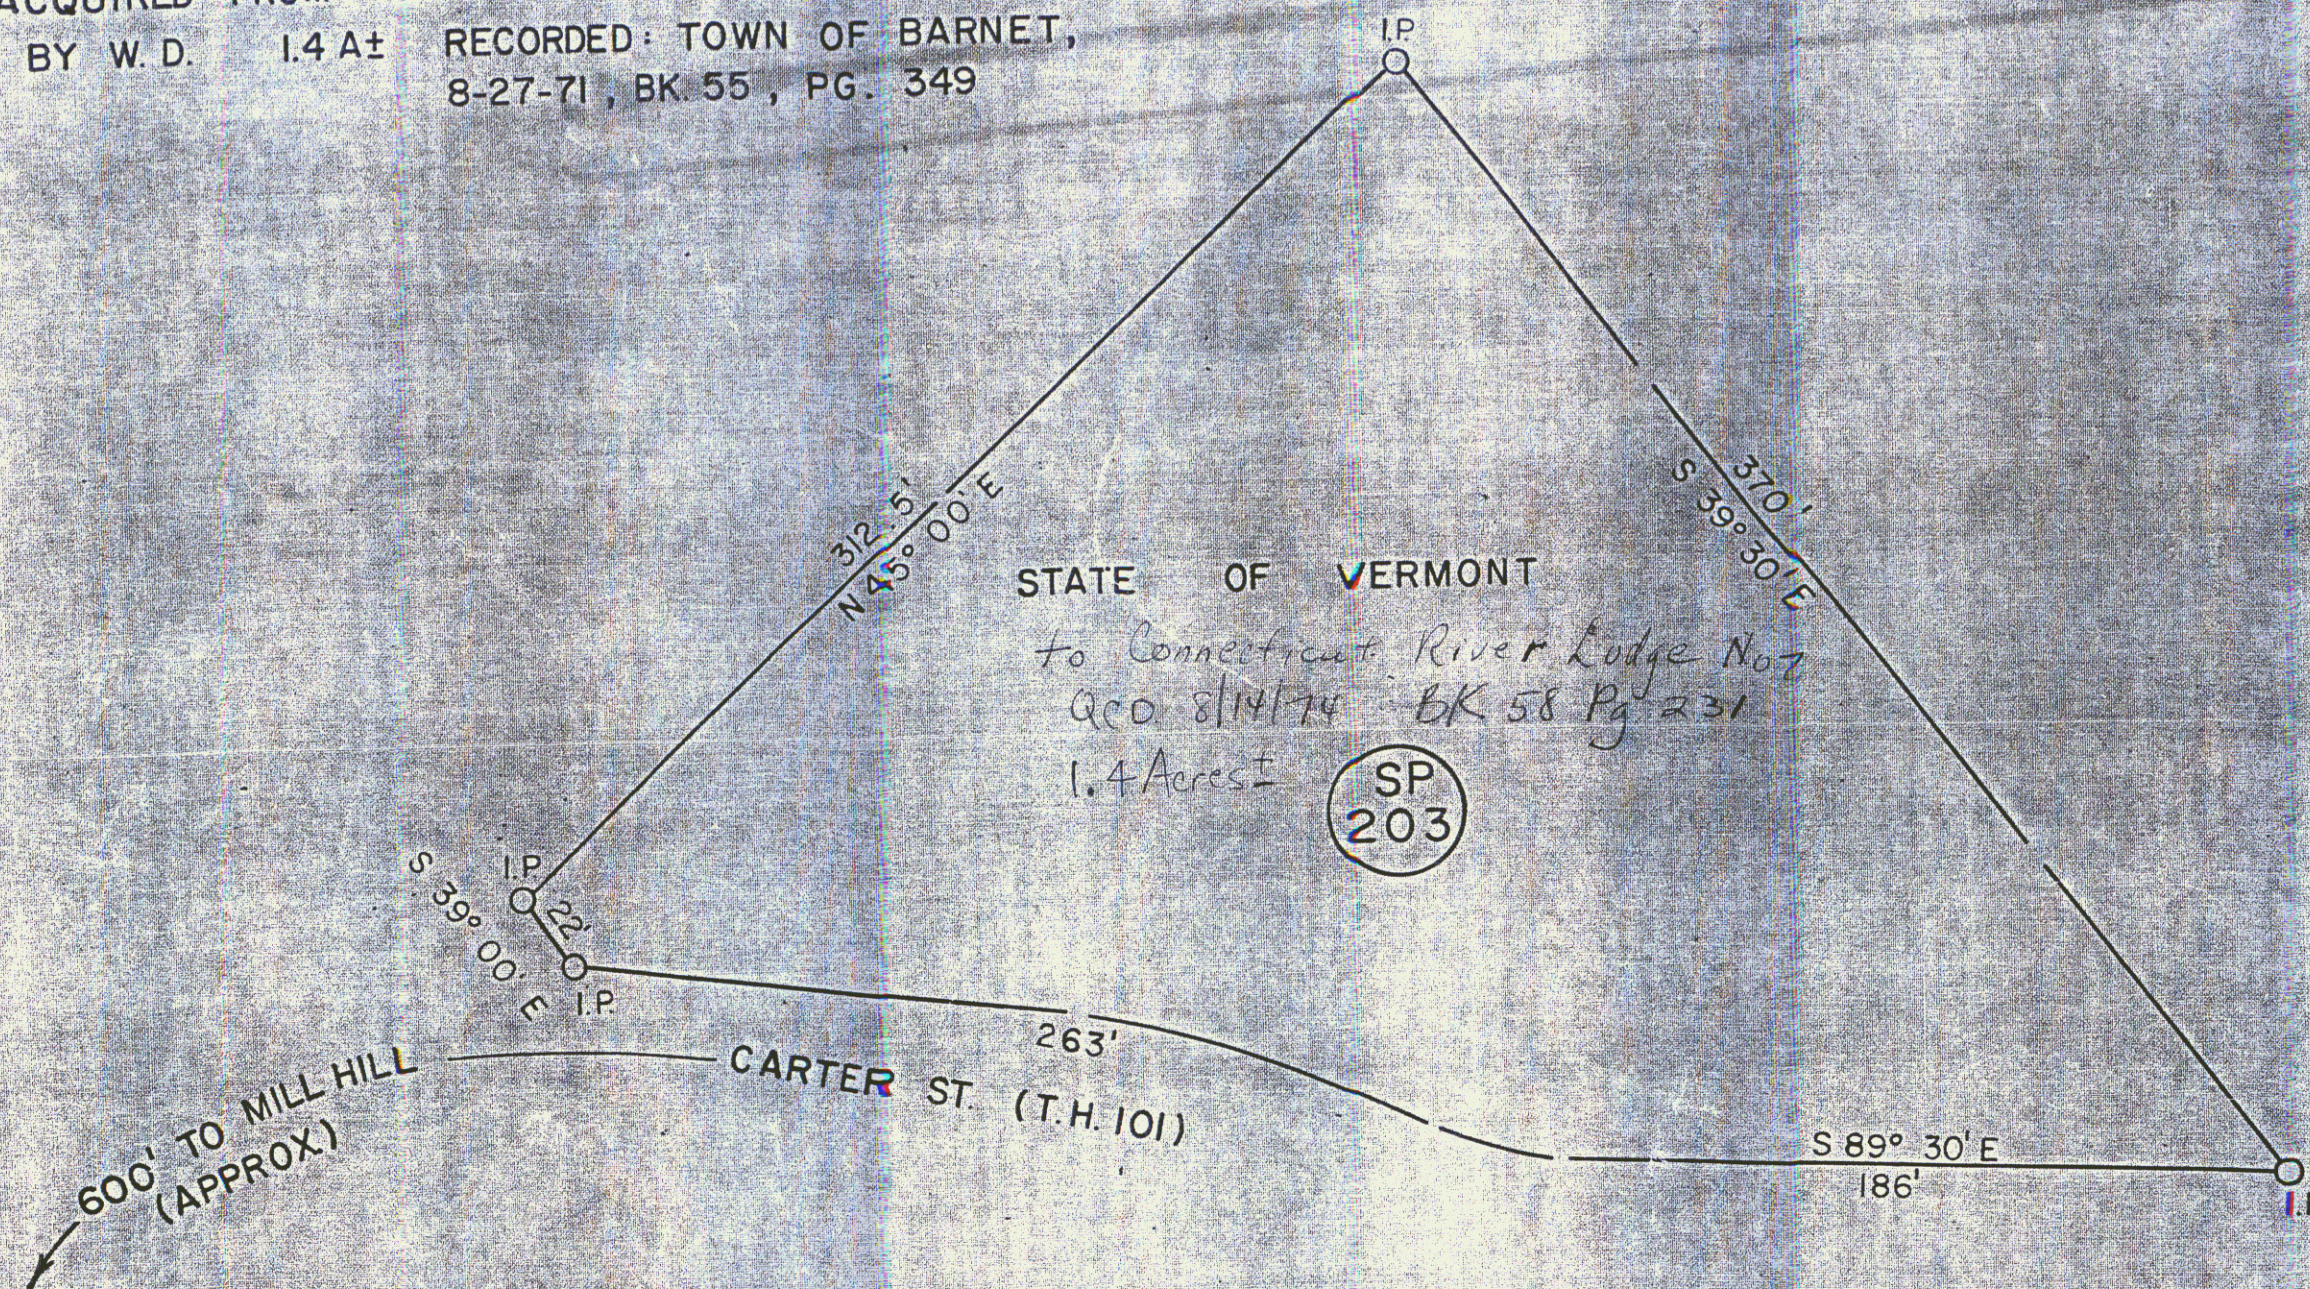

STATE OF VERMONT

to Connecticut River Lodge No. 7
QCD 8/14/74 BK 58 Pg 231
1.4 Acres ±

SP
203

600' TO MILL HILL
(APPROX.)

CARTER ST. (T.H. 101)

SCALE 1" = 50'



Off Project - on E'ly side of US 5

STATE OF VERMONT
DEPT. OF HIGHWAYS

TOWN OF BARNET *(86D)*

SECT. I
PROJECT BARNET-ST. JOHNSBURY 191-2(21)
APPROX. SCALE 1" = 50' DATE 8-6-74 DRAWN BY KMD