


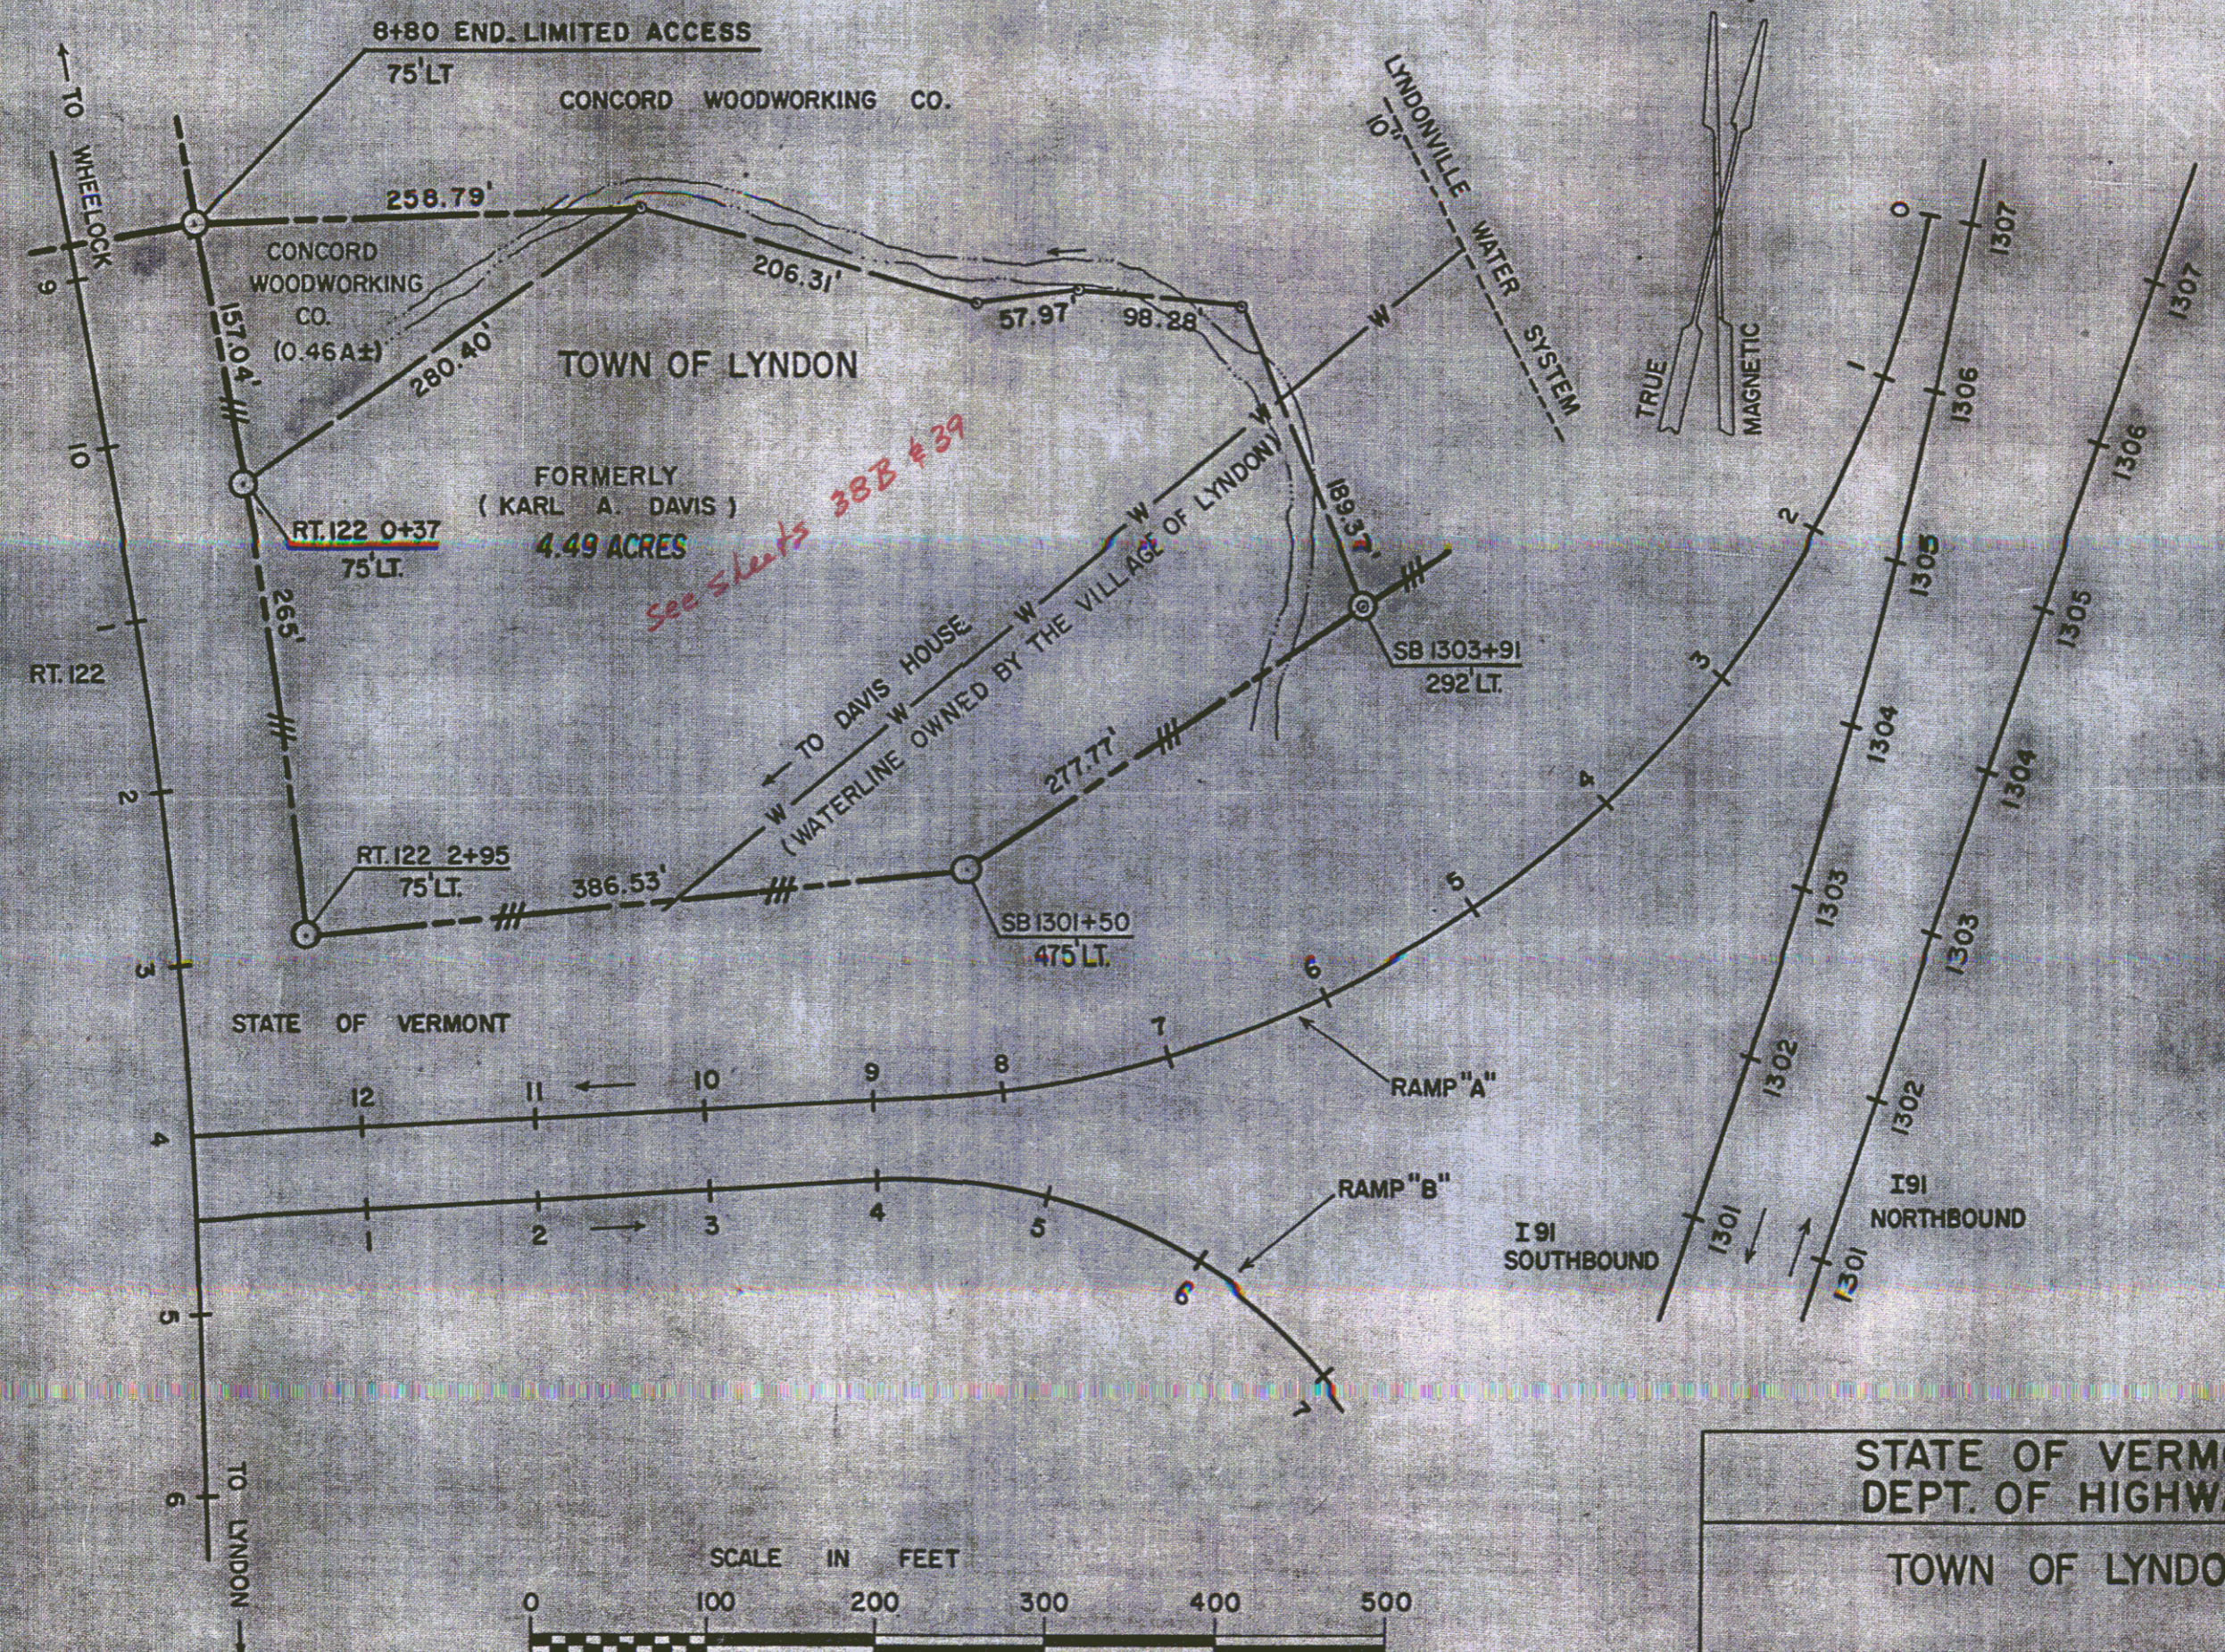

STATE OF VERMONT DEPT. OF HIGHWAYS		
TOWN OF LYNDON		
PROJECT LYNDON-BARTON I-91-3(14) SECT. 1A		
APPROX. SCALE 1"=100'	DATE 8-21-74	DRAWN BY RLS
REVISED 12-6-74		