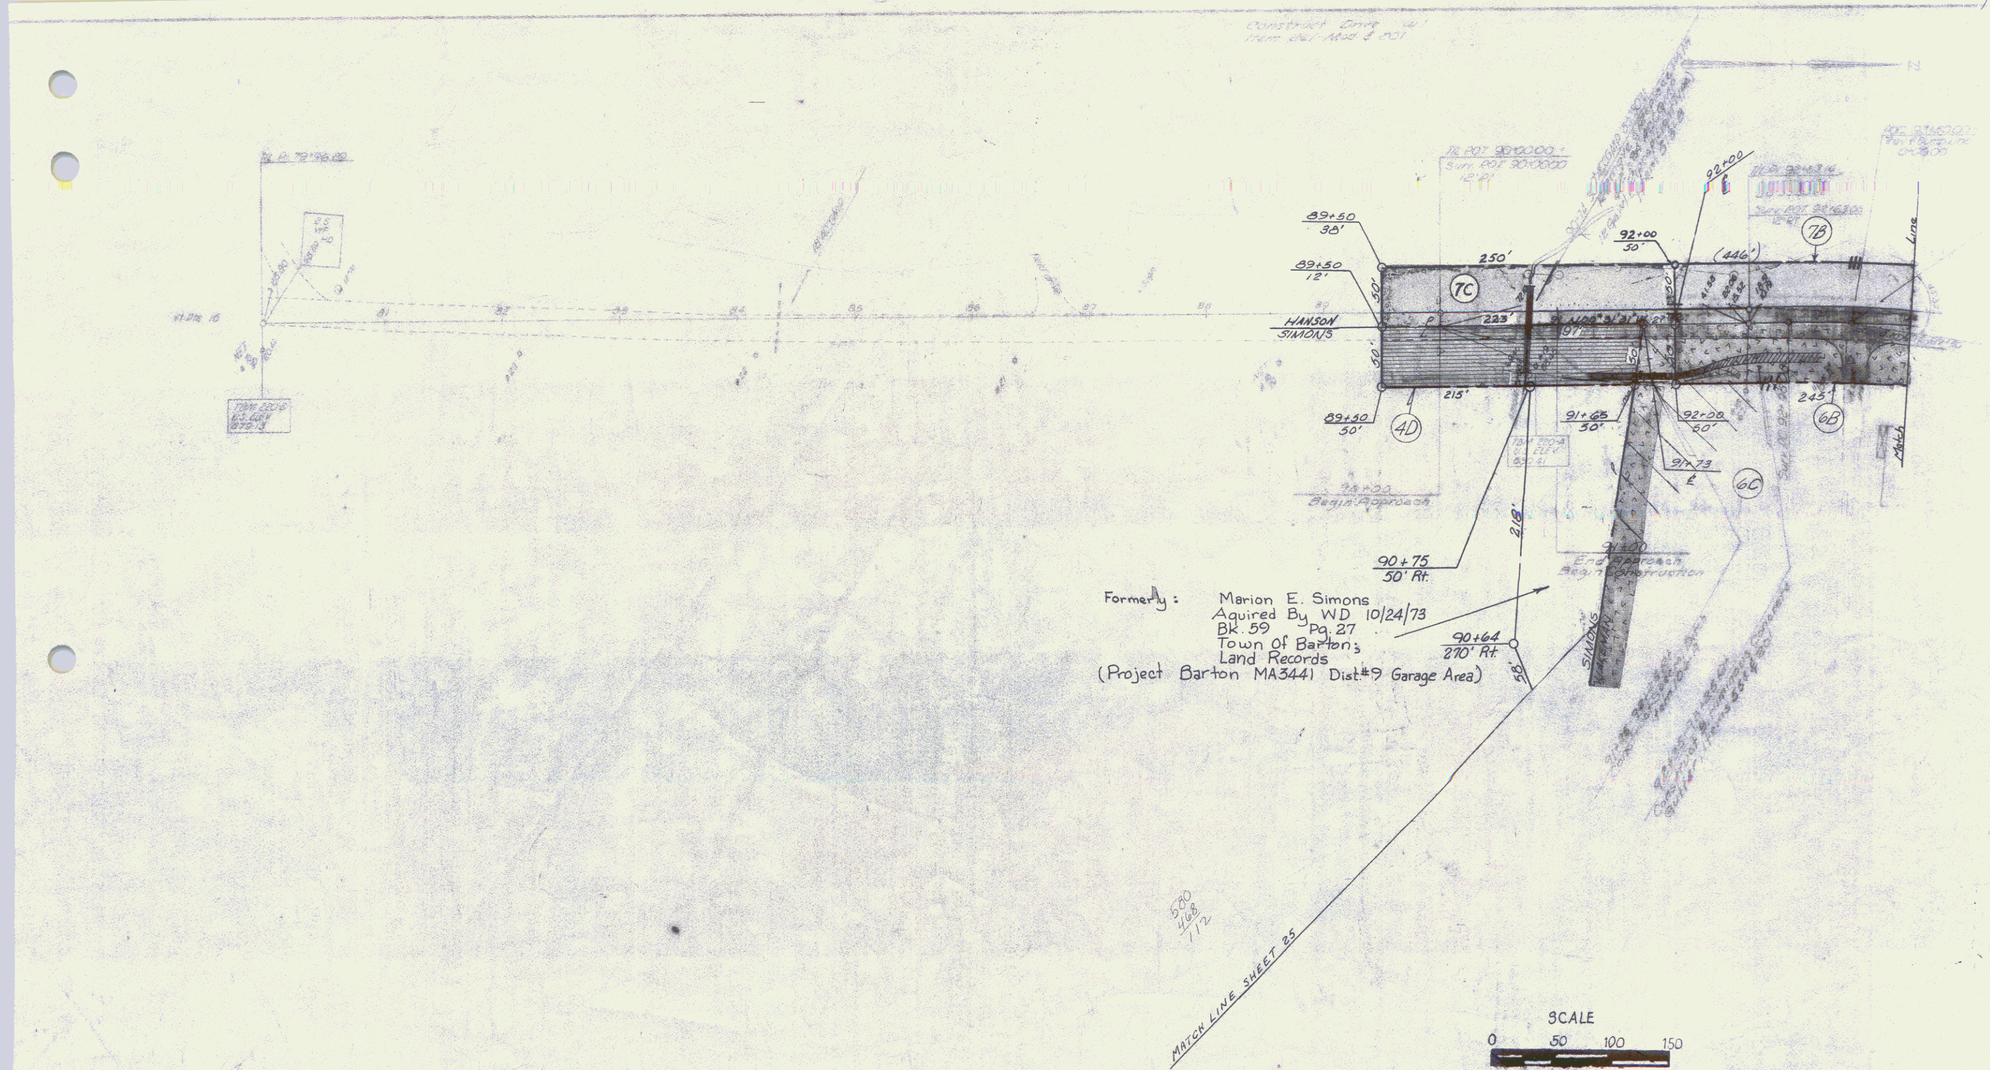
89+50
38'
89+50
12'
89+50
50'
92+00
50'
92+00
℄
250'
(446')
223'
215'
243'
7C
7B
6B
6C
4D
HANSON
SIMONDS
91+65
50'
92+00
50'
91+73
℄
92+23
Begin Approach
90+75
50' Rt.
90+64
270' Rt.
218'
219'
End Approach
Begin Construction
SIMONDS
EDWARD
Formerly:
Marion E. Simons
Aquired By WD 10/24/73
Bk. 59 Pg. 27
Town of Barton;
Land Records
(Project Barton MA3441 Dist.#9 Garage Area)
580
468
172
MATCH LINE SHEET 25
SCALE
0 50 100 150
VERMONT DEPARTMENT OF HIGHWAYS
RIGHT - OF - WAY PLANS
PROJECT. BARTON - IRASBURG
NO. I 91 - 3(15)
SHEET. 26 OF. 88