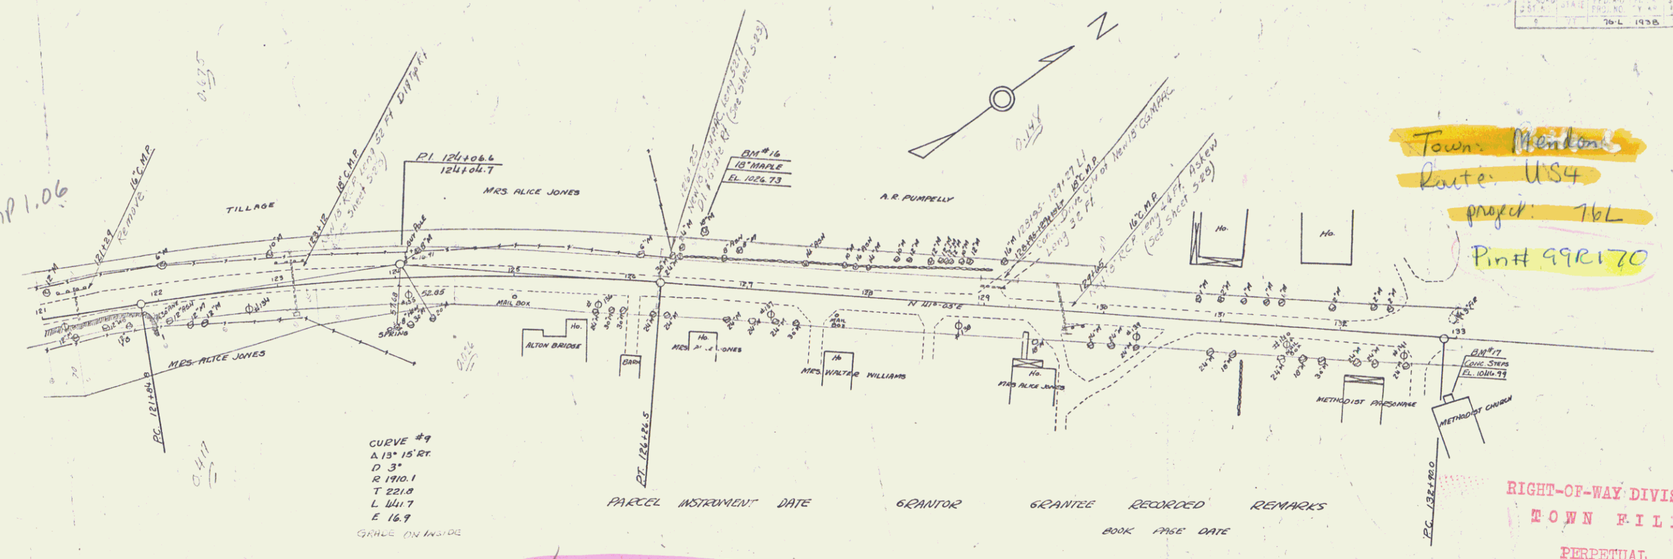Town: Mendon
Route: US4
project: 76L
Pin# 99R170