INDEX OF SHEETS

Sht.		
SHT. 1		TITLE PAGE
2	BR 101	PLAN AND PROFILE
3	102	QUANTITY SHEET
4	103	PLAN AND ELEVATION
5	104	SUPERSTRUCTURE DETAILS
6	105	ABUTMENT #1
7	106	ABUTMENT #2
8	107	REINFORCING SCHEDULE
9-10	108-9	CHANNEL SECTIONS
11-14	110-13	ROADWAY SECTIONS
15	200	PLAN AND PROFILE
16	201	QUANTITY SHEET
17	202	PLAN AND ELEVATION
18	203	SUPERSTRUCTURE DETAILS
19	204	ABUTMENTS #1 & #2
20	205	REINFORCING SCHEDULE
21-22	206-7	CHANNEL SECTIONS
23-24	208-9	ROADWAY SECTIONS
25		STD. SHT G-3 9-1-66 R
26		STD SHT E-33 1-6-67
27		STD SHT SCB-D6-67 1-24-68
28		STD SHT E-36 1-24-68
29-31		RIGHT OF WAY SHEETS

STATE OF VERMONT
DEPARTMENT OF HIGHWAYS

PROPOSED IMPROVEMENT

BRIDGE PROJECT
TOWN OF WOODSTOCK
COUNTY OF WINDSOR
US RTE. 4

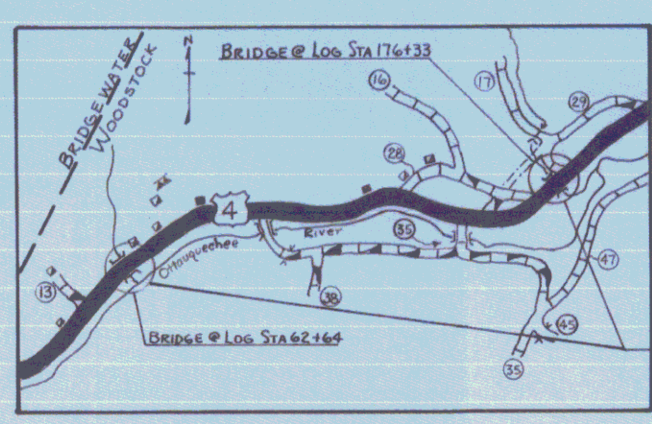

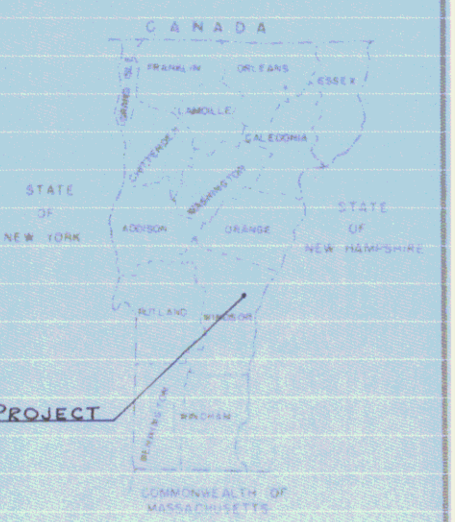

PROJECT

PROJECT CONSISTS OF TWO SEPARATE STRUCTURES LOCATED AS FOLLOWS: BEGINNING AT A POINT 1.20 MILES EAST OF THE INTERSECTION OF U.S. RTE. 4 AND THE BRIDGEWATER-WOODSTOCK TOWN LINE EXTENDING WESTERLY 0.198 MILES ALONG US RTE 4 IN THE TOWN OF WOODSTOCK AND BEGINNING AT A POINT 3.40 MILES EAST OF THE INTERSECTION OF U.S. RTE. 4 AND THE BRIDGEWATER-WOODSTOCK TOWN LINE EXTENDING EASTERLY 0.038 MILES ALONG US RTE. 4 IN THE TOWN OF WOODSTOCK.

LOG STA. 62+64
- LENGTH OF CONTRACT: 50.0 FT. = 0.009 MI.
- LENGTH OF ROADWAY: 1000.0 FT. = 0.189 MI.
- LENGTH OF PROJECT: 1050.0 FT. = 0.198 MI.

LOG STA 176+33
- LENGTH OF CONTRACT: 50.0 FT. = 0.009 MI.
- LENGTH OF ROADWAY: 150.0 FT. = 0.028 MI.
- LENGTH OF PROJECT: 200.0 FT. = 0.038 MI.

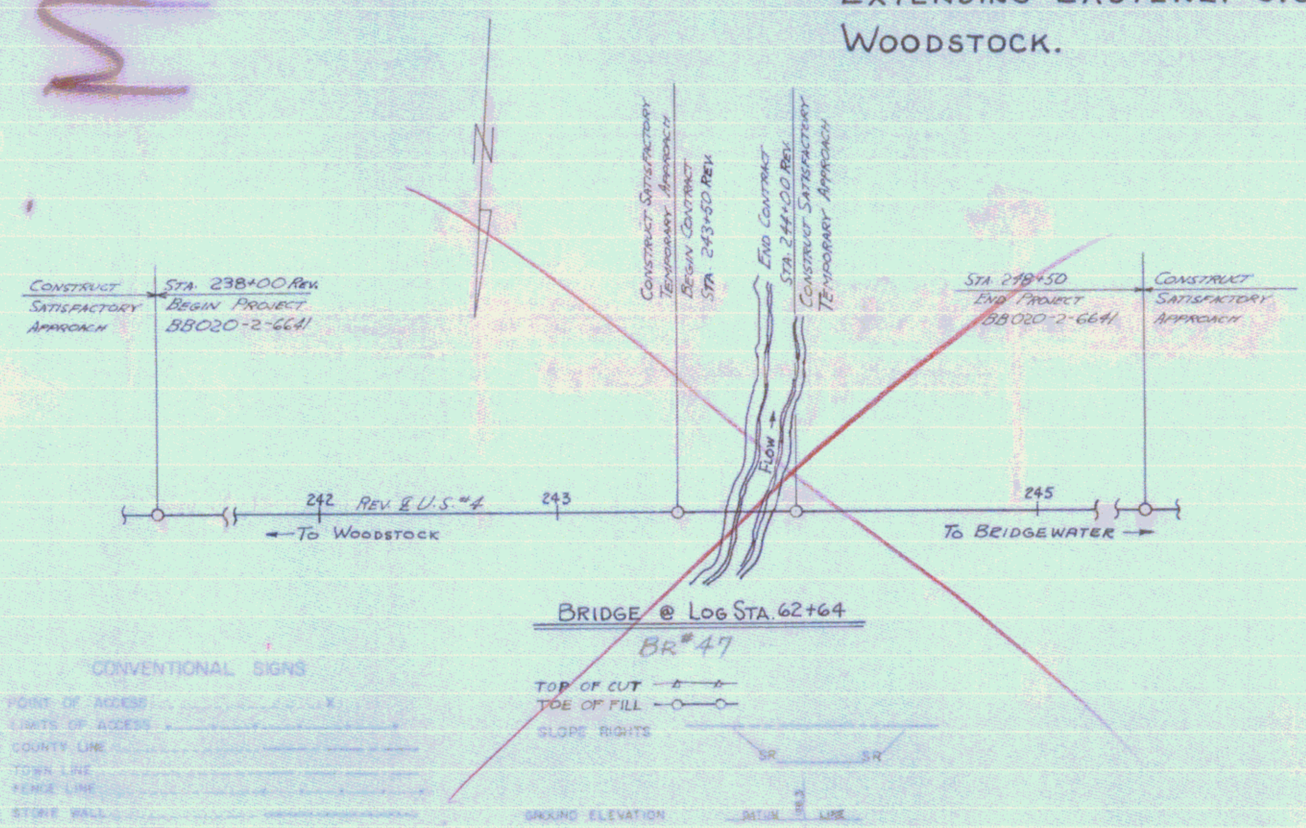

BRIDGE @ LOG STA 62+64

BR # 47

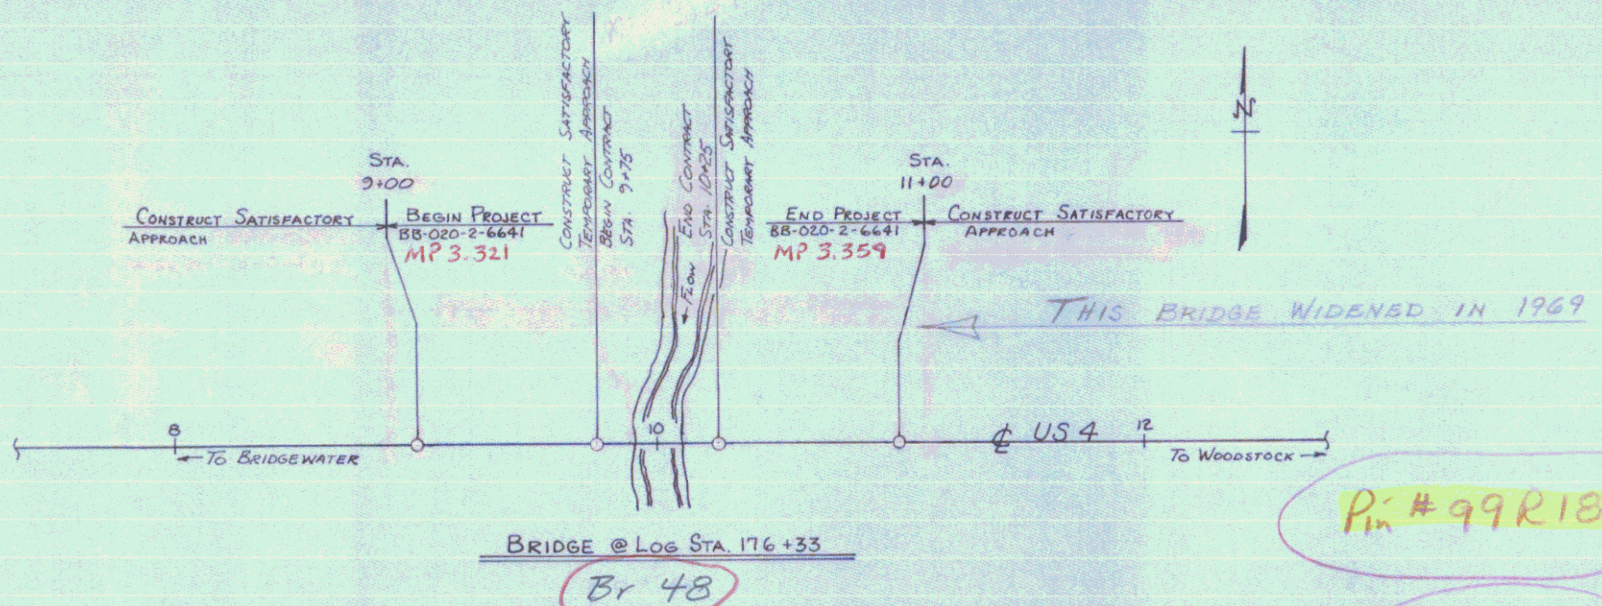

BRIDGE @ LOG STA. 176+33

Br 48

Pin # 99R188

4/12/1968

CONVENTIONAL SIGNS

TOP OF CUT
TOE OF FILL
SLOPE RIGHTS

FOR RIGHT OF WAY DETAILS, SEE RIGHT OF WAY PLANS FOR THIS PROJECT.

THESE PLANS ARE SUBJECT TO SUCH REVISIONS AS MAY BE REQUIRED BY THE COMMISSIONER OF HIGHWAYS.

CONSTRUCTION IS TO BE CARRIED ON IN ACCORDANCE WITH THESE PLANS AND THE STANDARD SPECIFICATIONS FOR HIGHWAY AND BRIDGE CONSTRUCTION DATED APRIL 1964, AS APPROVED BY THE BUREAU OF PUBLIC ROADS ON OCTOBER 1, 1964, INCLUDING ALL SUBSEQUENT APPROVED REVISIONS AND SUPPLEMENTAL SPECIFICATIONS AND SPECIAL PROVISIONS AS ARE INCORPORATED IN THESE PLANS.

APPROVED	APPROVED	APPROVED	APPROVED	APPROVED	APPROVED
DATE 3/26/68	DATE 1 Aug 68	DATE 6/26/68	DATE 8-6-68	DATE 6/27/68	DATE Aug 28 1968

PROJECT BB 020-2-6641

SHEET 1 OF 31 SHEETS