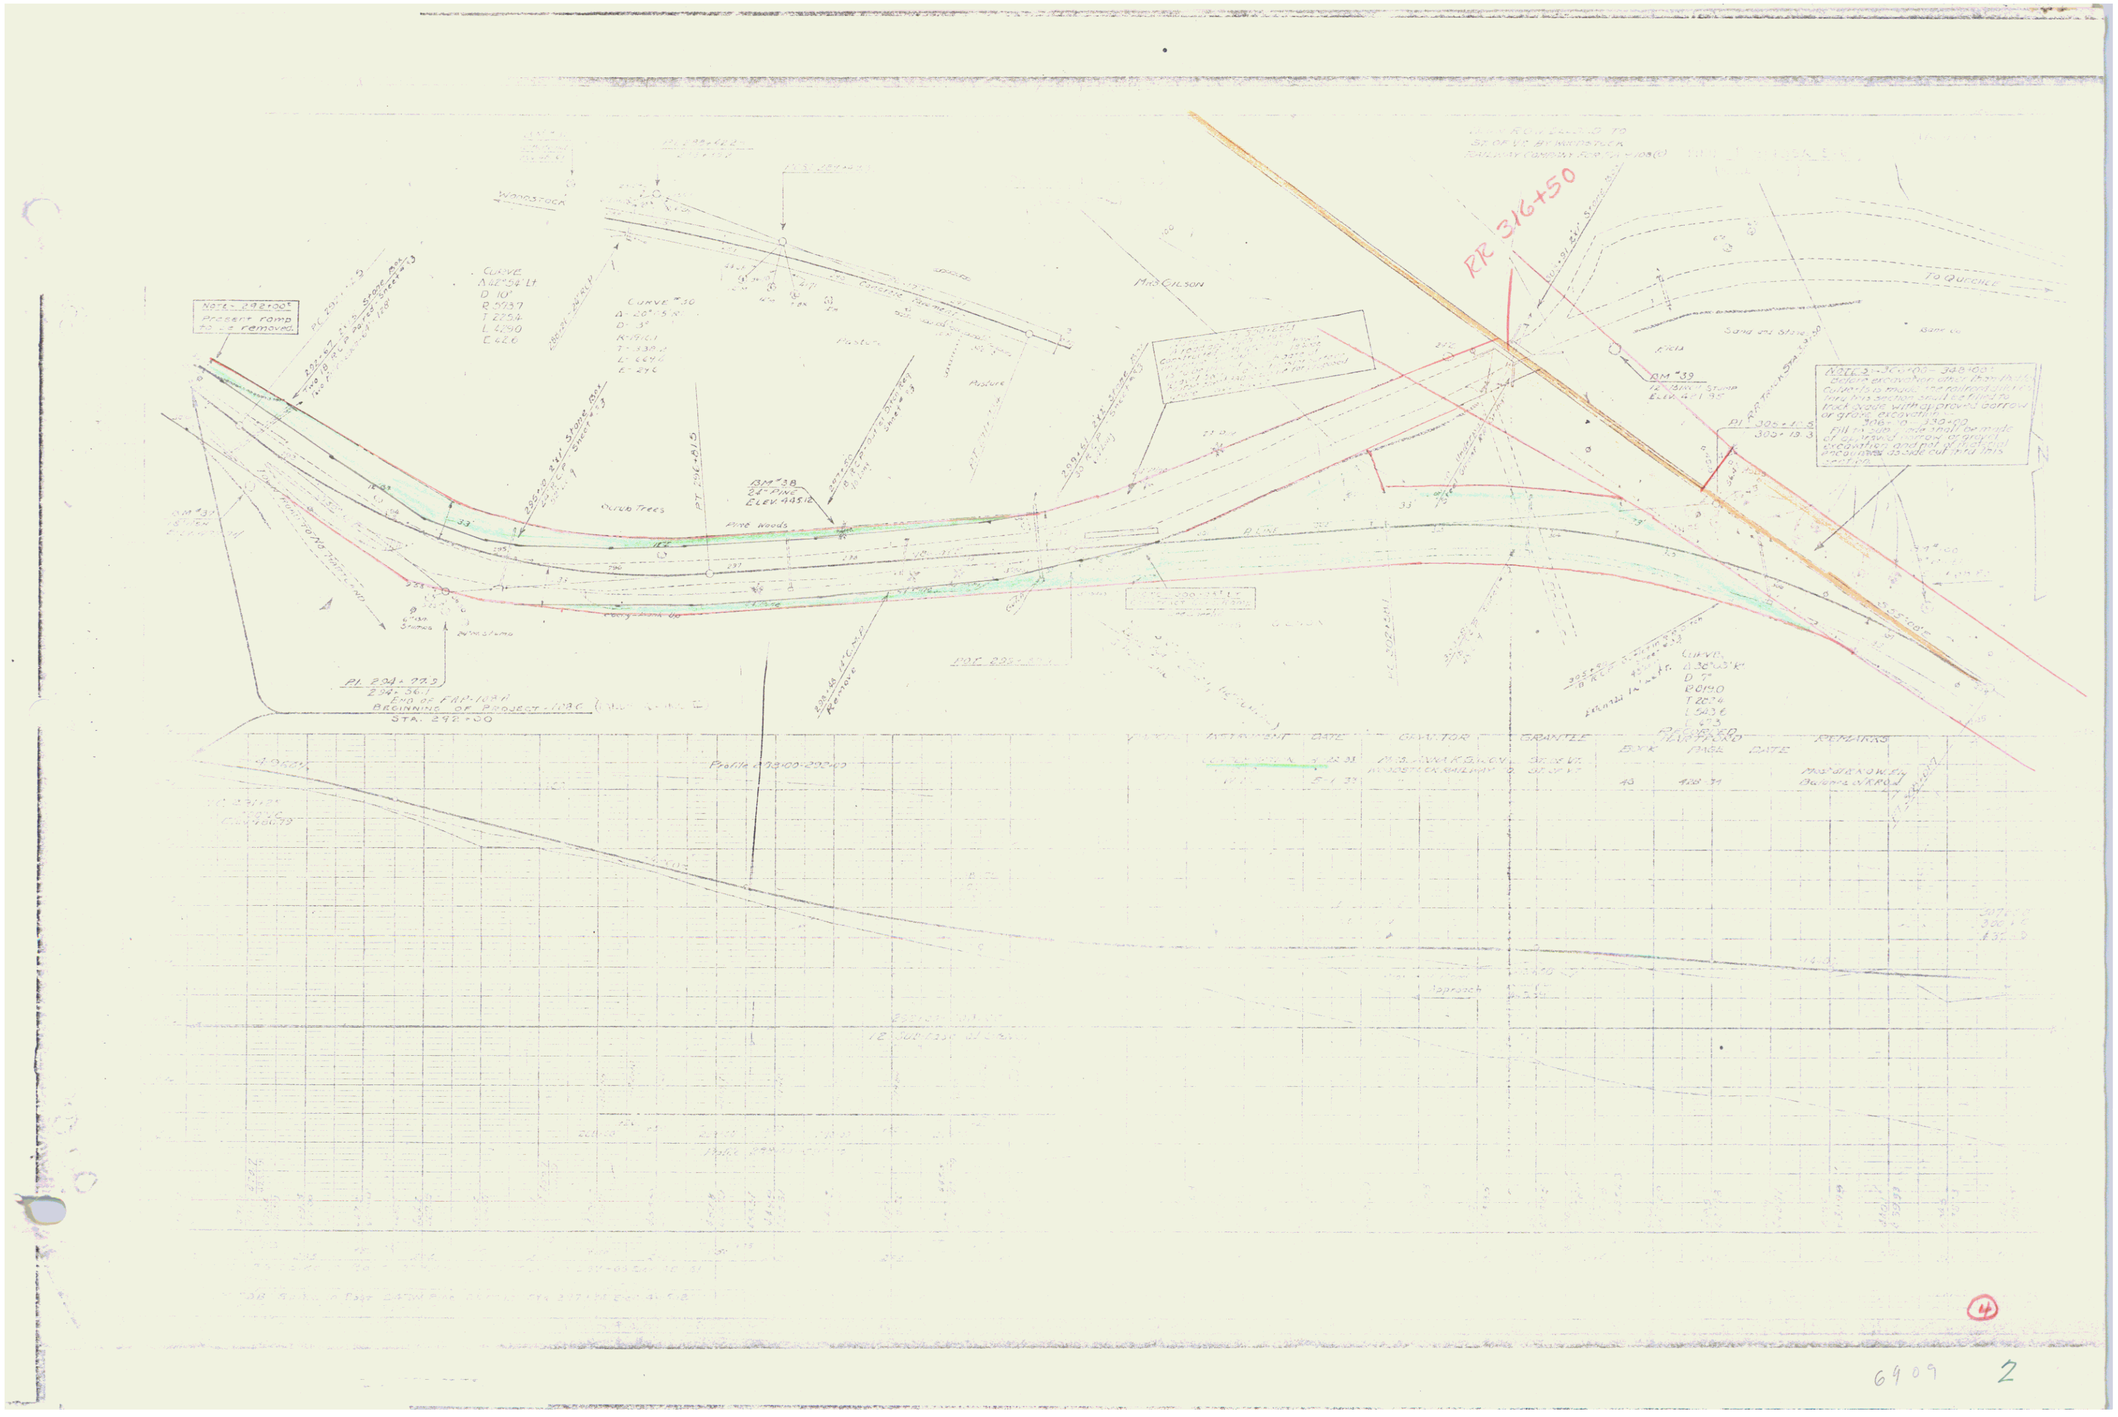
RR 316+50
Woodstock
MacGILSON
TO QUINCHE
Note: 292+00? Present ramp to be removed.
PI 294+92.5
294+36.1
End of FAP-104?
BEGINNING OF PROJECT-104C
STA. 292+00
Profile 278+00-290+00
Pine Woods
Scrub Trees
Pasture
Orchard
Approach
PROPOSED PLANTING
REMARKS
INSTRUMENT
DATE
BOOK
PAGE
DATE
MISCELLANEOUS SURVEYS

6909 2