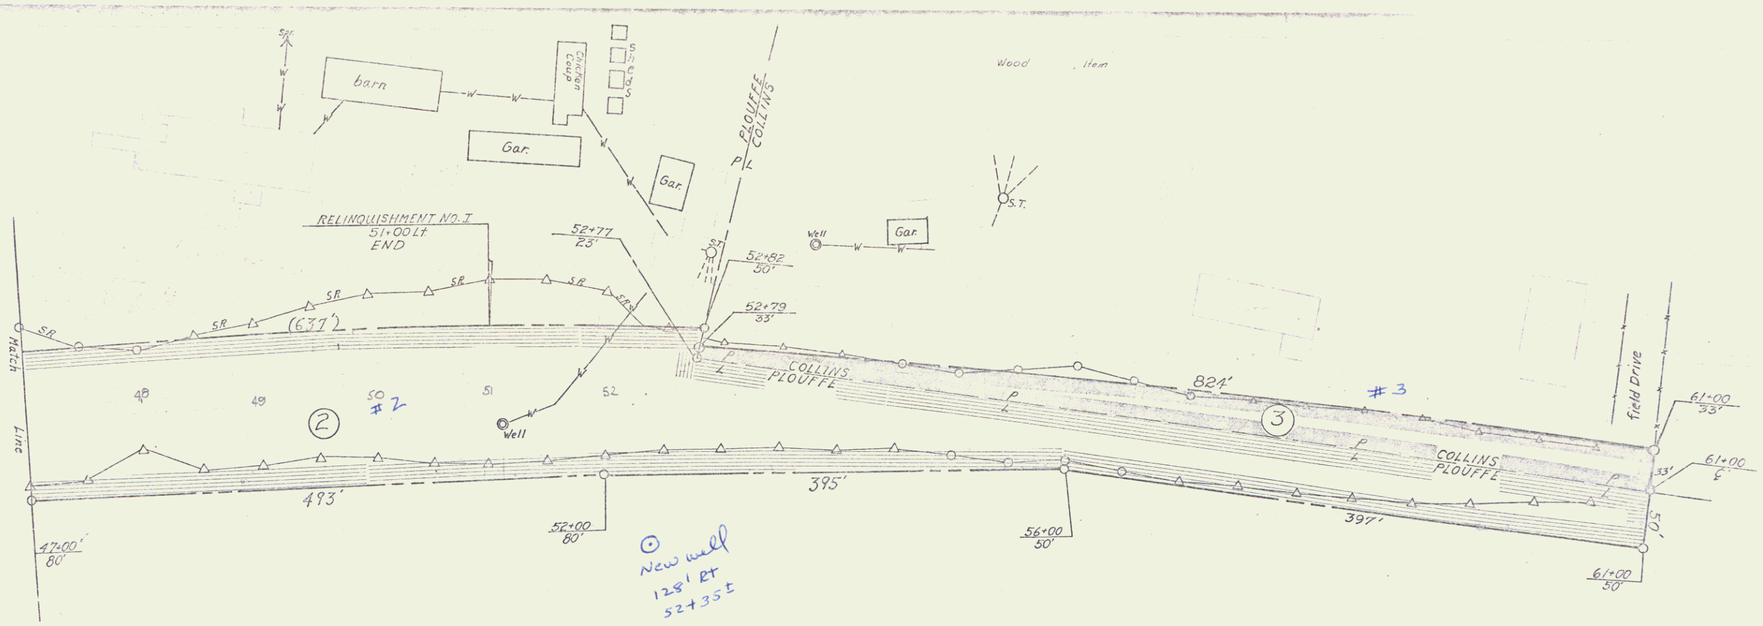
barn
Chicken Coop
Gar.
Gar.
Gar.
Wood
Item
PLOUFFE
COLLINS
P/L
S.T.
Well
Gar.
RELINQUISHMENT NO. I
51+00 Lt
END
52+77
25'
52+82
30'
52+79
33'
(637')
SR
Hatch
Line
48
49
50
#2
51
52
2
Well
COLLINS
PLOUFFE
824'
#3
3
COLLINS
PLOUFFE
field Drive
61+00
33'
61+00
℄
33'
50'
397'
395'
493'
47+00
80'
52+00
80'
56+00
50'
61+00
50'
New well
128' Rt
52+35±

5 5
3