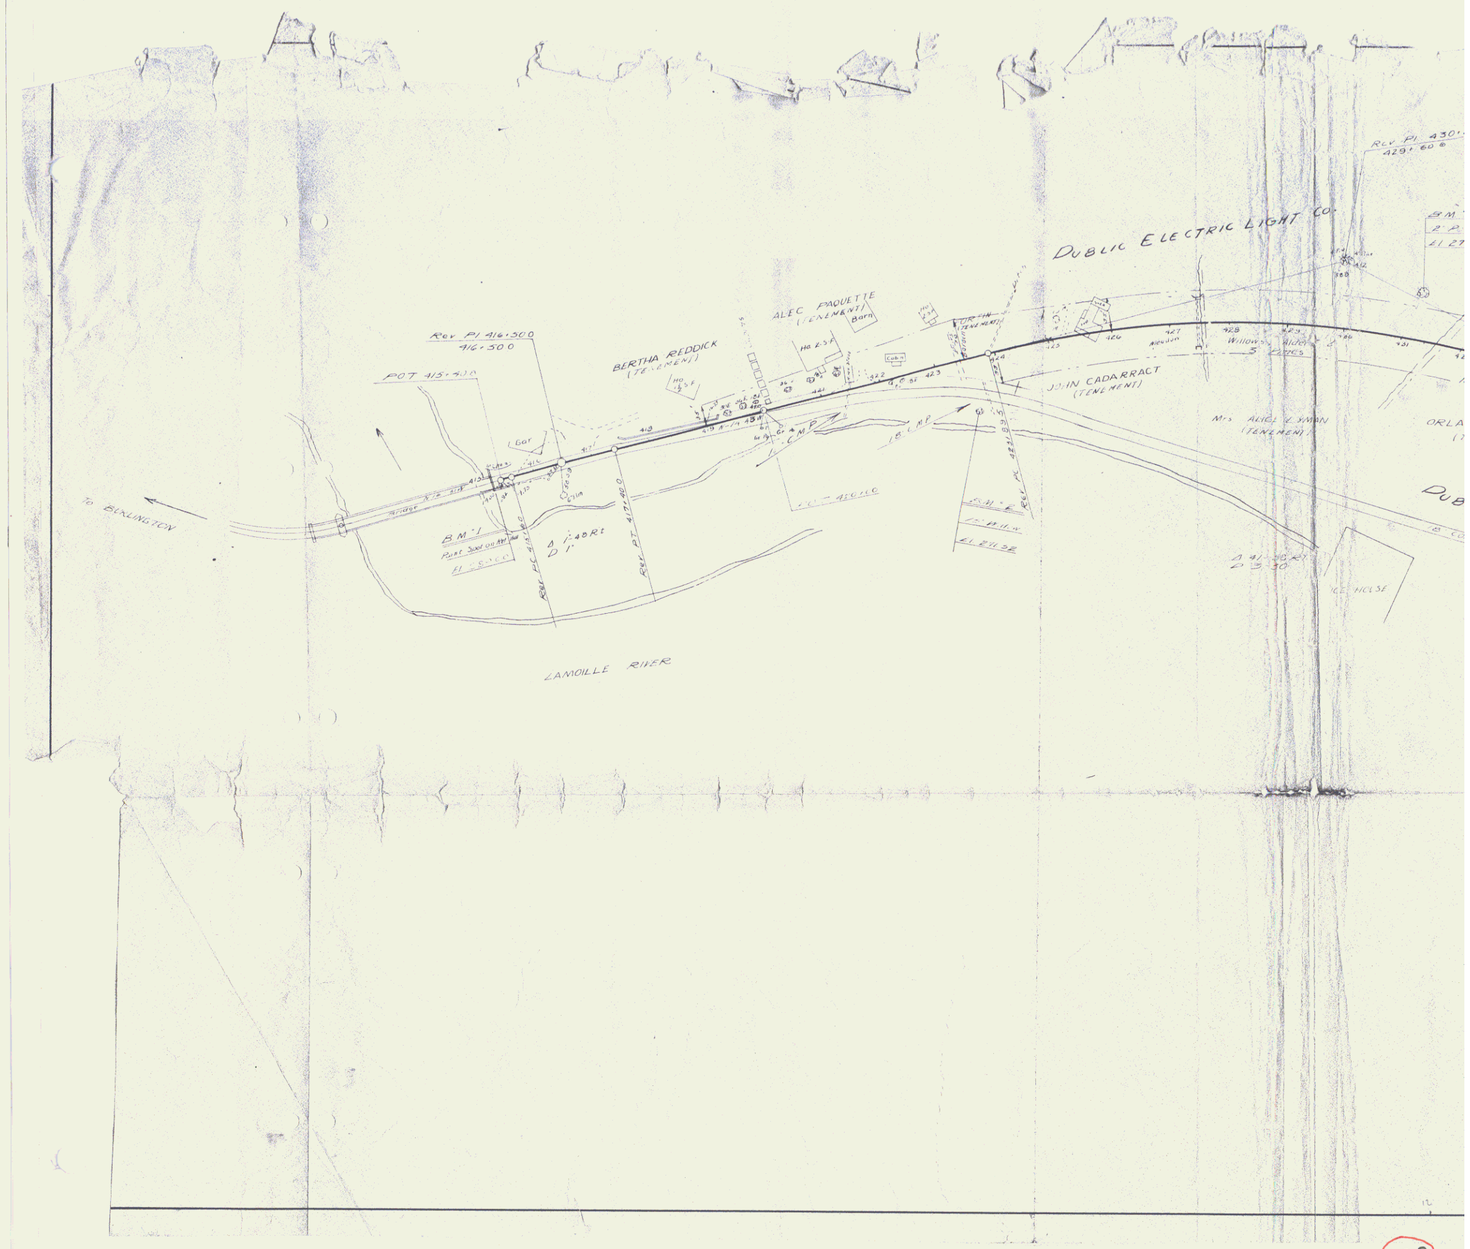
DUBLIC ELECTRIC LIGHT CO.
Rev Pl 430+
429+60
BM
ALEC PAQUETTE
(TENEMENT)
Barn
Rev Pl 416+500
416+500
POT 415+90
BERTHA REDDICK
(TENEMENT)
JOHN CADARRACT
(TENEMENT)
Mrs ALICE LYMAN
(TENEMENT)
Willows
Alder
Gar
TO BURLINGTON
BM
Post Spot on Ap
El 1010
Rev Pl 417+00
Rev Pl 428+95
ICE HOUSE
LAMOILLE RIVER

228

23