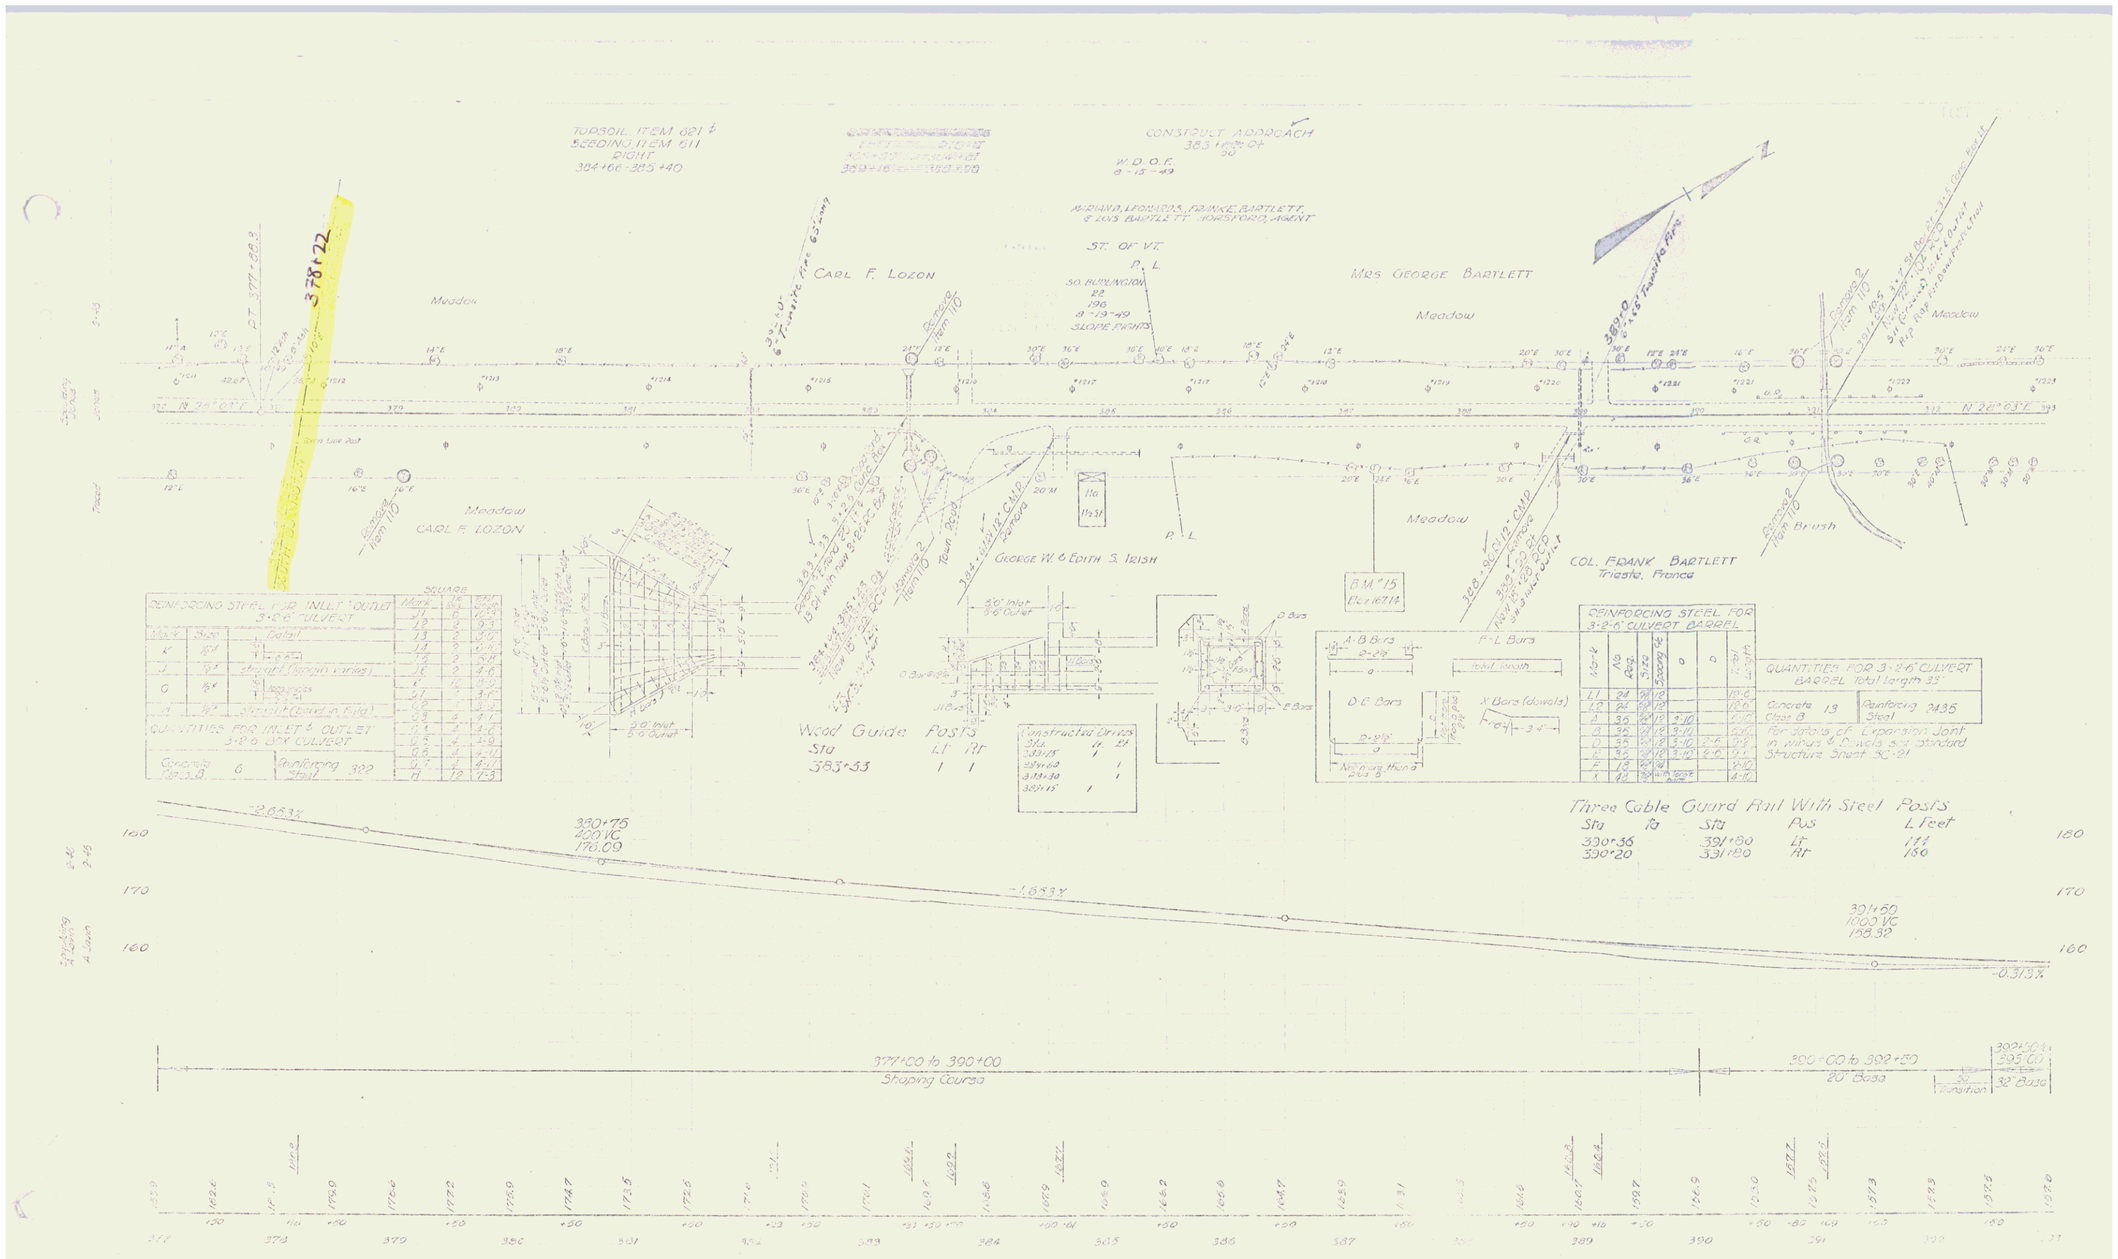
TOPSOIL, ITEM 621 &
SEEDING, ITEM 611
RIGHT
384+66 - 385+40
CONSTRUCT APPROACH
383+50 Rt
W. D. O. E.
8-13-49
MARIANO, LEONARDS, FRANKIE, BARTLETT,
& LOIS BARTLETT MORSFORD, AGENT
ST. OF VT.
CARL F. LOZON
MRS GEORGE BARTLETT
Meadow
Slope Rights
Property Line
Fence
Stone Line Post
Wood Guide Posts
Sta Lt Rt
383+53 1 1
Constructed Drives
Sta Lt Rt
387+15 1
GEORGE W. & EDITH S. IRISH
COL. FRANK BARTLETT
Trieste, France
B.M. #15
REINFORCING STEEL FOR INLET & OUTLET
3'-0" CULVERT
QUANTITIES FOR INLET & OUTLET
3'-0" SQ. CULVERT
Concrete 6 Cu. Yds.
Reinforcing Steel 382 Lbs.
REINFORCING STEEL FOR
3'-0"ϕ CULVERT BARREL
QUANTITIES FOR 3'-0" CULVERT
BARREL total length 33'
Concrete Class B 13 Cu. Yds.
Reinforcing Steel 2435 Lbs.
For details of Expansion Joint
in Wings & Dowels see standard
Structure Sheet SC-91
A-B Bars
D-E Bars
F-L Bars
X Bars (dowels)
Three Cable Guard Rail With Steel Posts
Sta To Sta Rus L feet
380+75
391+60
1000 VC
-2.663%
-1.653%
-0.313%
377+00 to 390+00
Shaping Course
390+00 to 392+50
20' Base
392+50 to 395.00
32' Base
Transition
SHELBURNE-SOUTH BURLINGTON
Sheet 21 of 73 Sheets