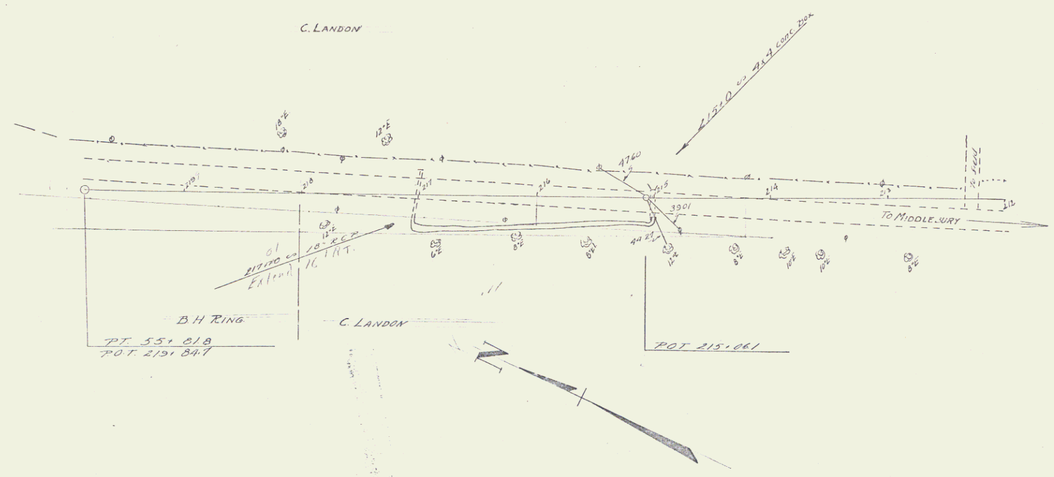
C. LANDON
B.H RING
C. LANDON
PT 55+ 61.8
POT 213+ 84.7
POT 215+ 06.1

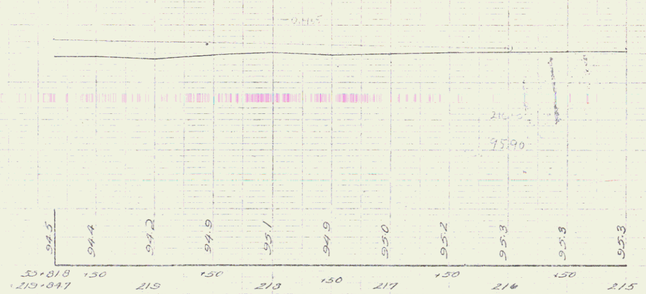
100
90
94.5
94.4
94.2
94.9
95.1
94.9
95.0
95.2
95.3
95.3
95.3
55+818
219+847
+50
219
+50
213
+50
217
+50
214
+50
215

3

3