62-E

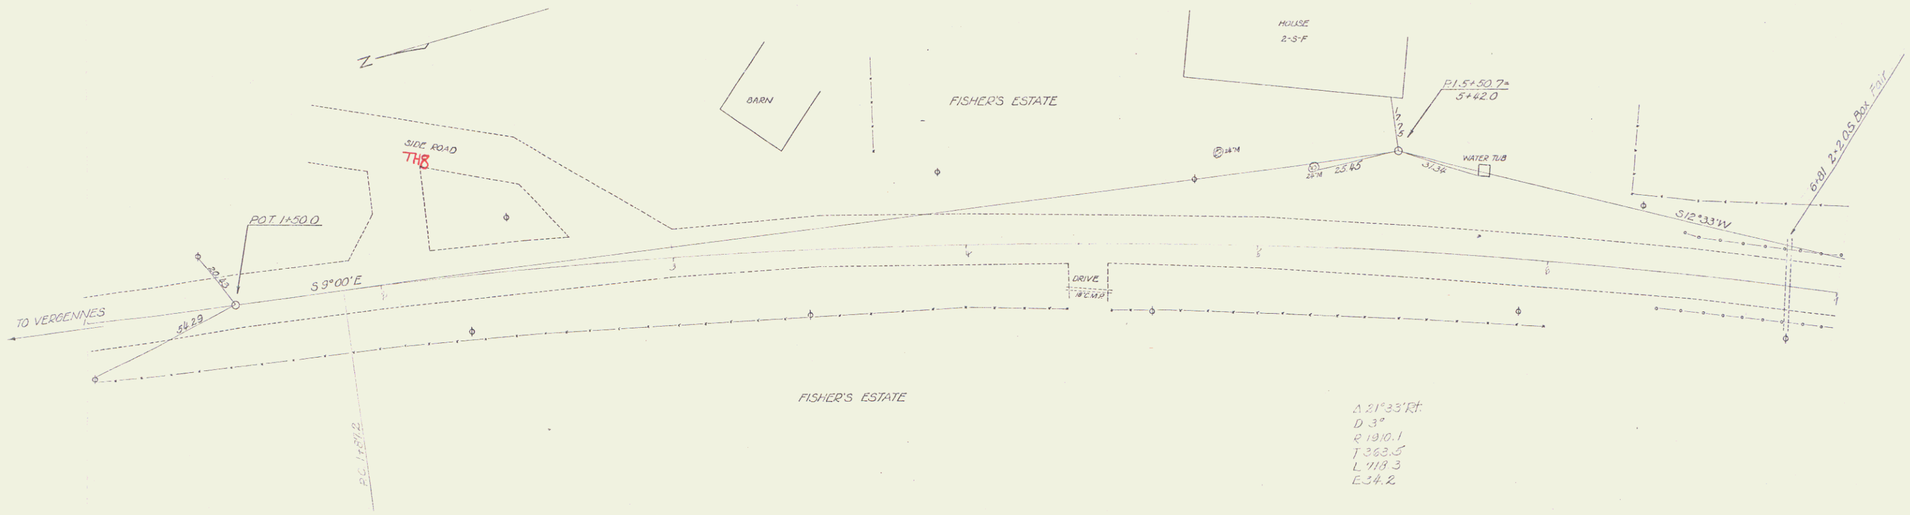

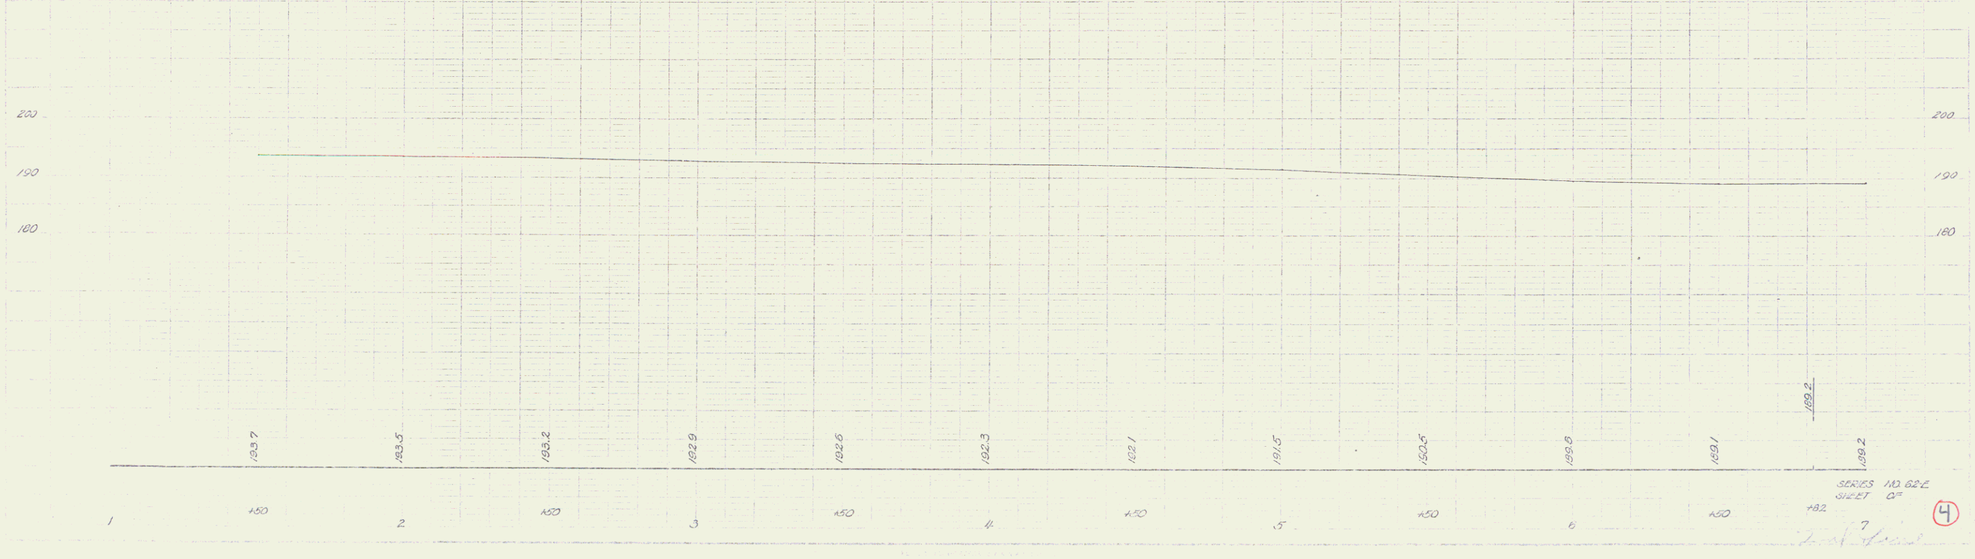

SERIES NO. 62-E
SHEET 0F

4

4