WOOD GUARD RAIL STATION	LEFT	RIGHT
323+46	26'	26'
323+75	26'	26'
327+20	—	26'
329+65	—	26'

GUIDE POSTS OF WOOD STATION	LEFT	RIGHT
314+20	—	1
327+20	1	—
329+65	1	—

N.R.H. 111-A 1932 S. 35
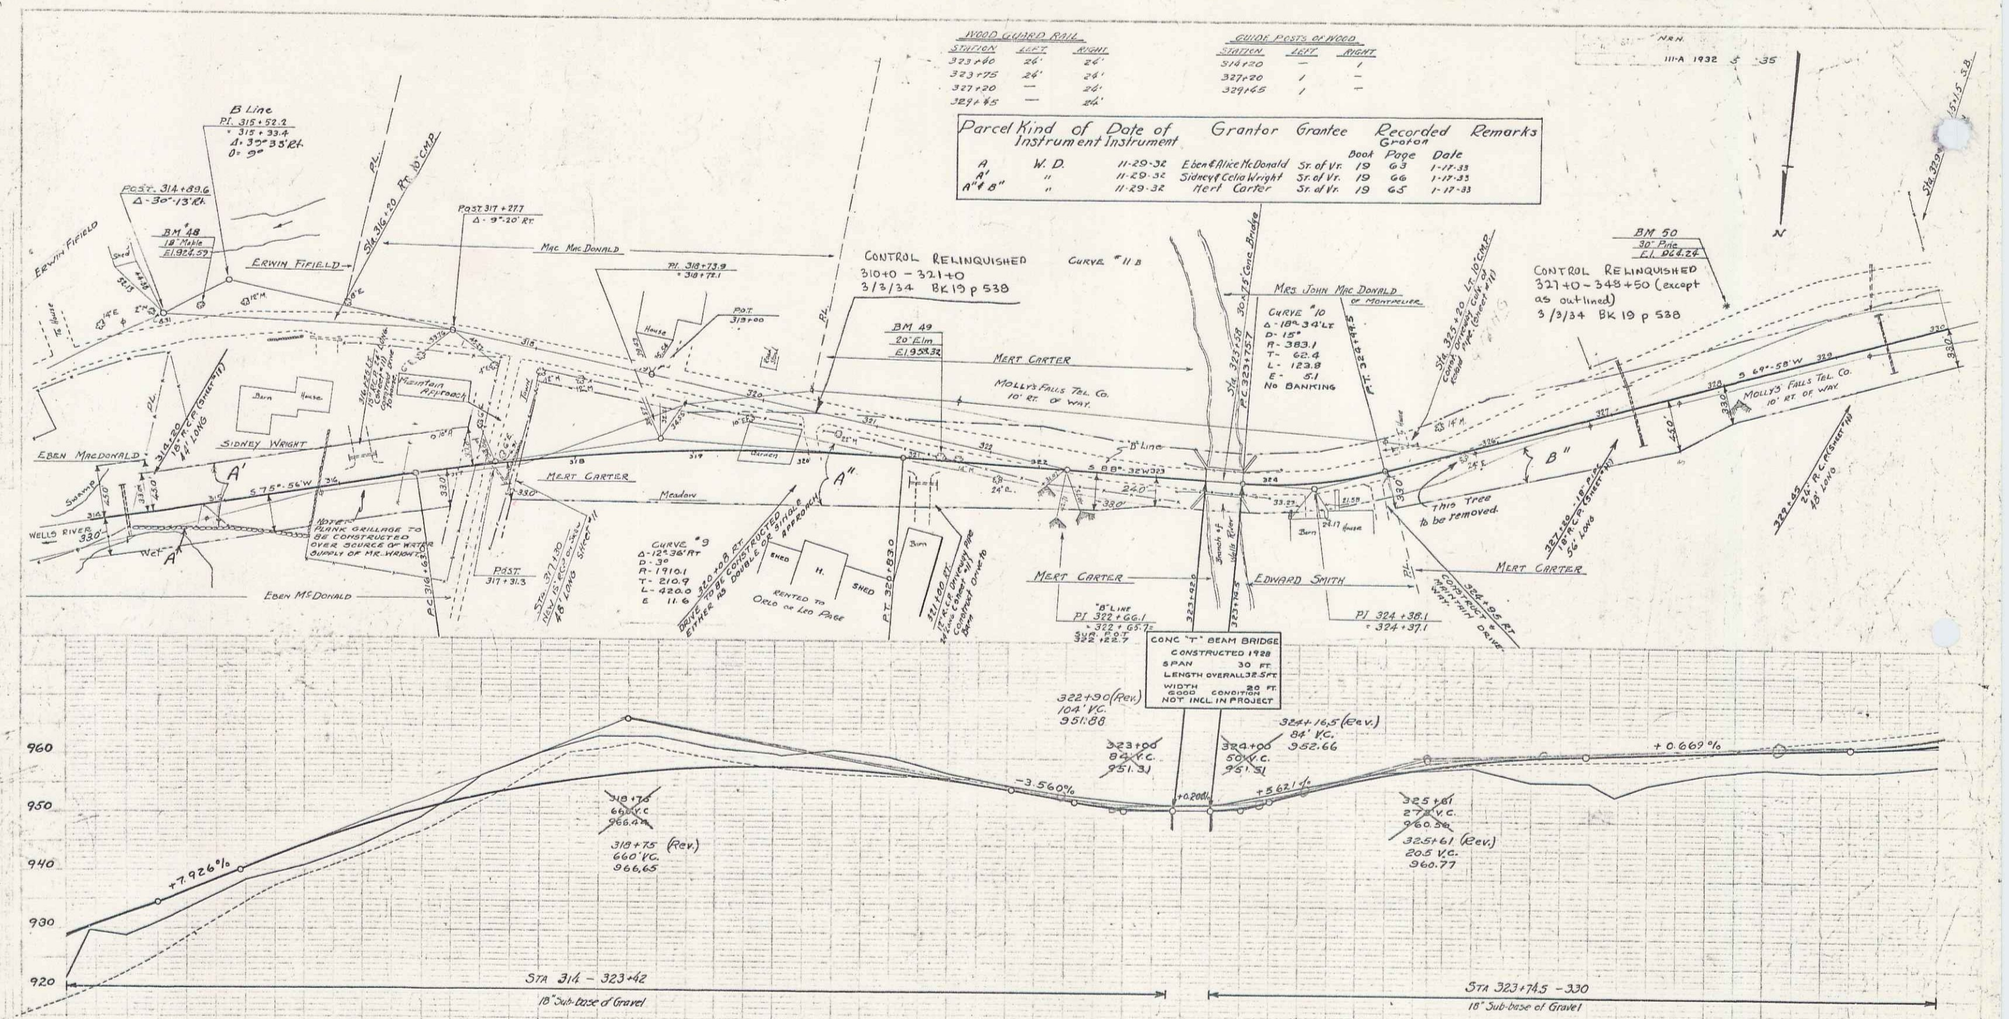
Parcel	Kind of Instrument	Date of Instrument	Grantor	Grantee	Recorded Grantor Book	Page	Date	Remarks
A	W. D.	11-29-32	Eben & Alice McDonald	Sr. of Vr.	19	63	1-17-33	
A'	"	11-29-32	Sidney & Celia Wright	Sr. of Vr.	19	66	1-17-33	
A" & B"	"	11-29-32	Mert Carter	Sr. of Vr.	19	65	1-17-33