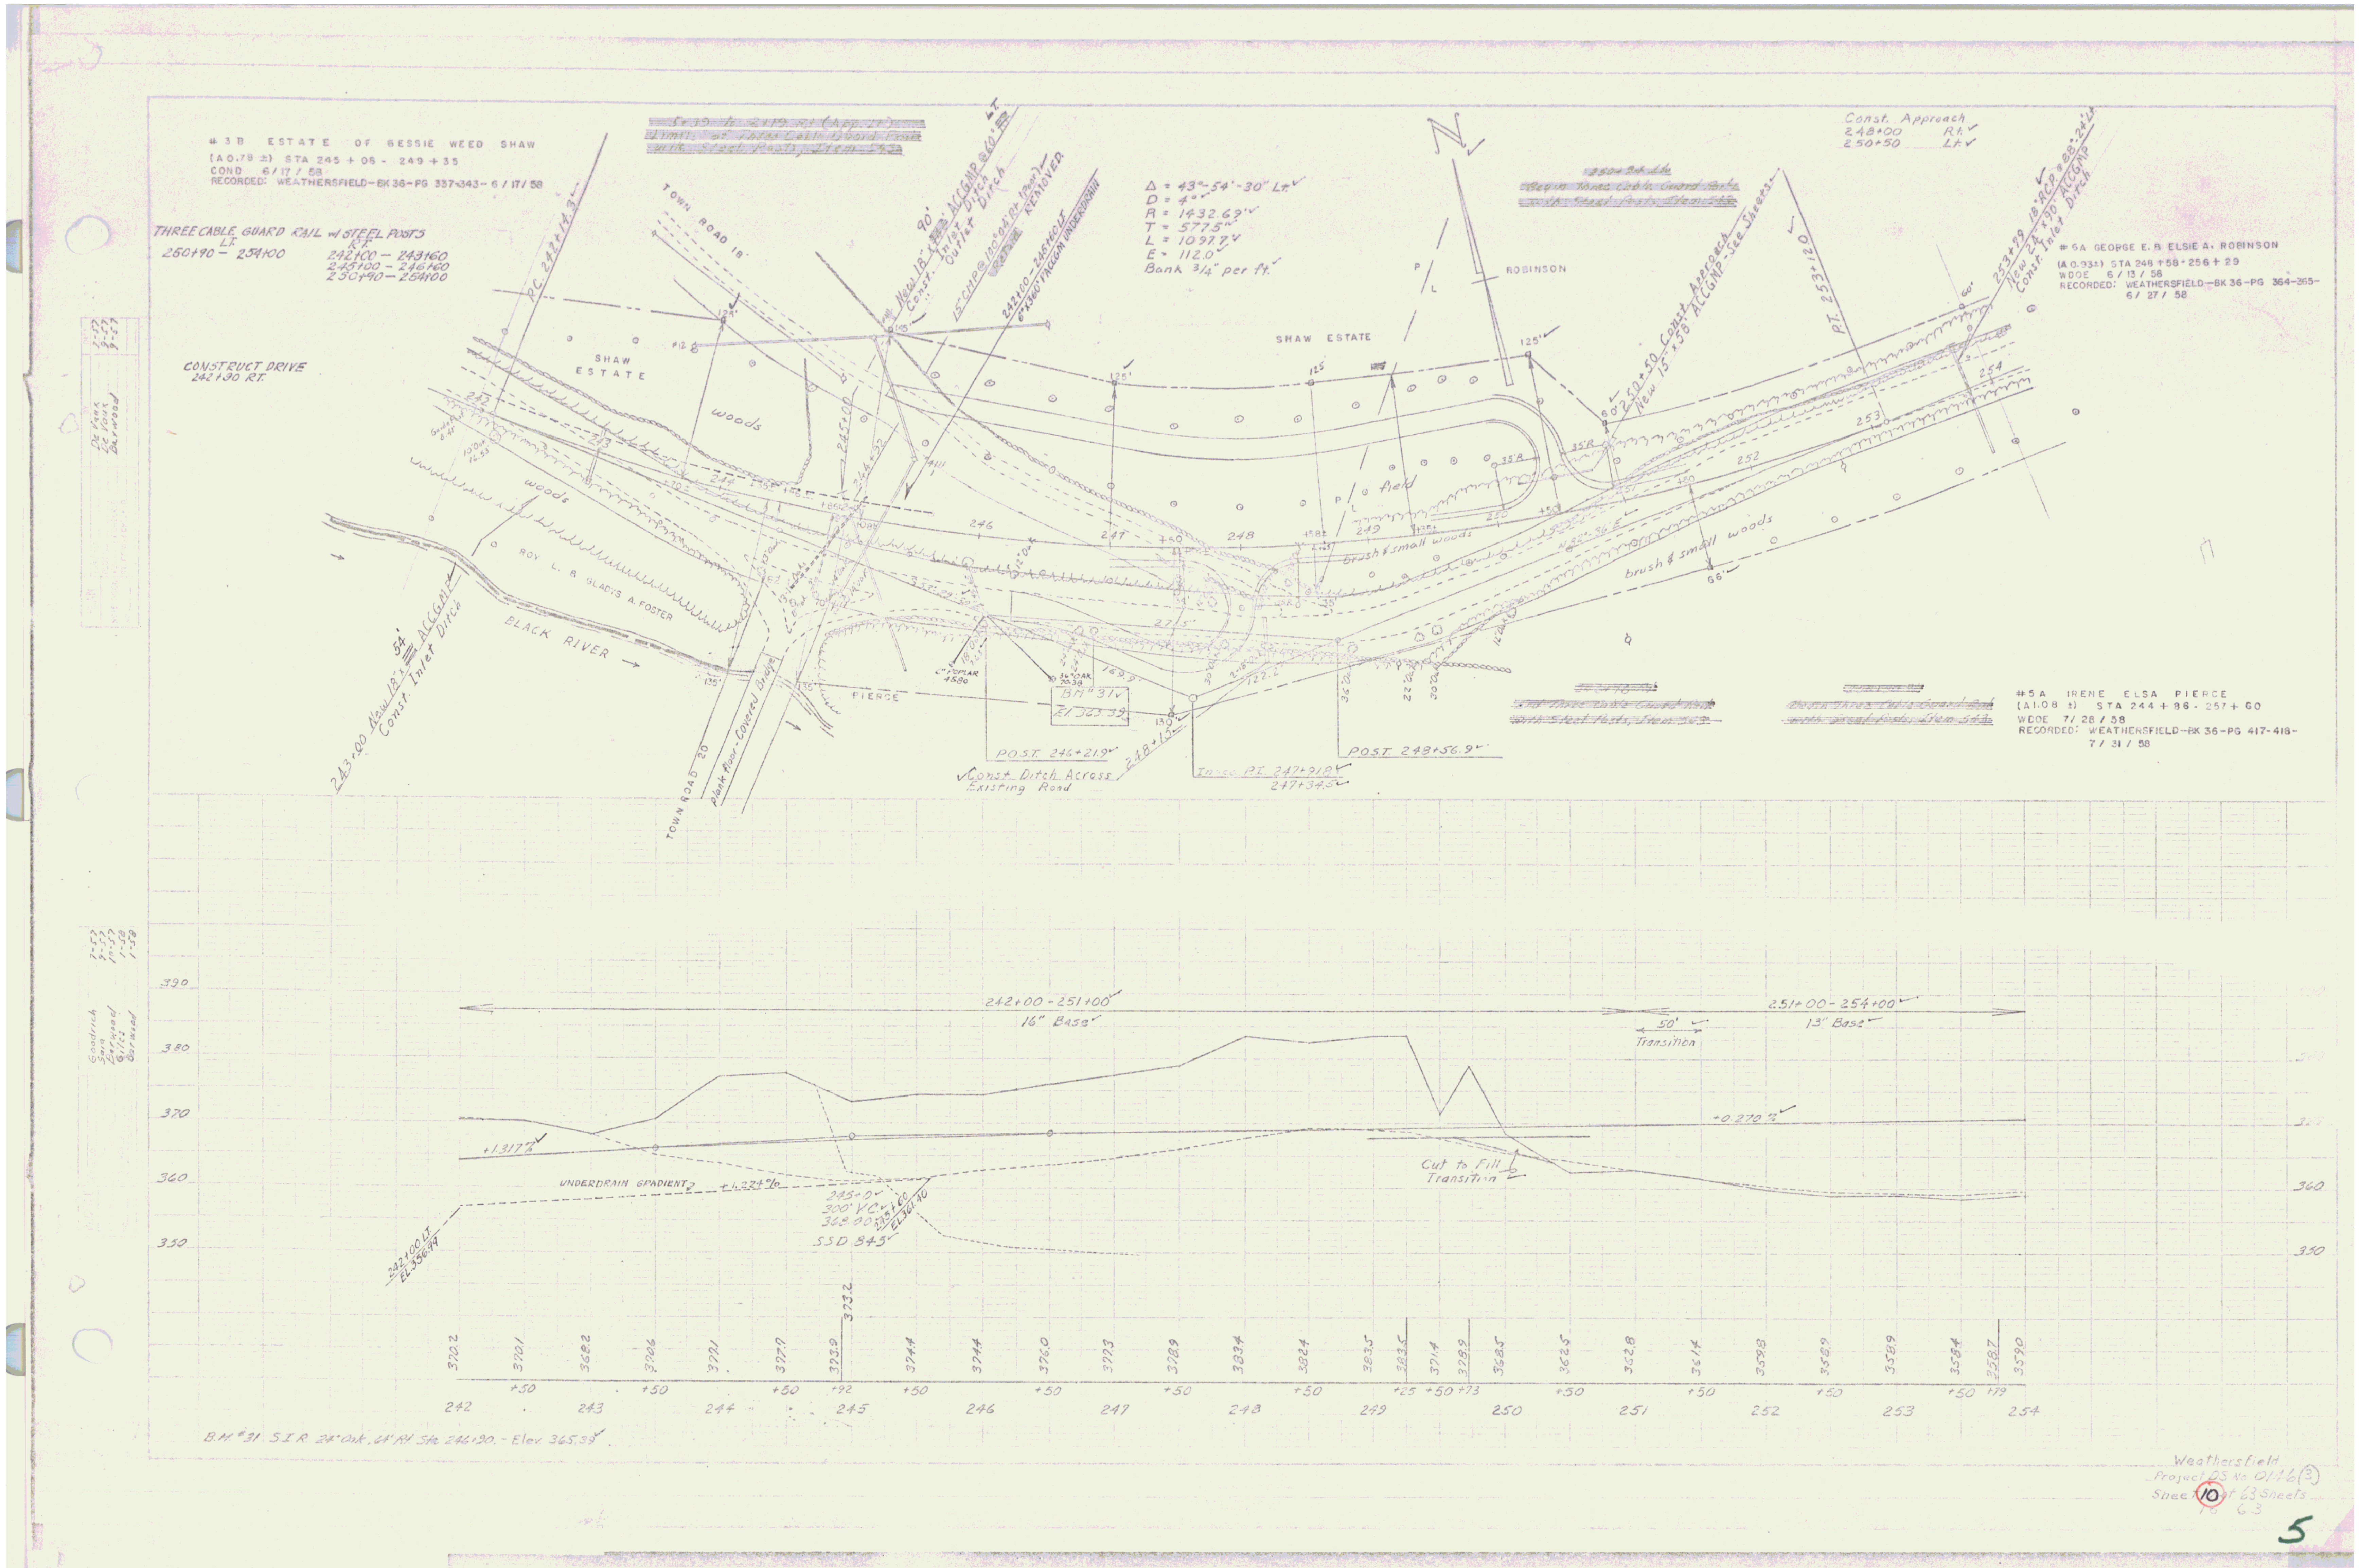

#3B ESTATE OF BESSIE WEED SHAW
(A 0.78 ±) STA 245 + 06 - 249 + 35
COND 6 / 17 / 58
RECORDED: WEATHERSFIELD-BK 36-PG 337-343- 6 / 17 / 58
THREE CABLE GUARD RAIL w/ STEEL POSTS
LT. 250+90 – 254+00
RT. 242+00 – 243+60
245+00 – 246+60
250+90 – 254+00
CONSTRUCT DRIVE
242+90 RT.
P.C. 242+14.3
TOWN ROAD 18
SHAW ESTATE
woods
New 18" x 90' ACCGMP @ 60° LT.
Const. Inlet Ditch
Outlet Ditch
15" CMP @ 100° 04' Rt (Poor) REMOVED
242+00 – 245+60 LT.
6" x 360' ACCGM UNDERDRAIN
Δ = 43°-54'-30" Lt.
D = 4°
R = 1432.69'
T = 577.5'
L = 1097.7'
E = 112.0'
Bank 3/4" per ft.
N
ROBINSON
SHAW ESTATE
Const. Approach
248+00 Rt.
250+50 Lt.
250+50 Const. Approach
New 15" x 58' ACCGMP - See Sheets
P.T. 253+12.0
253+79 18" RCP @ 88° 24' Lt.
New 24" x 90' ACCGMP
Const. Inlet Ditch
#6A GEORGE E. & ELSIE A. ROBINSON
(A 0.93±) STA 246 + 58 - 256 + 29
WDOE 6 / 13 / 58
RECORDED: WEATHERSFIELD—BK 36-PG 364-365-
6 / 27 / 58
field
brush & small woods
ROY L. & GLADYS A. FOOTER
BLACK RIVER
243+00 New 18" x 54' ACCGMP
Const. Inlet Ditch
TOWN ROAD 20
PIERCE
BM # 31
El. 363.39
POST 246+21.9
Const. Ditch Across Existing Road
248+15
Inrsc. P.I. 247+91.8
247+34.5
POST 248+56.9
#5A IRENE ELSA PIERCE
(A 1.08 ±) STA 244 + 86 - 257 + 60
WDOE 7 / 28 / 58
RECORDED: WEATHERSFIELD—BK 36-PG 417-418-
7 / 31 / 58
390
380
370
360
350
242+00 – 251+00
16" Base
251+00 – 254+00
13" Base
50'
Transition
+0.270 %
+1.317 %
UNDERDRAIN GRADIENT
245+0
300' V.C.
362.00
SSD 845
Cut to Fill Transition
242+00 LT
El. 354.4
3702
3701
3682
3706
3721
3729
3729
3722
3744
3744
3760
3773
3789
3834
3821
3835
3835
3714
3789
3685
3625
3628
3614
3598
3589
3589
3584
3587
3590
242
+50
243
+50
244
+50
+92
245
+50
246
+50
247
+50
248
+50
249
+25
+50
+73
250
+50
251
+50
252
+50
253
+50
+19
254
B.M. # 31 S.I.R. 24" Oak, 6' Rt. Sta. 246+30. - Elev. 365.39
Weathersfield
Project DS No. 0146(3)
Sheet 10 of 63 Sheets
10 63
5