FED. ROAD DIST. NO.	STATE	F PROJ. NO.	FISCAL YEAR	SHEET NO.	TOTAL SHEETS
9	VT.	141(4)	1947	13	70

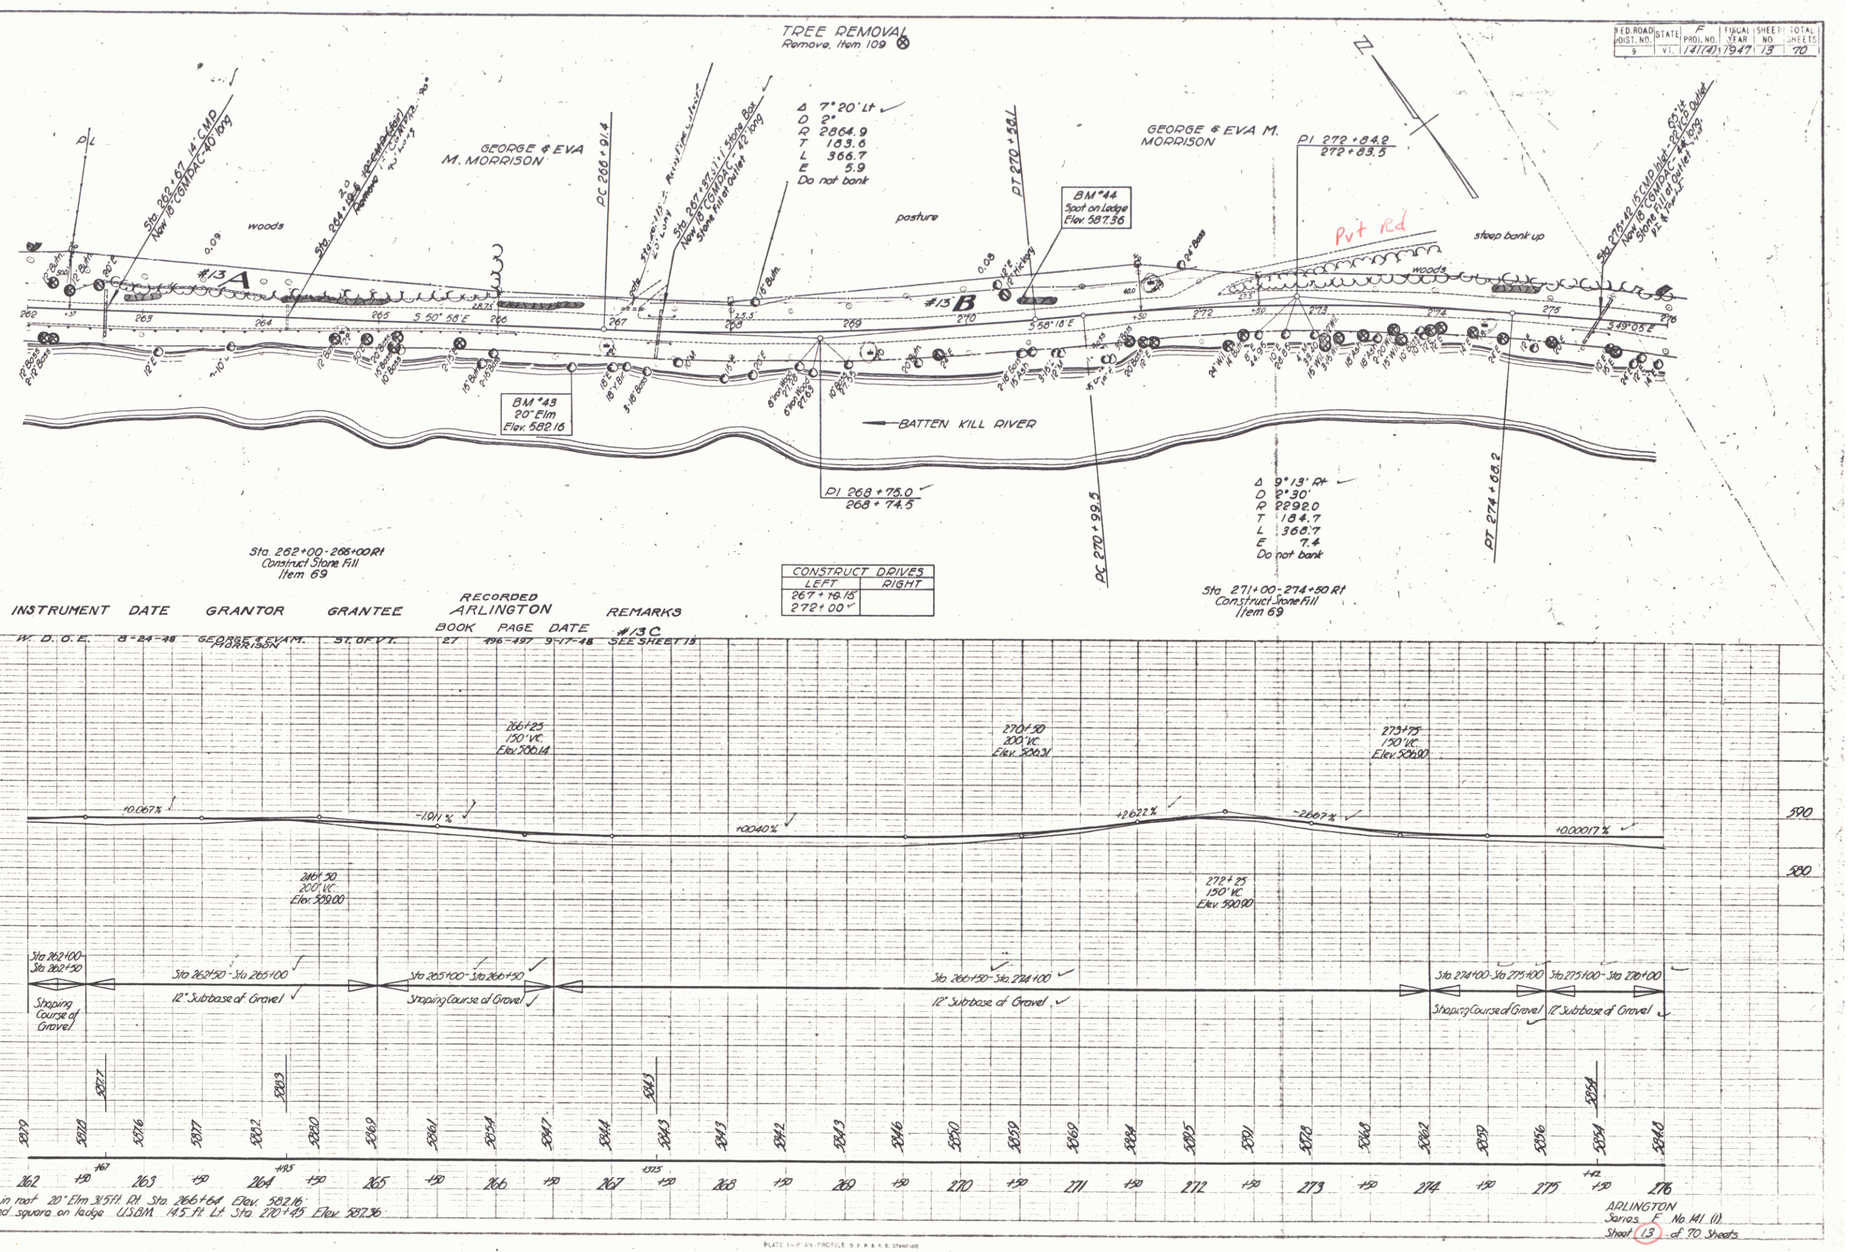

PARCEL	INSTRUMENT	DATE	GRANTOR	GRANTEE	RECORDED ARLINGTON BOOK	PAGE	DATE	REMARKS
#13A & B & C	W. D. O. E.	8-24-48	GEORGE & EVA M. MORRISON	ST. OF VT.	27	496-497	9-17-48	SEE SHEET 13 #13C

PLAN — PLOTTED / TRACED — NOTE BOOK — NO. — ALIGNMENT CHECKED — PROFILE CHECKED — TRACED — J. Lomas — 1-48

PROFILE — PLOTTED / CHECKED — NOTE BOOK — NO. — SPIRALS TIES, STA. ON CURVE — Paper - A. Lawn — Laughlin — 1-48

ARLINGTON
Series F No. 141 (1)
Sheet 13 of 70 Sheets

PLATE 1 - PLAN-PROFILE, S.P.R.R.E. STANDARD
K & E Co. No. 345-1C