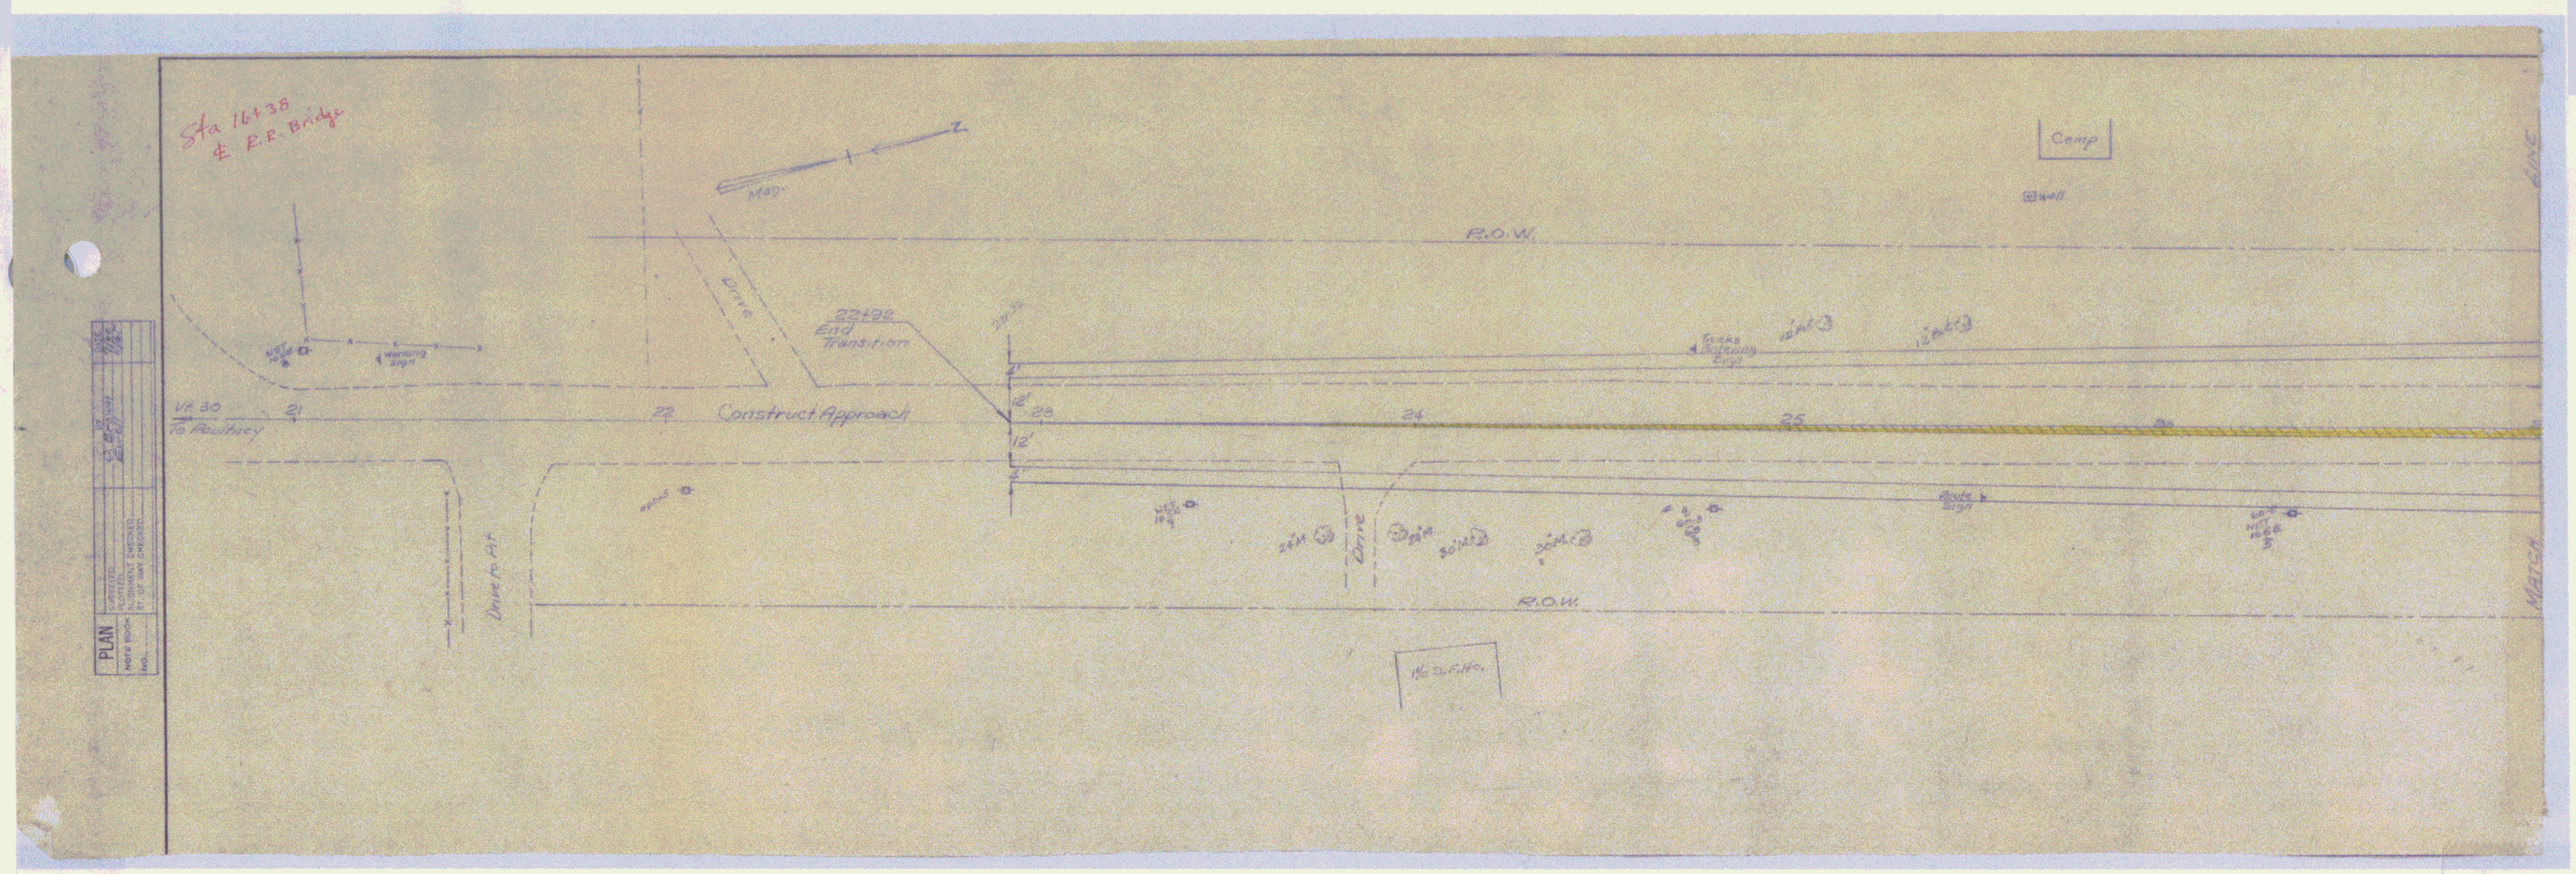
Sta 16+38
℄ R.R. Bridge
Camp
R.O.W.
22+92
End
Transition
Vt. 30
To Poultney
Construct Approach
R.O.W.
MATCH LINE
PLAN

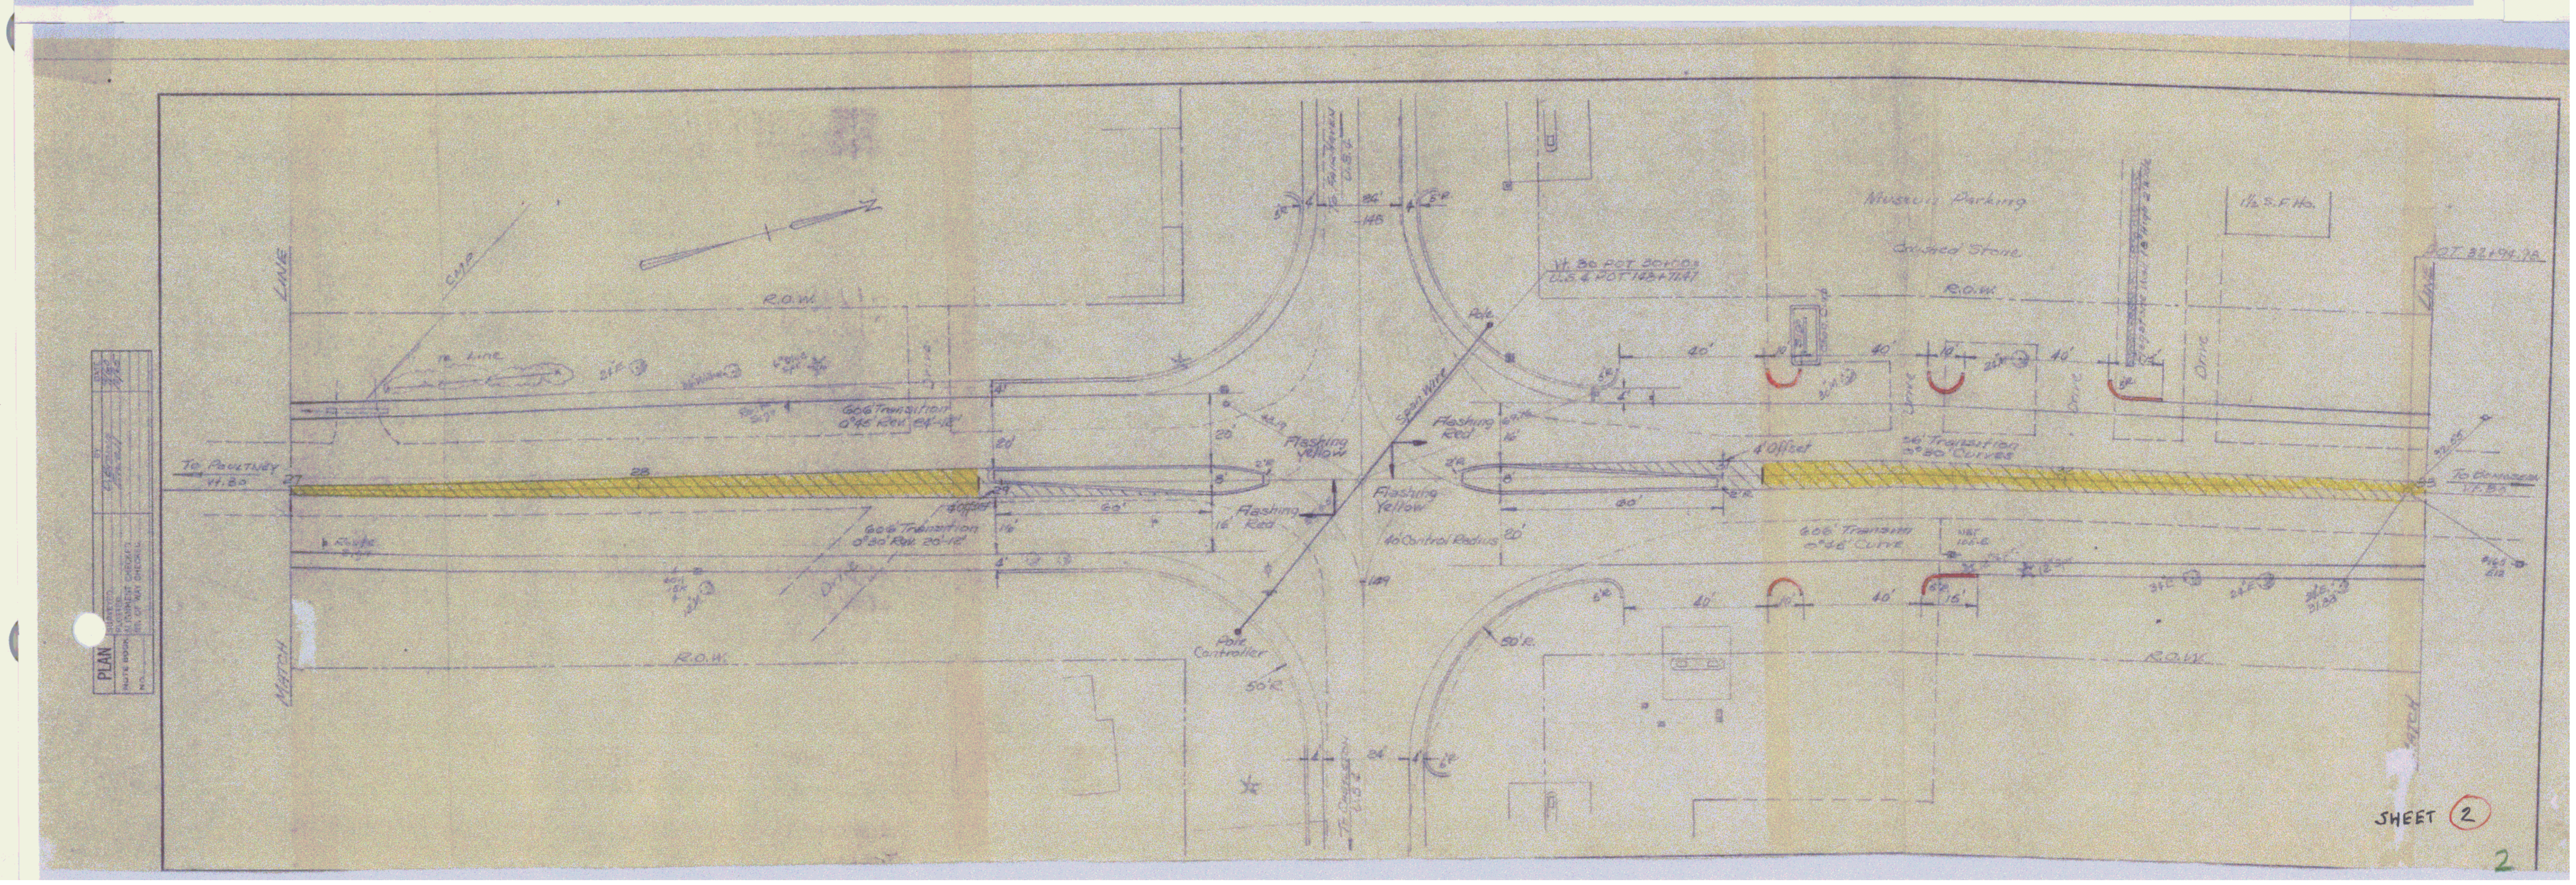
Museum Parking
Crushed Stone
R.O.W.
MATCH LINE
To Poultney
Vt. 30
Flashing Yellow
Flashing Red
Flashing Yellow
Pole Controller
40' Control Radius
To Bomoseen
Vt. 30
R.O.W.
PLAN
SHEET 2

2